

General Disclaimer

One or more of the Following Statements may affect this Document

- This document has been reproduced from the best copy furnished by the organizational source. It is being released in the interest of making available as much information as possible.
- This document may contain data, which exceeds the sheet parameters. It was furnished in this condition by the organizational source and is the best copy available.
- This document may contain tone-on-tone or color graphs, charts and/or pictures, which have been reproduced in black and white.
- This document is paginated as submitted by the original source.
- Portions of this document are not fully legible due to the historical nature of some of the material. However, it is the best reproduction available from the original submission.

DOE/NASA CONTRACTOR REPORT

DOE/NASA CR-150698

PRELIMINARY DESIGN PACKAGE FOR NONCORROSIVE FLUID SUBSYSTEM, SOLAR HEATING AND COOLING


Prepared by

Houston Chemical Company
1 Gateway Center
Pittsburgh, Pennsylvania 15222

Under Contract NAS8-32255 with

National Aeronautics and Space Administration
George C. Marshall Space Flight Center, Alabama 35812

For the U. S. Department of Energy

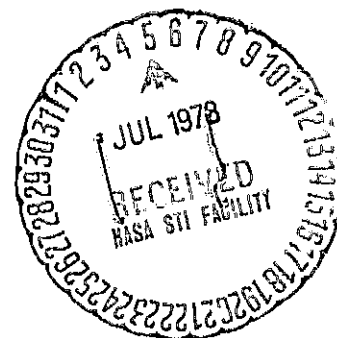

(NASA-CR-150698) PRELIMINARY DESIGN PACKAGE
FOR NONCORROSIVE FLUID SUBSYSTEM, SOLAR
HEATING AND COOLING (Houston Chemical Co.)
24 p HC A02/MF A01 CSCI 10A

N78-25549

Unclas
G3/44 21606

U.S. Department of Energy



Solar Energy

1. REPORT NO. DOE/NASA CR-150698	2. GOVERNMENT ACCESSION NO.	3. RECIPIENT'S CATALOG NO.	
4. TITLE AND SUBTITLE Preliminary Design Package for Noncorrosive Fluid Subsystem, Solar Heating and Cooling		5. REPORT DATE May 1978	
		6. PERFORMING ORGANIZATION CODE	
7. AUTHOR(S)		8. PERFORMING ORGANIZATION REPORT #	
9. PERFORMING ORGANIZATION NAME AND ADDRESS Houston Chemical Company 1 Gateway Center Pittsburgh, Pennsylvania 15222		10. WORK UNIT NO.	
		11. CONTRACT OR GRANT NO. NAS8-32255	
12. SPONSORING AGENCY NAME AND ADDRESS National Aeronautics and Space Administration Washington, D. C. 20546		13. TYPE OF REPORT & PERIOD COVERED Contractor Report	
		14. SPONSORING AGENCY CODE	
15. SUPPLEMENTARY NOTES This work was done under the technical management of Mr. John C. Caudle, George C. Marshall Space Flight Center, Alabama.			
16. ABSTRACT This report contains the information necessary to evaluate the preliminary design for noncorrosive fluids for use in solar heating and cooling systems. Included are drawings for subsystem definition, rationale for special handling, installation and maintenance tools, and an outline for hazard analysis, along with development and testing plans.			
17. KEY WORDS		18. DISTRIBUTION STATEMENT Unclassified-Unlimited <i>William A. Brooksbank</i> WILLIAM A. BROOKSBANK, JR. Mgr, Solar Heating and Cooling Project Office	
19. SECURITY CLASSIF. (of this report) Unclassified	20. SECURITY CLASSIF. (of this page) Unclassified	21. NO. OF PAGES 21	22. PRICE NTIS

TABLE OF CONTENTS

	Page
Section 1 Preliminary Design Review Data	1
Section 2 Development Plan	5
Section 3 Drawings	11
55-A14894-3 Parking lot (solar site drawing)	12
64-A16583-3 Houston Chemical Solar Test Stand general arrangement & details	13
64-A16584-1 Houston Chemical Solar Test Stand cross sectional evaluation	14
64-A16897 Houston Chemical Solar Test Stand cross sectional evaluation-piping	15
SK-64-A16875 Houston Chemical Solar Test Stand plumbing schematic	16
SK-64-A16898 Houston Chemical Solar Test Stand pump, expansion tank, and heat exchanger piping details	17
SK-64-A16886 Houston Chemical Solar Test Stand expansion tank details	18

INTRODUCTION

Houston Chemical, under NASA/MSFC Contract NAS8-32255, is tasked with the development of noncorrosive transport fluids. The fluids shall be compatible with closed looped solar heating, combined heating or hot water systems, compatible with both metallic and non-metallic plumbing systems, and any combination of them.

Some renumbering of pages and slight modifications have been done in the interest of clarity only.

SECTION 1

PRELIMINARY DESIGN REVIEW DATA

PRELIMINARY DESIGN REVIEW DATA

The following documentation is being submitted to the Marshall Space Flight Center two weeks prior to the review in compliance of NASA Contract NAS 8-32255 Appendix B, "Management System," under paragraph 4.1 "Preliminary Design Review."

4.1.3 a. Drawing list required for subsystem definition.

Since the contract covers the evaluation of solar heat transport fluids there are no drawings of the subsystem. However, following is a list of reports which will be prepared and submitted:

"Selection of Solar Heat Transport Fluids Through a Screening Process"

"The Determination of Metals Intrained in Solar Heat Transport Fluids"

"Corrosion Evaluation in Solar Collector Panels"

"Parameters for Solar Heat Transport Fluids"

b. Description and rationale for proposed special handling, installation, and maintenance tools.

Handling - All solutions must be premixed to insure proper solution concentration.

Installation - typical of liquid filled systems.

Maintenance tools - No special maintenance tools are recommended but as program develops tools or instruments may be recommended such as concentration determination, pH, etc.

c. Hazards analysis (505-18, Appendix A)

The subsystems hazard analyses shall identify any extreme conditions or potential hazard sources such as voltage, pressure, flammability, toxicity, etc. in the subsystems. It shall include the following:

ORIGINAL PAGE IS
OF POOR QUALITY

Preliminary Design Review Data

1. Identification of all hazards to personnel, equipment and structures and action taken to eliminate or control these. Identify the source of the hazard and level (major or minor).
2. Residual hazards and rationale for acceptance.
3. Hardware failure modes at the component level that contribute to occurrence of the hazard.

Minimal hazards are associated with the heat transport fluids used in these tests.

Flash points of the H.T.F. in their concentrated form are above 250°F. Flash points of the solutions are not measurable. Vapor pressures are less than 0.1 mm Hg at 20°C.

Should any of the solutions burn through exposure to open flame or electrical sparks, standard fire extinguishing methods with water, CO₂, or dry chemicals are applicable.

The oral toxicity of the concentrated solutions, when performed on rabbits range from 15.38 g/Kg to 34.6 g/Kg. It should be noted that for ethylene glycol-based materials a single dose oral toxicity is greater to humans than animals. Serious injury or death may result from ingestion of somewhat over two fluid ounces of concentrated ethylene glycol-based materials.

Skin penetration—LD₅₀ dose of the concentrated materials when tested on rabbits is greater than 20 ml/Kg. None of the heat transfer materials are active skin irritants.

Standard industrial safety procedures have been proven to be sufficient in the use and handling of these materials.

- d. List of data which the contractor recommends to be used to accomplish the design review.
 - 1) Data which pertains to how the evaluation was conducted:

Preliminary Design Review Data

Flow - To be measured in each system

Temperature - To be measured at the following points:

Collector inlet
Collector outlet
Heat exchanger inlet
Heat exchanger outlet

- 2) Data which pertains to the solar heat transport fluid:

Wet Chemistry
Appearance
Ash content
Foaming
pH
Reserve Alkalinity
Viscosity

- 3) Data which pertains to corrosion of the solar system:

Determining if metals are in solution in the solar heat transport fluid by instrumental analysis

Surface inspection by appearance

Weight - possibly measuring sections before and after test

Photography - to record corrosion

- e. Proposed government furnished instrumentation delivery dates.

No government instrumentation is being used.

- f. All Type 1 and 2 documents to be approved at the review

* Type 1 and 2 documents do not apply to this contract.

* This statement is incorrect and was resolved at the Design Review.

SECTION 2

DEVELOPMENT PLAN

DEVELOPMENT PLAN
HOUSTON CHEMICAL COMPANY

1. Test Stand

We propose to construct a test stand platform in accordance with standard building practices, to accommodate sufficient collector panels to further the project.

We propose sixty-four (64) panels, arranged to test the sub-system.

This would provide separate systems for running tests coincidentally.

We feel this would be an adequate minimum.

Details of the Test Stand

One-inch asphalt slab

Services to enter the building below grade

South elevation, 2' above grade

North elevation, 15' above grade

Roof, 30' x 74' at +25° above horizontal (to nearly match the site's latitude)

2. Coincidental to the construction of the test stand would be activities toward setting up tests, candidate formulae, methods of data recovery, recording, evaluating, scheduling, reporting techniques, etc. for use when the plant starts generating useful and meaningful data. These are routines we have long followed, but we recognize that some variations and modifications and new aspects will come from NASA's requirements to monitor the program and progress effectively.
3. The test stand will be inspected daily for proper operation of the system and the instrumentation, and for maintaining liquid tight integrity.
4. Weekly, from automatic records significant to test needs, temperature data will be recovered.

5. Each test candidate fluid will be sampled periodically and evaluated for deterioration and general performance.

5.1 Monthly sampling of the fluids - wet chemistry

5.2 Bi-monthly instrumental analysis via atomic absorption method

Tests will include:

Wet Chemistry

Appearance*
Ash Content**
Foaming**
pH*
Reserve Alkalinity*
Viscosity**

Instrumental Analysis

Atomic Absorption
Spectrophotometric
X-ray, if necessary

* Monthly tests

** Used if panel fails or at end of test,
whichever occurs first.

6. Open collector panel internal passages for examination and evaluation, and schedule it only when we experience failure or complete a panel test. This technique will also be followed when a high pick-up of metal (collector composition) has been noted by instrumental analysis data.

As the test proceeds and as we build up test stand running time, we will correlate data from all points of recovery.

It should be noted that once the tests have been run, and the test stand is still viable, further work, if indicated or required, could be extended with a new contract and without the initial start-up and construction costs.

7. Complete records of data, work, etc. as required by NASA will be diligently handled.

ORIGINAL PAGE IS
OF POOR QUALITY

8. Reports NASA will require will be handled expeditiously and will reflect the demands imposed on contractors to best manage the program for the government.

The contractor will consider amending or modifying whatever within this contract is too far afield from standard format.

9. During the first quarter, approximately three months after contract award, a detailed schedule for the remaining work will be determined and a no-cost contract change will be made recognizing the schedule. Work will be completed not later than 26 months after contract award.
10. If necessary, future changes in this development plan, by written agreement between the NSFC technical manager and Houston Chemical project manager can be executed.

PRELIMINARY SCHEDULE

Test Stand

Analysis and Evaluation

- | | |
|--|---|
| 1. Build and equip test stand to readiness. | 1. Devise new test methods; attempt to correlate with current methods, repeatability, etc. |
| 2. Charge banks with base line fluids. | 2. Develop analytical data for base-line fluids. |
| 3. Charge banks with candidate fluids. | 3. Screen for candidate fluids. |
| 4. Recover samples. | 4. Analyze, correlate, evaluate and record data. Modify program to utilize pertinent data gained. |
| 5. Remove panels only if a panel fails and at end of test, whichever occurs first. | 5. Disassemble collector, open it, visually inspect and instrumentally evaluate action of fluid on panel where it interfaces fluid. |

NOTE: Much of the initial work, and part of the continuing activity, will be empirical. Only after the pilot plan begins to turn out meaningful and useful data, can a definitive schedule come forth. This should not present any problems in the time frame

or general progress of the project. When researching into new, if also related fields to our experience, empirical approaches are fairly common to our discipline.

PANEL UTILIZATION

To develop base-line data of fluid performance and its effects on solar collectors.

<u>Bank</u>	<u>Collector Metal*</u>	<u>Fluid on Test</u>
1. (1)	Copper	100% Deionized water
2. (1)	Aluminum	100% Deionized water
3. (1)	Steel	100% Deionized water
4. (1)	Copper	100% Hard water
5. (1)	Aluminum	100% Hard water
6. (1)	Steel	100% Hard water
7. (2)	Copper	50/50% MEG/deionized water
8. (2)	Aluminum	50/50% MEG/deionized water
9. (2)	Steel	50/50% MEG/deionized water
10. (2)	Copper	50/50% PG/deionized water
11. (2)	Aluminum	50/50% PG/deionized water
12. (2)	Steel	50/50% PG/deionized water
13. (1)	Copper	60/40% Glycerine/deionized water
14. (1)	Aluminum	60/40% Glycerine/deionized water
15. (1)	Steel	60/40% Glycerine/deionized water
16. (2)	Copper	MEG (M1)
17. (2)	Aluminum	MEG (M1)
18. (2)	Steel	MEG (M1)
19. (2)	Copper	MEG (M2)
20. (2)	Aluminum	MEG (M2)
21. (2)	Steel	MEG (M2)
22. (2)	Copper	MEG (M3)
23. (2)	Aluminum	MEG (M3)
24. (2)	Steel	MEG (M3)
25. (2)	Copper	MEG (M4)
26. (2)	Aluminum	MEG (M4)
27. (2)	Steel	MEG (M4)
28. (2)	Copper	PG (P1)
29. (2)	Aluminum	PG (P1)
30. (2)	Steel	PG (P1)

ORIGINAL PAGE IS
OF POOR QUALITY

* See page that follows.

31. (2)	Copper	PG (P2)
32. (2)	Aluminum	PG (P2)
33. (2)	Steel	PG (P2)
34. (2)	Copper	TEG (T1)
35. (2)	Aluminum	TEG (T1)
36. (2)	Steel	TEG (T1)
37 (1)	Unassigned**	To be determined later

Numbers in parenthesis (), are collector panels/bank.

MEG = Monoethylene glycol

TEG = Triethylene glycol

PG = Propylene glycol

* All plumbing is copper with 50/50 solder, sweated joints

** Open bank for testing non-metallic collectors if mutually agreed.


NOTE: As any bank develops sufficient significant data with correlation possibilities to balance of test program, that bank will be aborted and terminated. This will provide, after refurbishing terminated banks, new banks for further testing of candidates indicated from feedback data.


Candidates, Inhibitors

Candidates in Bank 16 through 36 will contain inhibitors. A number of these inhibitors will be those as used in top flight coolants. Other inhibitors will be selected based on the requirement of the system in the bank being evaluated. They will be selected from a wide spectrum and basically proved by our in-house experience and recorded knowledge, and by whatever testing, e.g., wet chemistry, etc. to qualify them as likely candidates for test in the panel bank(s).


SECTION 3

DRAWINGS

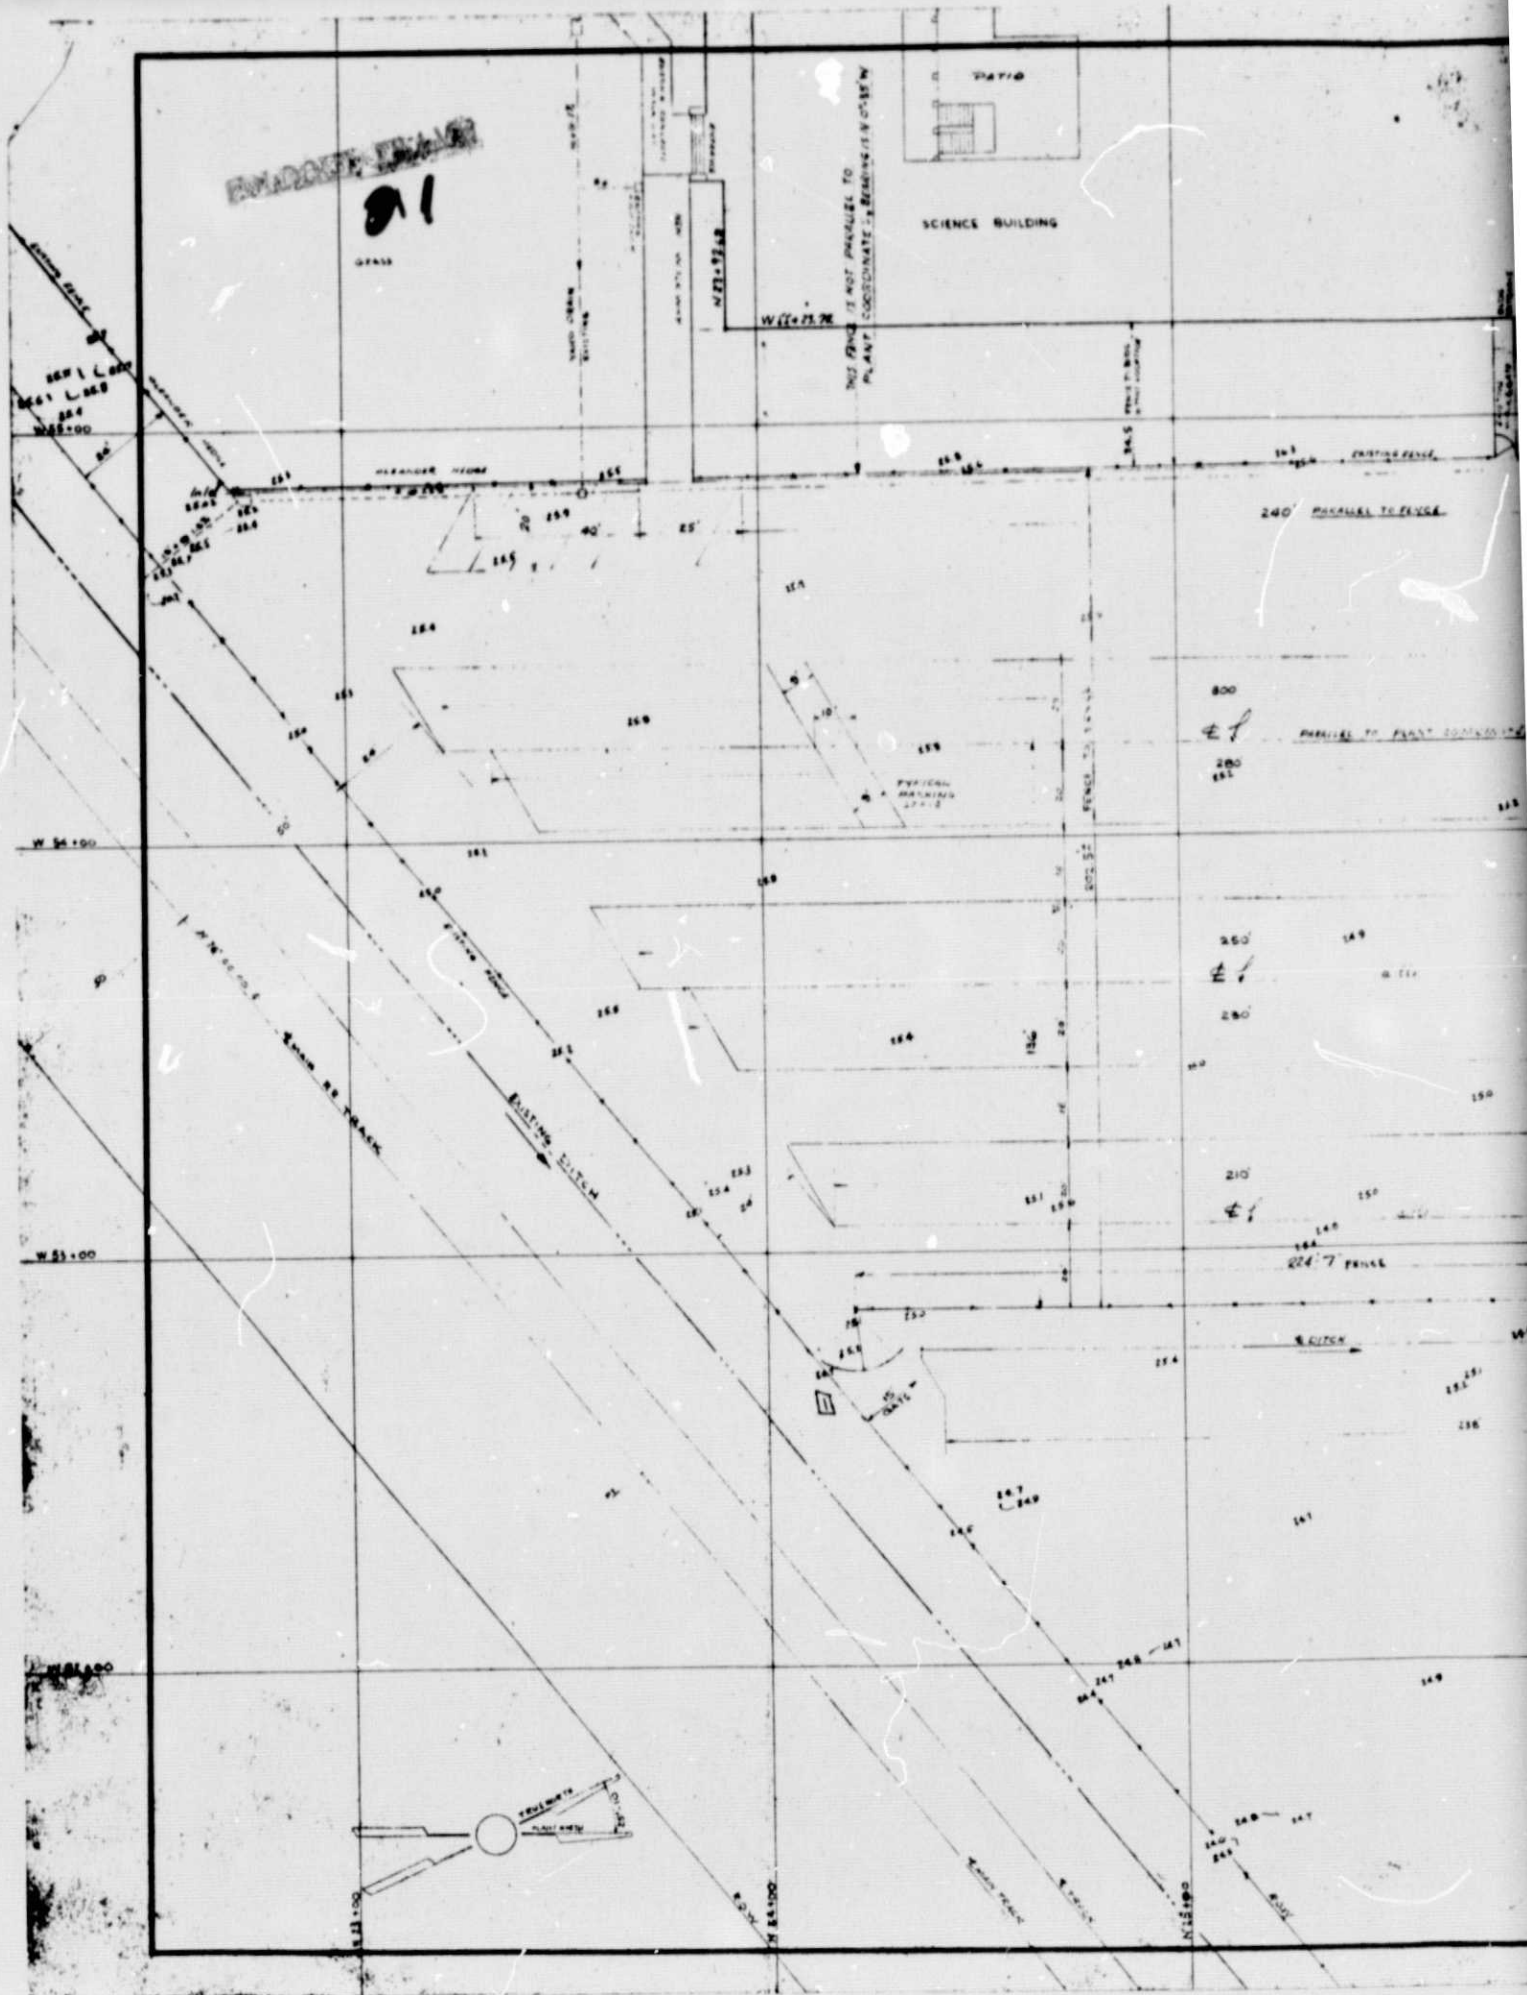

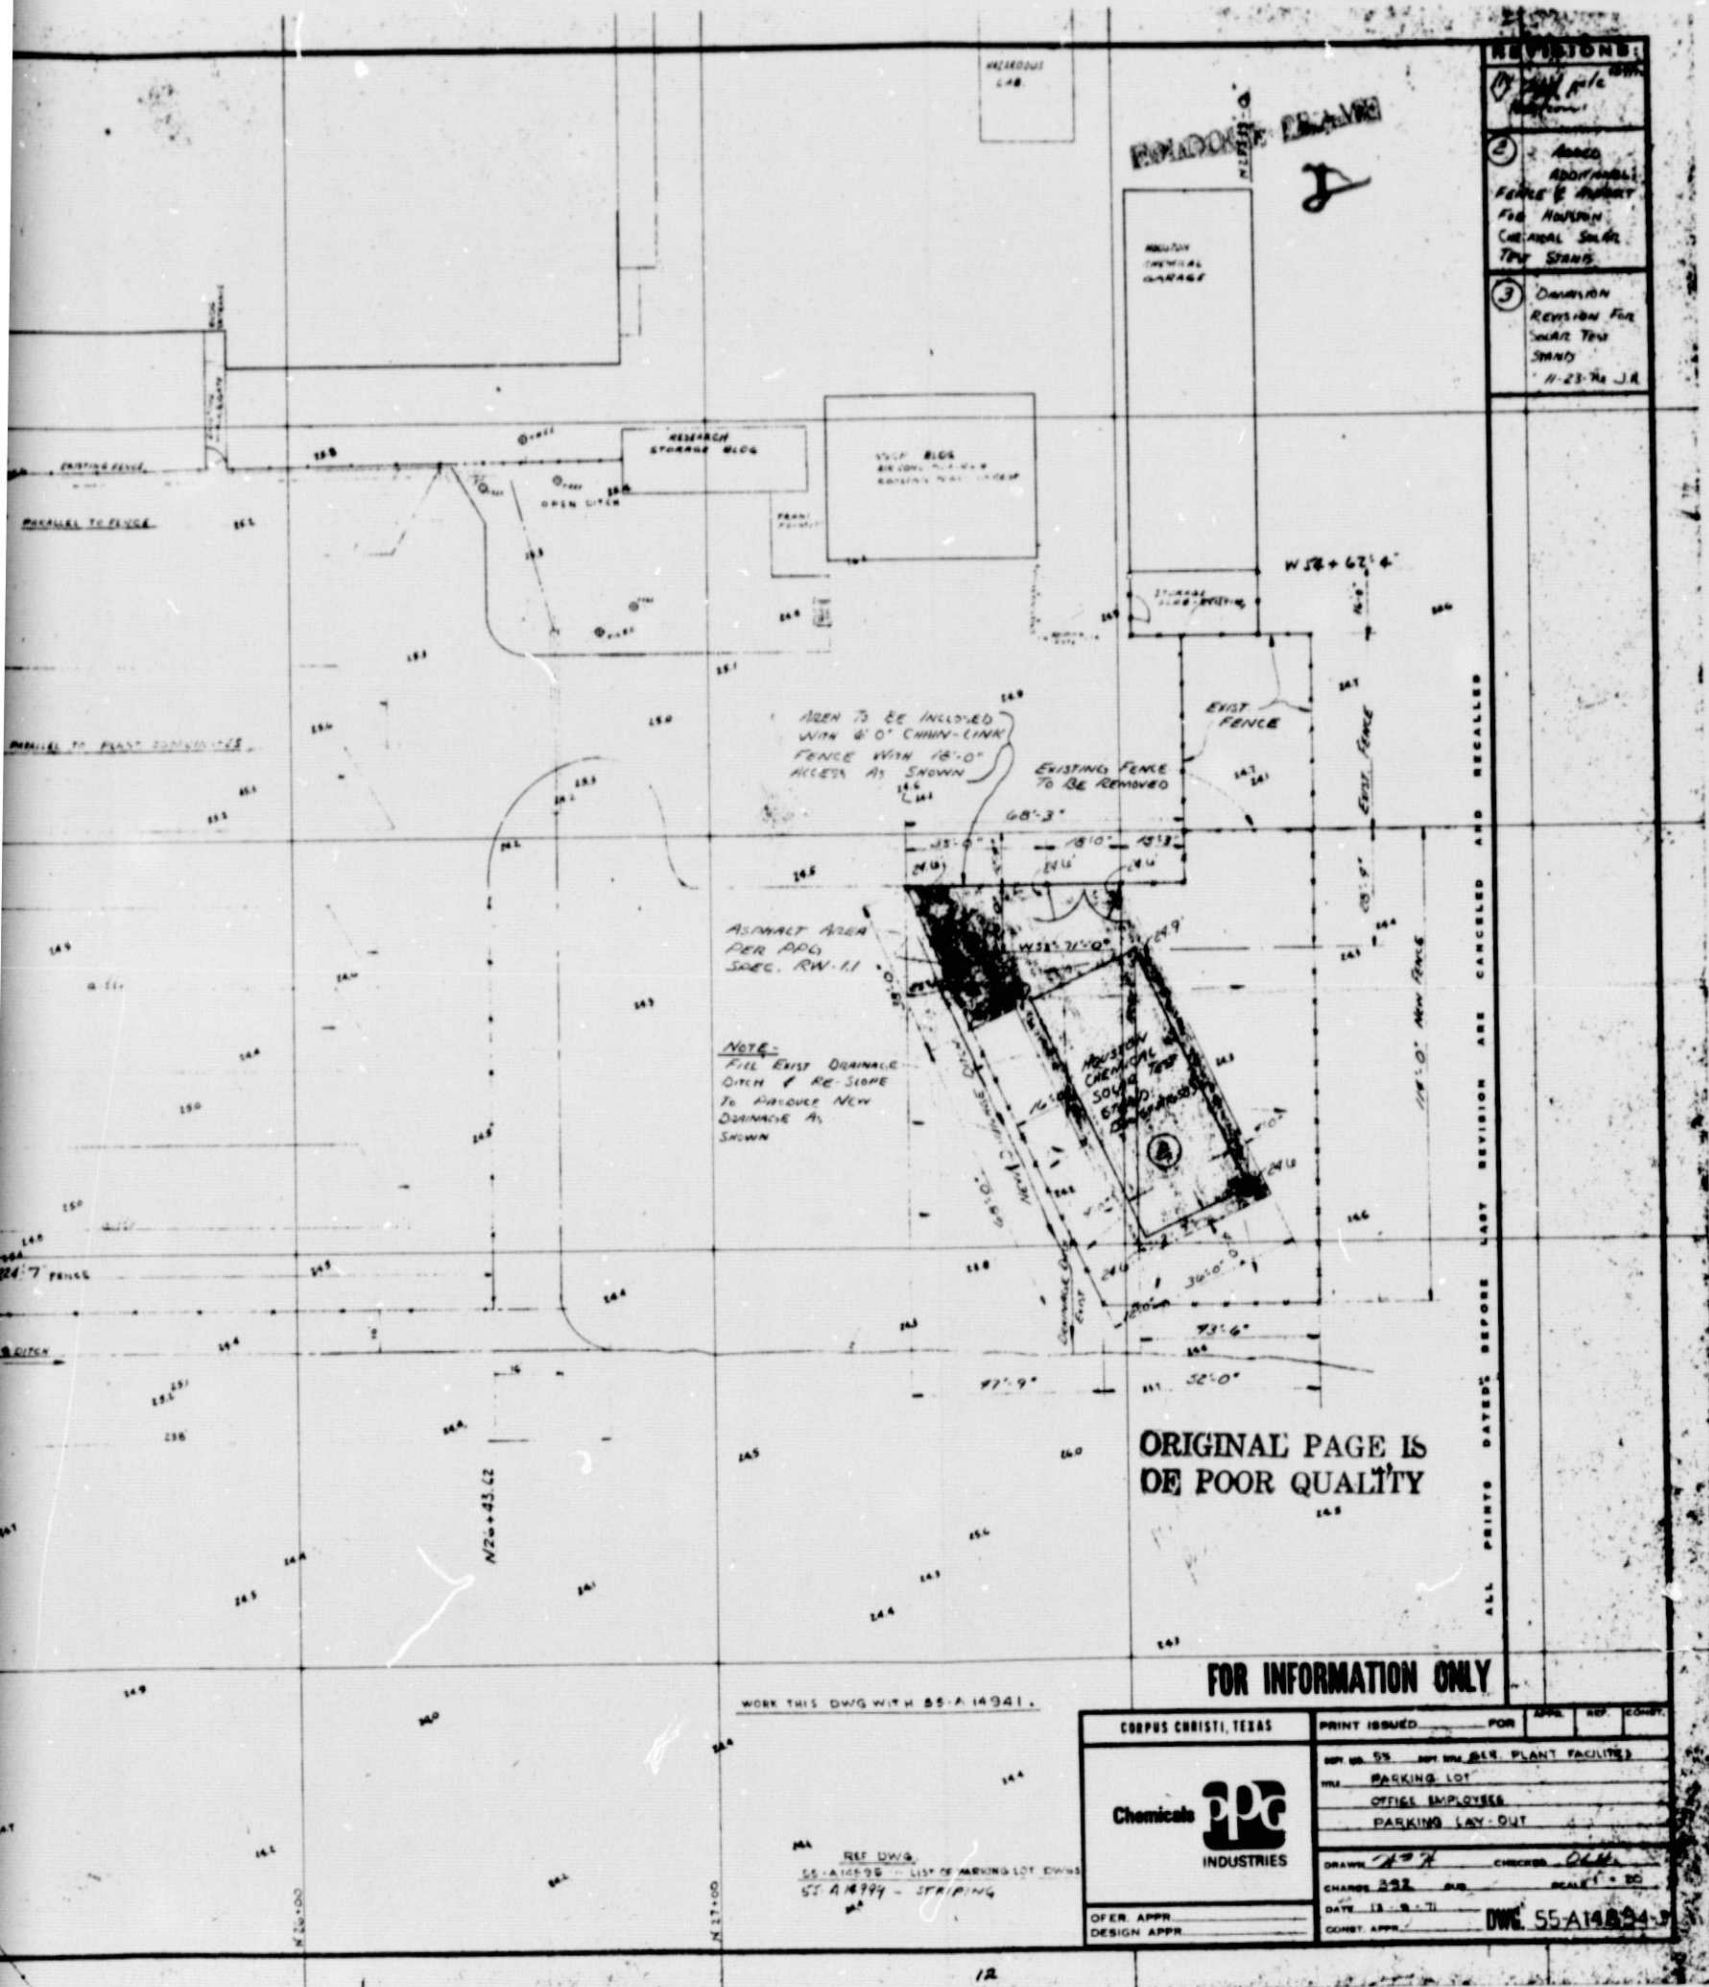


8 BAYS @ 8'0" x 44'0"

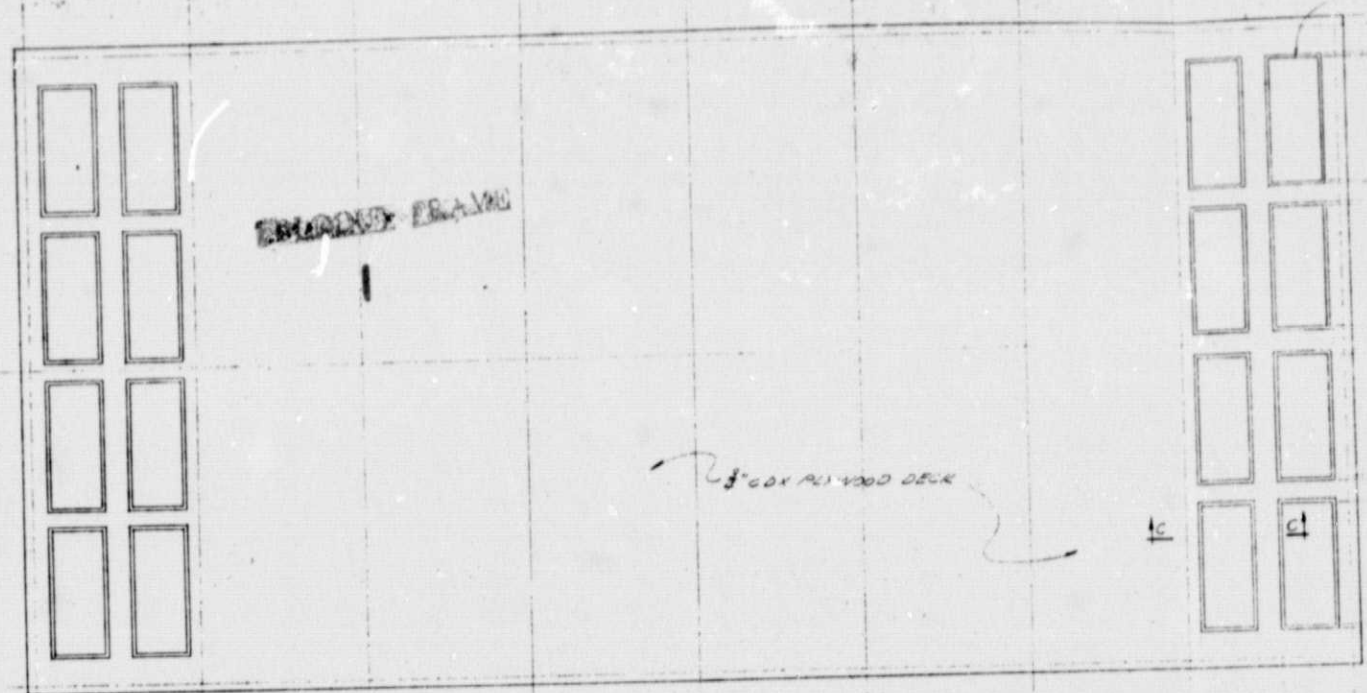


ORIGINAL PAGE IS
OF POOR QUALITY


ROOF PLAN

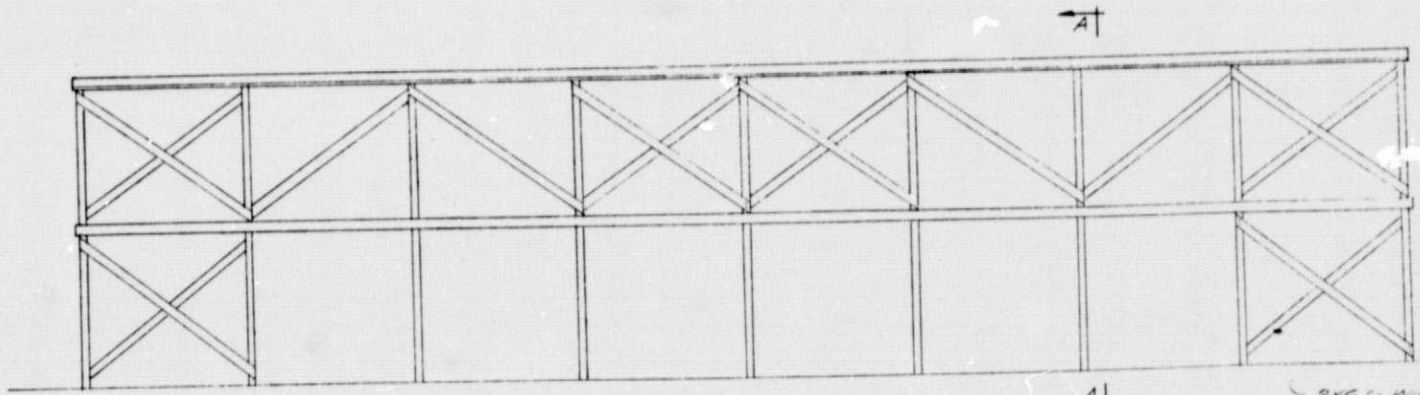

FRONT ELEVATION

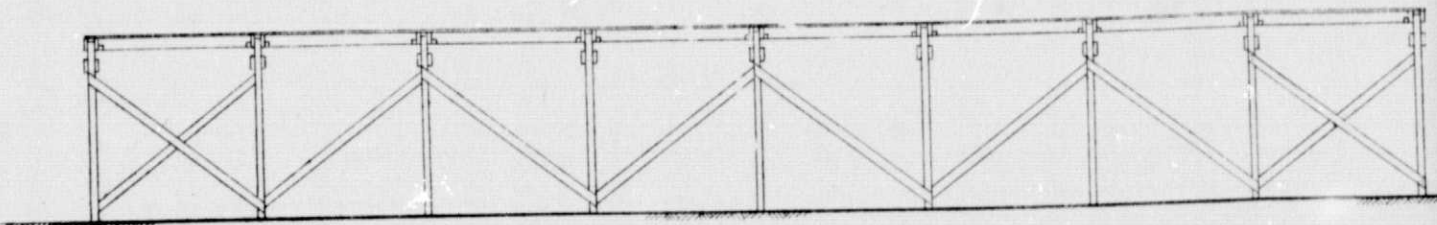

ELEVATION AT SECTION B-B


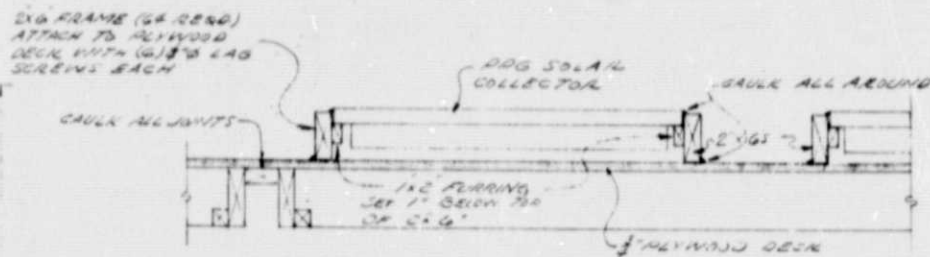


SECTION C-C

~~EXPENSE CLAIM~~

2


- ② NOTE -
FINISH STRUCTURE AS PER ABC SPEC 39-08-0030
PAINT WITH P.V.C. EPOXY FLOOR PAINT -
APPLY IMMEDIATELY AT UC. 4000G & 13" UC. 4000G
(NON-SKID SURFACE - LIGHT GRAY) AS FOLLOWS:
A. APPLY PRIMER COAT
B. AFTER ONE HOUR SPRINKLE ON SAND (DECK AREA ONLY)
C. REMOVE LOOSE SAND AFTER PRIMER IS DRY
D. APPLY FINAL COAT

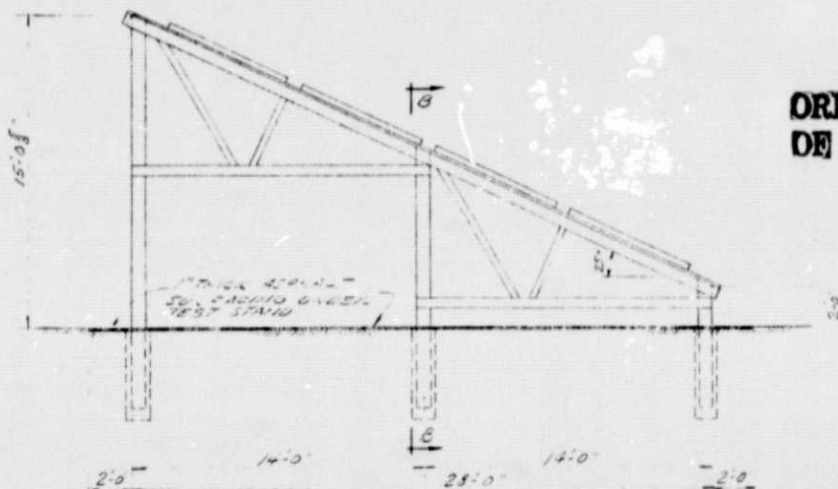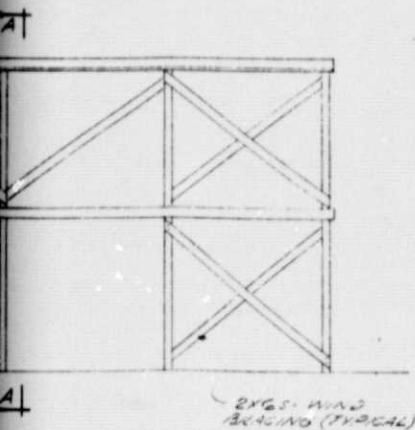

ORIGINAL PAGE IS
OF POOR QUALITY

END ELEVATION

FOR INFORMATION ONLY

CORPUS CHRISTI, TEXAS		PRINT ISSUED		FOR	APPR.	REF.	CONST.
<p>Chemicals</p>  <p>PPG INDUSTRIES</p>		<p>DEPT. NO. <u>64</u> DEPT. TITLE <u>HOUSTON CHEMICAL</u></p> <p>TITLE <u>HOUSTON CHEMICAL SOL. AR</u></p> <p><u>TEST STAND - GENERAL</u></p> <p><u>ARRANGEMENT & DETAILS</u></p>					
OPER. APPR.		DRAWN <u>LINDSEY</u> CHECKED <u>JL</u>					
DESIGN APPR. <u>P</u>		CHARGE <u>RLB</u> SCALE <u>1"=10"</u>					
		DATE <u>7-13-76</u> DWG. <u>64-A16583-3</u>					
		CONST. APPR.					


REF DINGS
62-A18592. HOUSTON CHEM TEST STAND - DETAILS
55-A18994. COGNITION: LAYOUT

Y S

REVISIONS:

- ① ADDED
PAINTING
SPECS
11-22-76
- ② REVISED
PAINT SPEC
TO INCLUDE
NON-SKID
SURFACE
11-23-76
- ③ REVISED
SECTION C-C
TO SHOW C/C
FRAME WITH
1" C PLACING
REVISED QMS
TO SUIT
12-17-76

ROOF PLAN

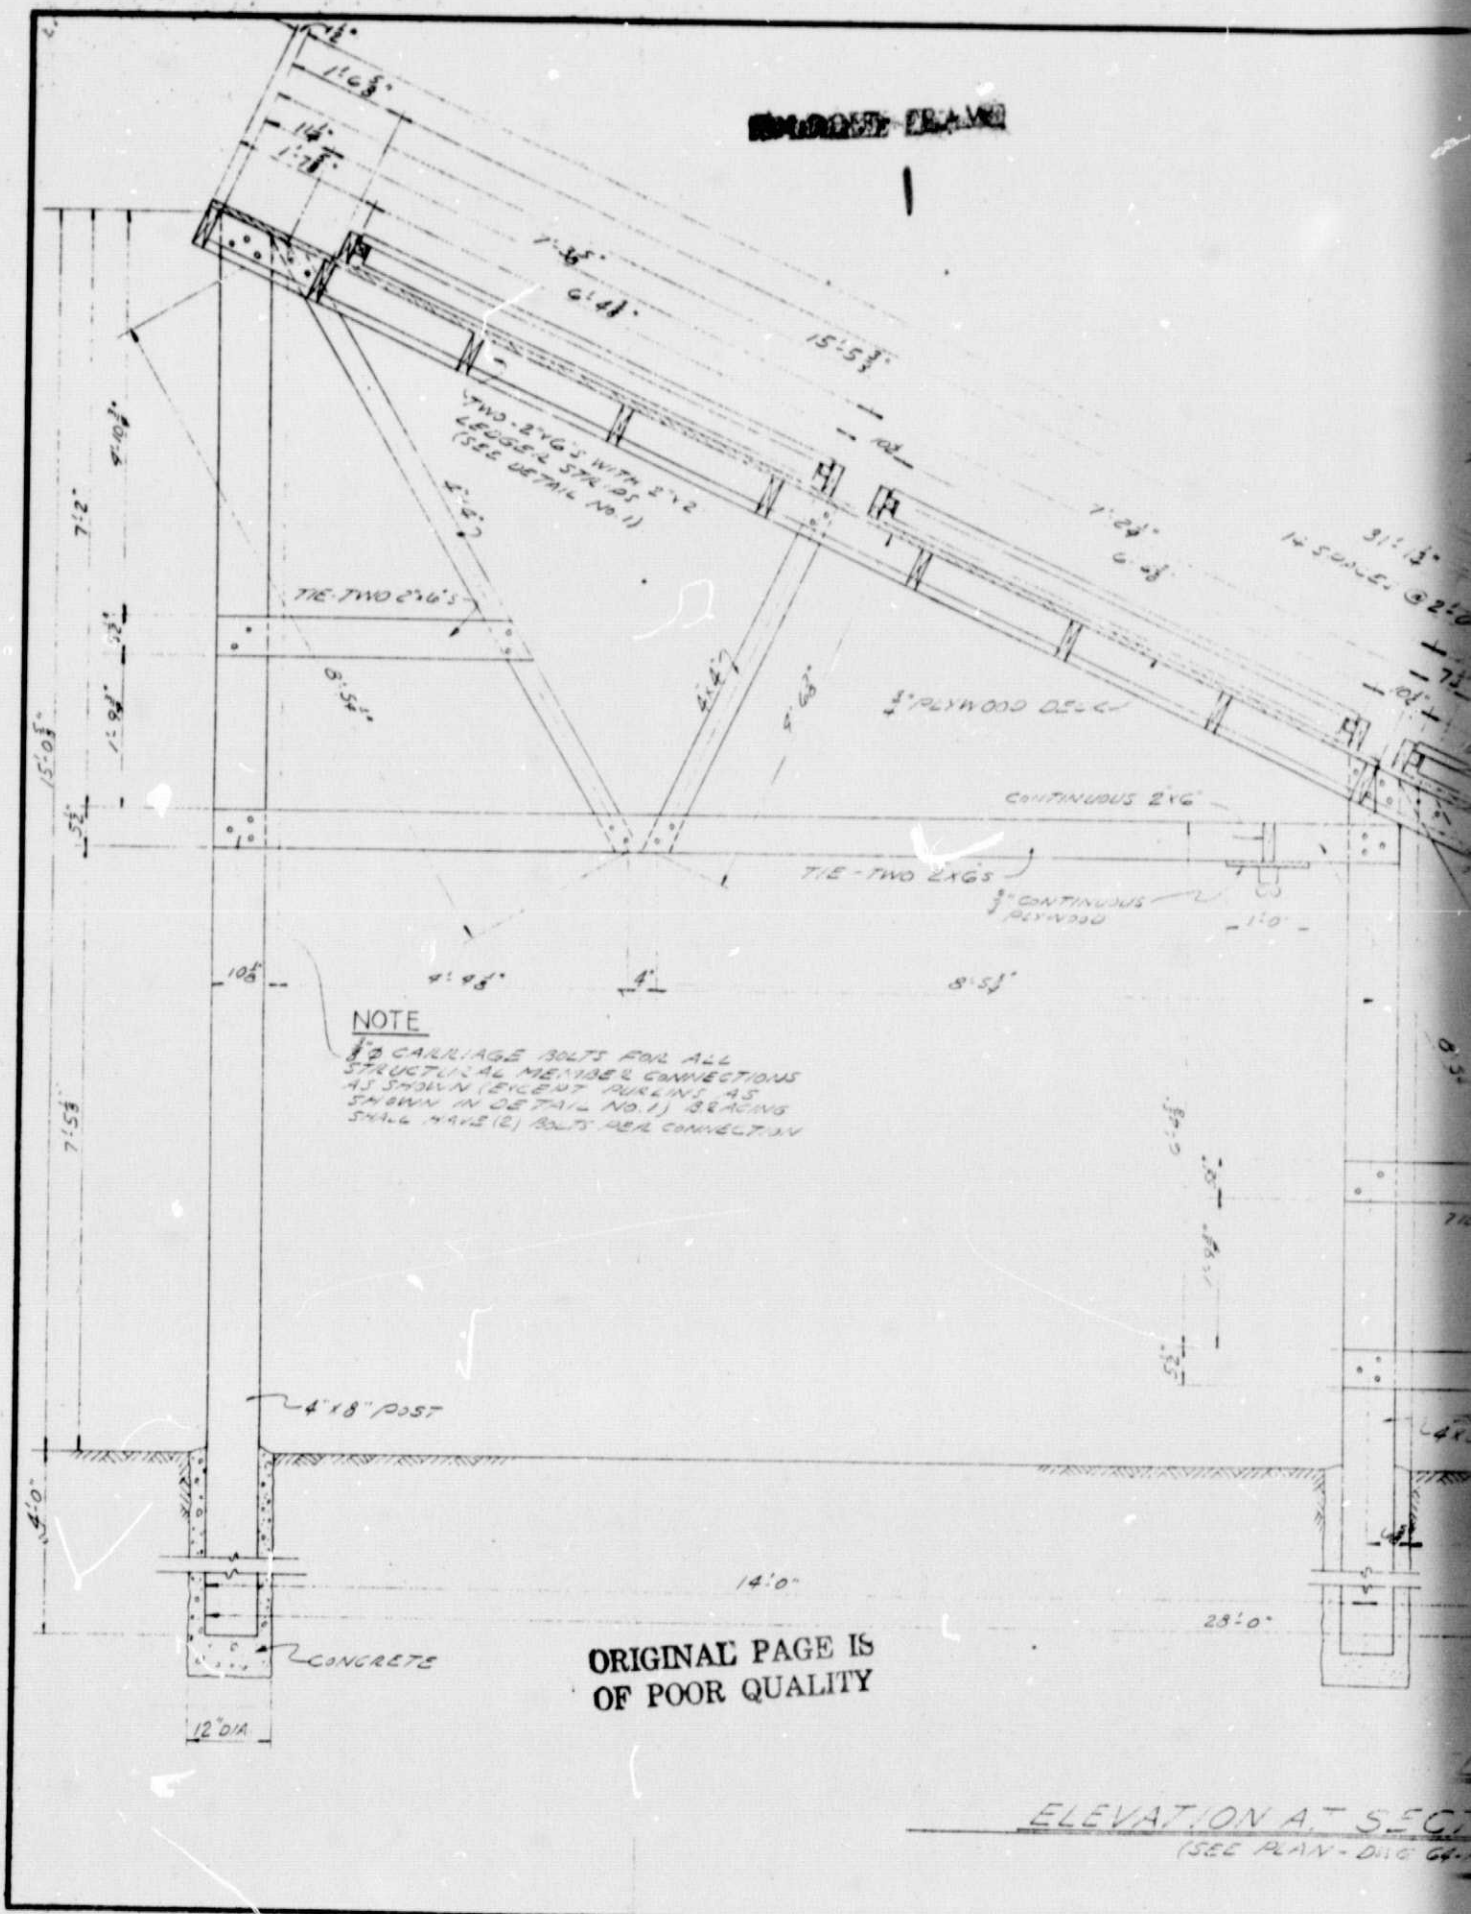

NOTE

1/2" CARRIAGE BOLTS FOR ALL
STRUCTURAL MEMBER CONNECTIONS
AS SHOWN (EXCEPT RACKING BRACING
SHOWN IN DETAIL NO. 1) BRACING
SHALL HAVE 12 BOLTS PER CONNECTION


ORIGINAL PAGE IS
OF POOR QUALITY

ELEVATION A-SECTION
(SEE PLAN-DWG 64)

~~REVISION~~

8

METAL JOINT HANGER
(1/2" MINIMUM GAP)

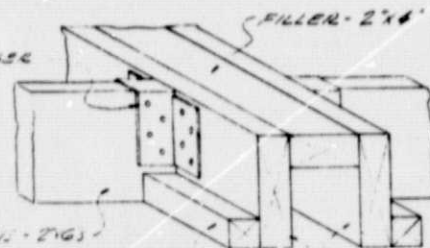


ROOF PURLINE - 2x6

2x2 LEDGER STUD

STRINGERS - 2x6'S

DETAIL NO. 1

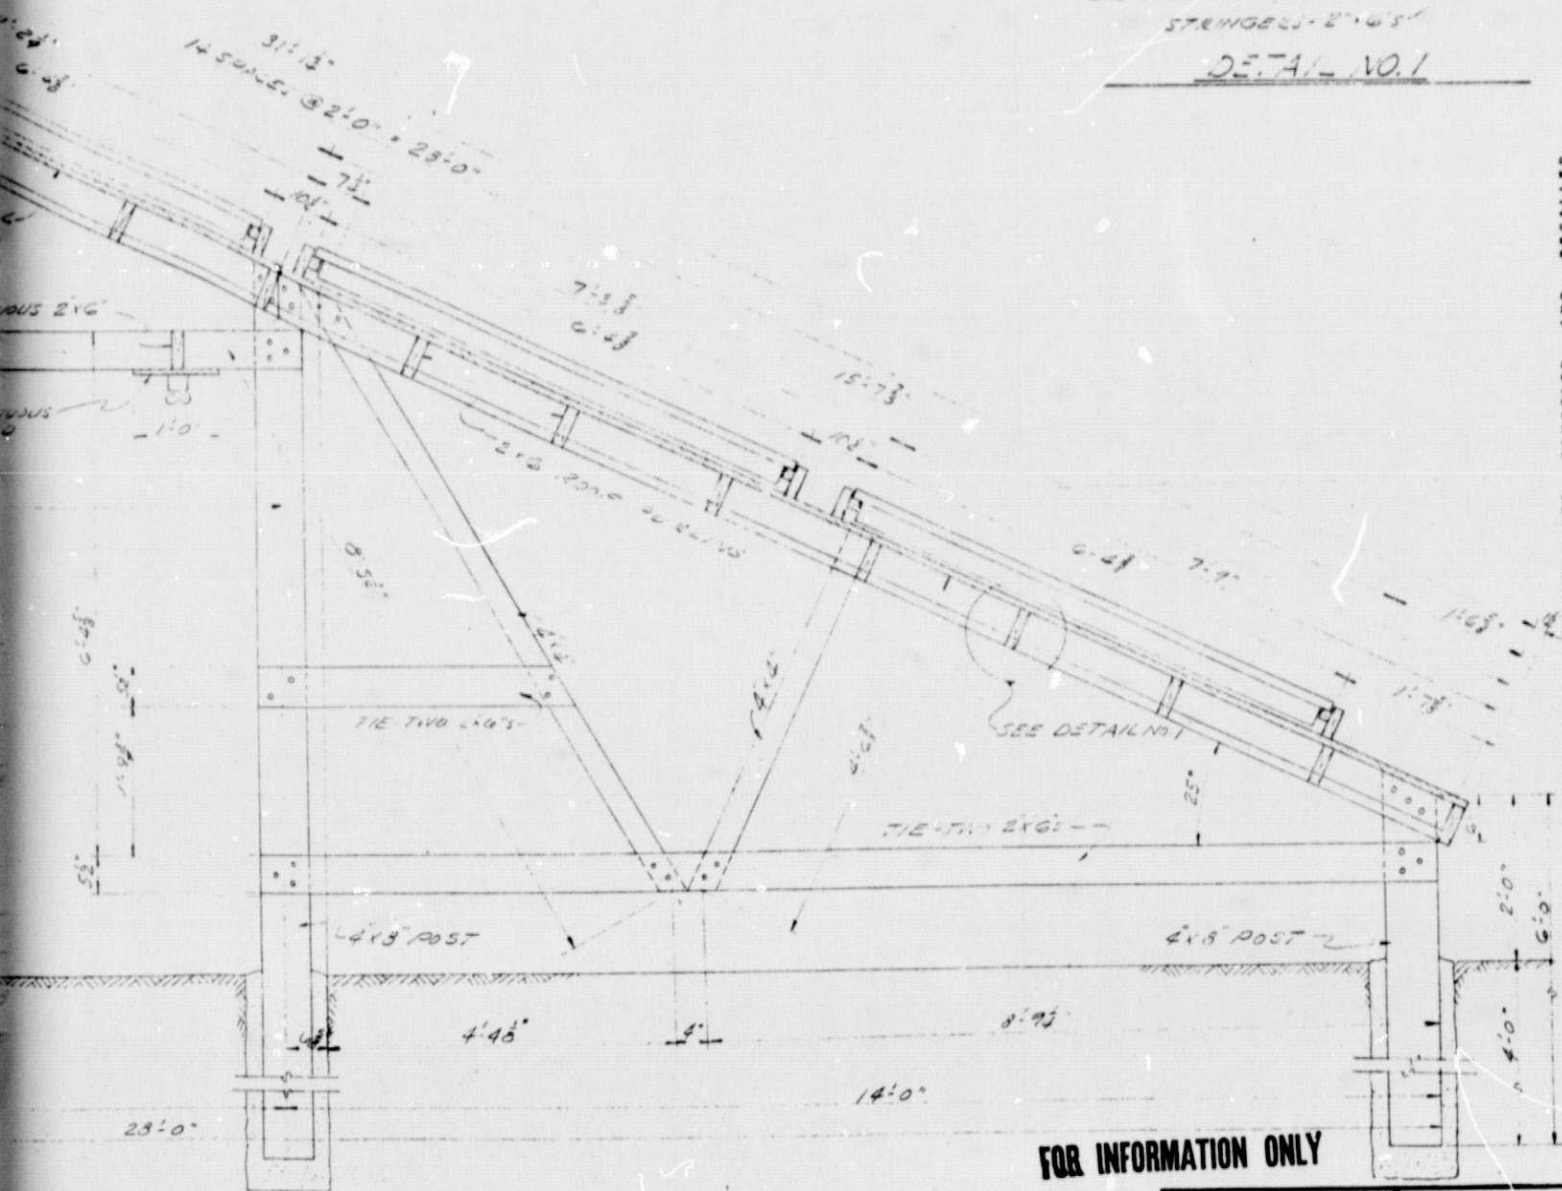

ALL PRINTS DATED BEFORE LAST REVISION ARE CANCELED AND RECALLED


REVISIONS:
 REVISION
 COLLECTOR
 FRANK DIA
 AL DEL BEARIE
 BROWN'S LETTER
 12-7-76
 ALSO ADDED
 RUND & TANK
 SURGEON
 12-20-76


ELEVATION AT SECTION A-A
 (SEE PLAN - DWG 64-A16583)

REF DWGS.
 64-A16583-HOUSTON CHEM TEST STAND-GEN A4RG7

FOR INFORMATION ONLY

CORPUS CHRISTI, TEXAS		PRINT ISSUED		FOR	APPR	DES	CHKD
		DEPT. NO. 64		DEPT. TITLE HOUSTON CHEMICAL			
		TITLE		HOUSTON CHEMICAL			
		SOLAR TEST STAND		CROSS SECTIONAL			
		ELEVATION		ELEVATION			
DRAWN LINDSEY		CHECKED		SCALE 1/4" = 1'-0"			
CHANGE		DATE 7-13-76		DWG 64-A16584-1			
OPER APPR		DESIGN APPR		CONVT. APPR			

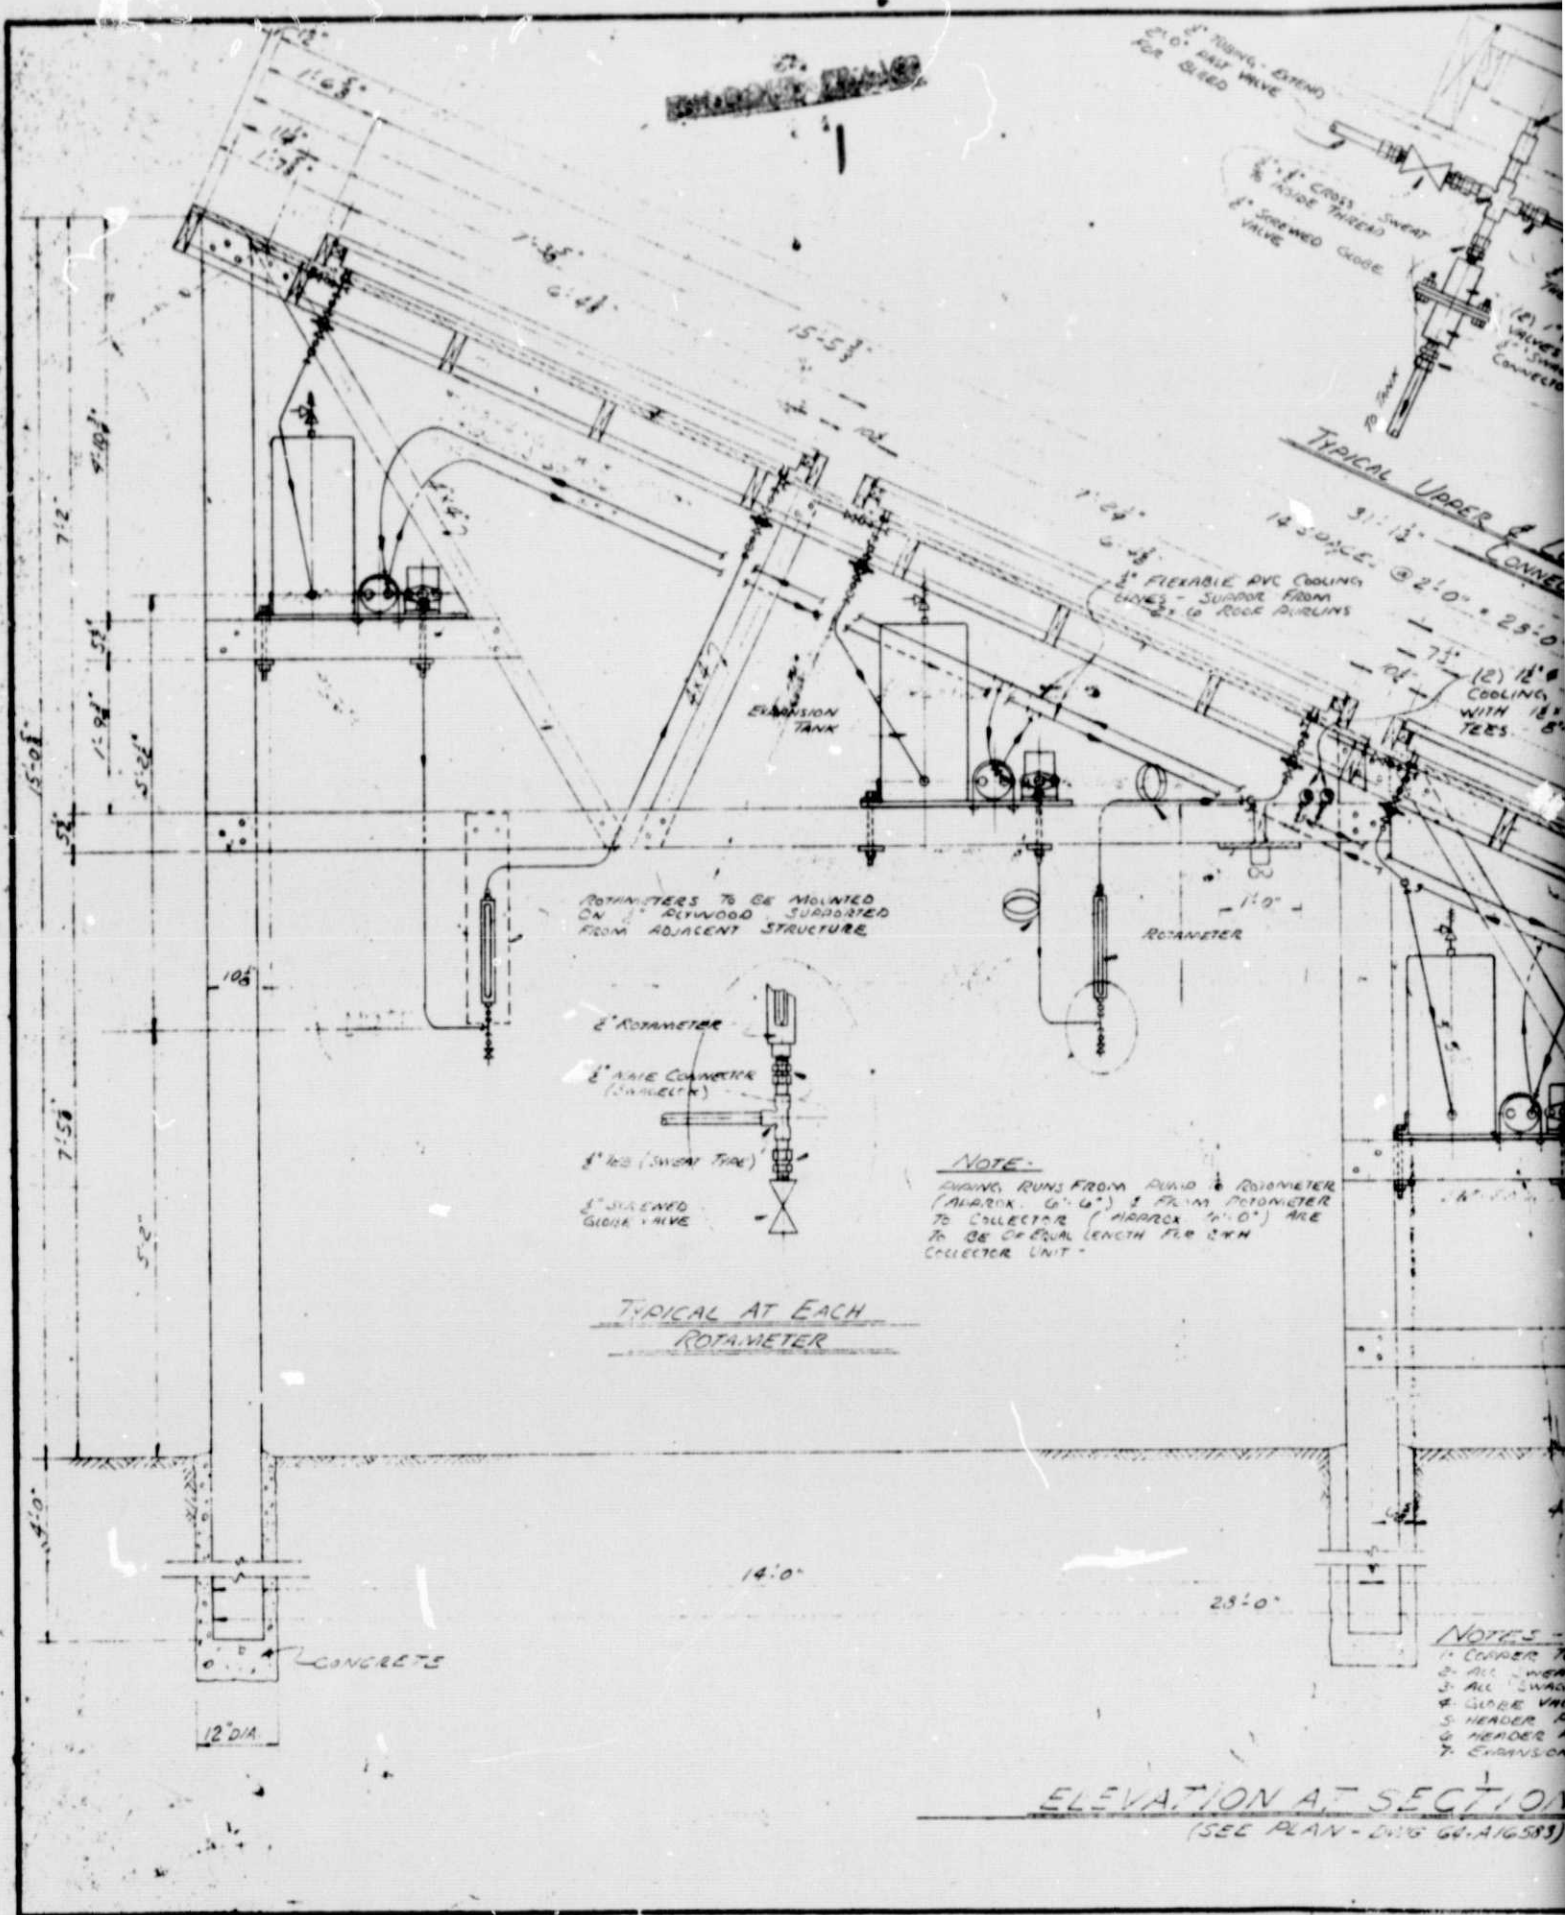

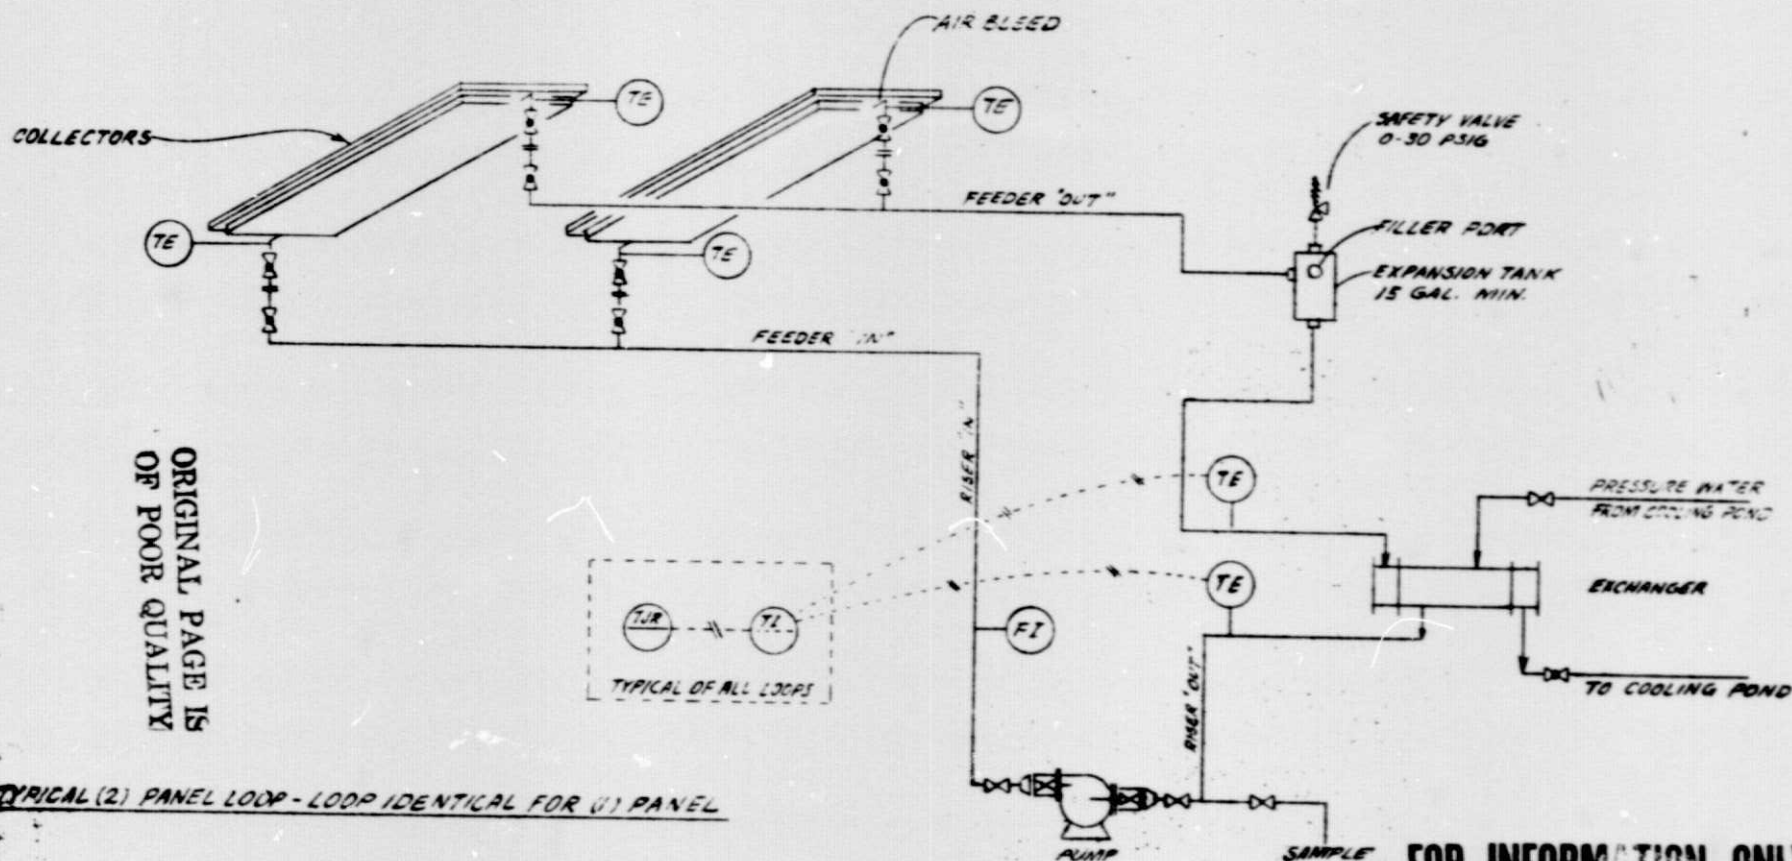



ORIGINAL PAGE IS
OF POOR QUALITY

TYPICAL (2) PANEL LOOP - LOOP IDENTICAL FOR (1) PANEL

FOR INFORMATION ONLY

- ALL PIPING SHOWN TO BE 1/2" RIGID COPPER
- ALL FITTINGS, EXCEPT TEMPERATURE ELEMENTS,
TO BE BRASS TYPE W/50/50 SOLDER.
- 2" x 1/2" TE FOR TEMPERATURE ELEMENT
- TO BE COPPER TO COPPER SWEAT TO INSIDE THREAD

REV.	BY	DATE	DESCRIPTION
1			
DEPT. NO. _____ DESK. NO. _____ HOUSTON CHEMICAL SOLAR TEST STAND - PLUMBING SCHEMATIC			
DESIGNED BY	CHECKED BY	DATE	APPROVED BY
		11-11-78	
DRAWN BY J.M. SCALE: NYS			EYE NO. SK-4-A/6875

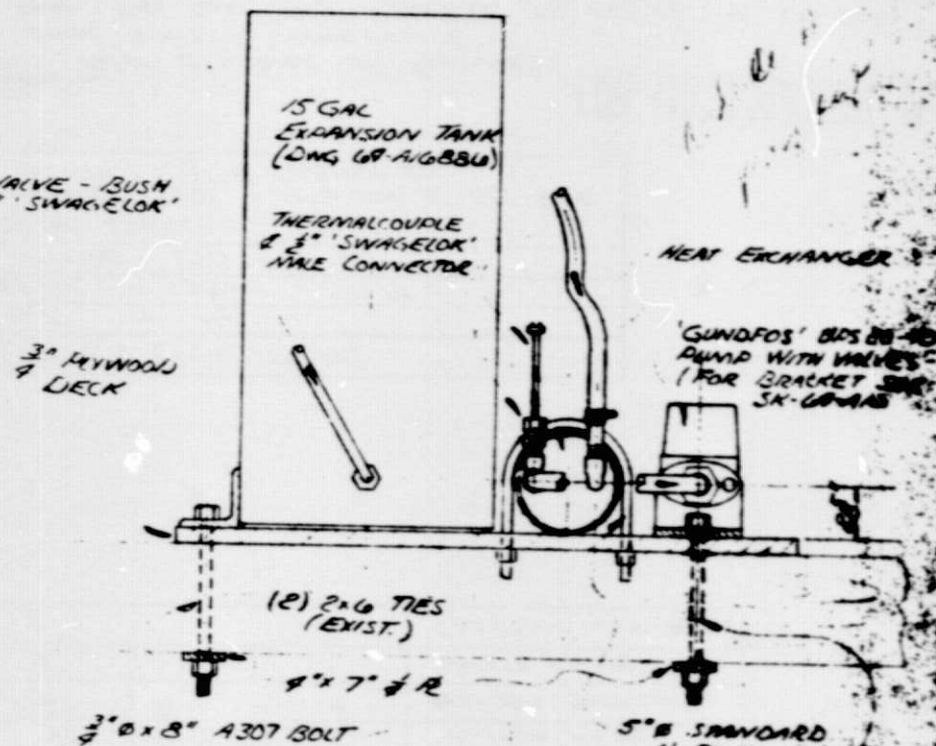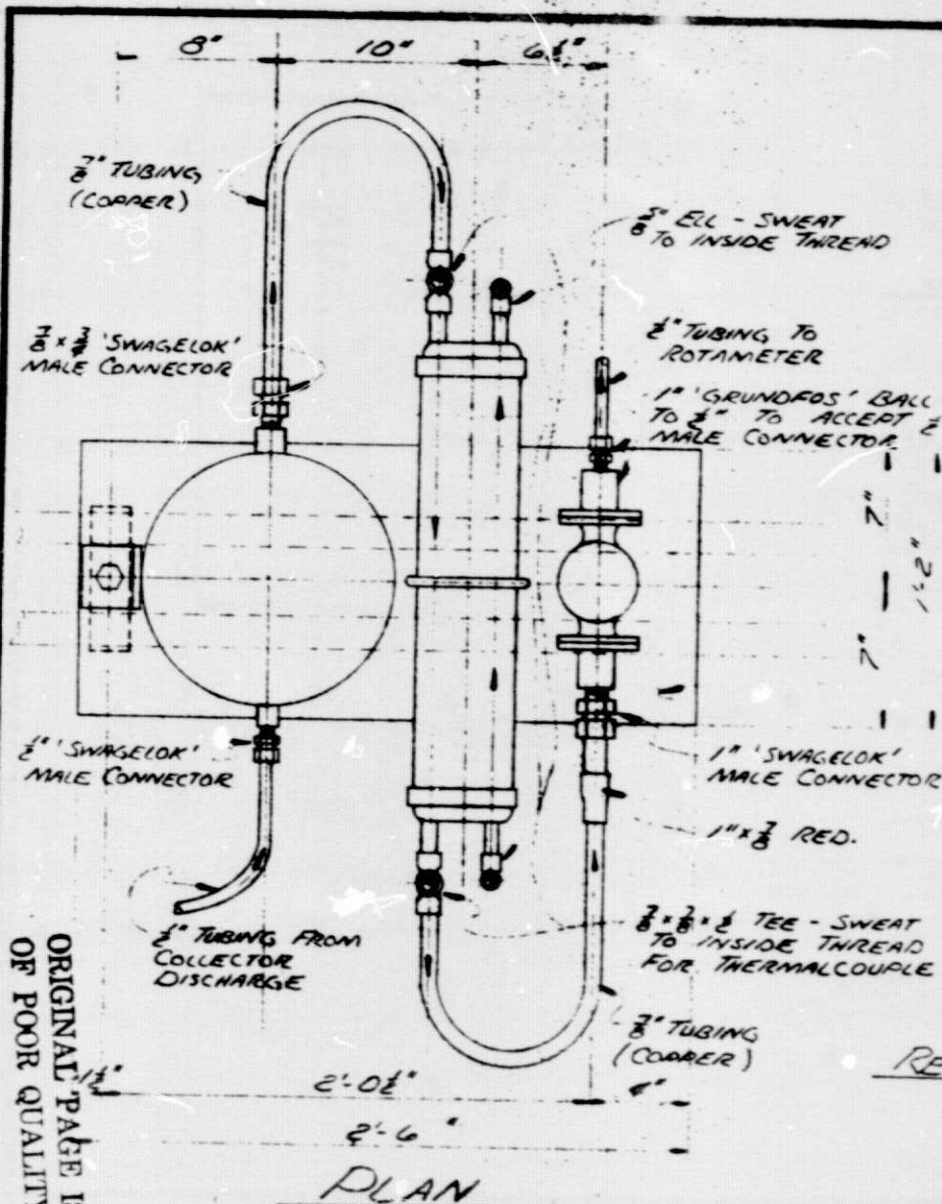

ELEVATION FOR INFORMATION ONLY

REF. DWG. - 69-AUG897 - SPECIFICATIONS & DWG LIST

REV.	BY	DATE	DESCRIPTION
1			
2			
ORIGINAL PAGE IS
OF POOR QUALITY

1818






