

E83-10260
15-26-1019-1575

SEPT 1982

NASA-CC-170525

THEMATIC MAPPER

THEMATIC MAPPER

THEMATIC MA

Made available under NASA sponsorship
in the interest of early and wide dis-
semination of Earth Resources Survey
Program information and without liability
to the user.



(E83-10260) THEMATIC MAPPER FLIGHT MODEL N83-26129
PRESHIPMENT REVIEW DATA PACKAGE, VOLUME 2,
PART C: SUBSYSTEM DATA Final Report (Santa
Barbara Research Center) 199 p Unclas
HC A09/MF A01 CSCL 14B G3/43 00260

THEMATIC MAPPER

Prepared for
GODDARD SPACE FLIGHT CENTER
Greenbelt, Maryland 20771
CONTRACT NAS 5-24200

FLIGHT MODEL
PRESHIPMENT REVIEW
DATA PACKAGE
VOLUME II - SUBSYSTEM DATA
PART C
Article IV - 3A



HUGHES

HUGHES AIRCRAFT COMPANY
SPACE AND COMMUNICATIONS GROUP

BEST AVAILABLE COPY

HS 236-0019-1679



Prepared for
GODDARD SPACE FLIGHT CENTER
Greenbelt, Maryland 20771
CONTRACT NAS 5-24209

SEPT 1982

FLIGHT MODE!
PRESHIPMENT REVIEW
DATA PACKAGE
VOLUME II - SUBSYSTEM DATA
PART C

Article IV - 3A

HUGHES

HUGHES AIRCRAFT COMPANY
SPACE AND COMMUNICATIONS GROUP

Hughes Ref No. J4598 •

ORIGINAL PAGE IS
OF POOR QUALITY

THEMATIC MAPPER
FLIGHT MODEL
PRESHIPMENT REVIEW
VOLUME II
SUBSYSTEMS
TABLE OF CONTENTS

	<u>Section</u>
1.0 INTRODUCTION	1.0
2.0 SUBSYSTEMS ACCEPTANCE DATA	
Multiplexer Assembly	2.1
Multiplexer Summarized Performance	2.1.1
Multiplexer Acceptance Data	2.1.2
Scan Mirror Assembly	2.2
Scan Mirror Summary Performance	2.2.1
Scan Mirror Acceptance Data	2.2.2
Power Supply Assembly	2.3
Power Supply Summarized Performance	2.3.1
Power Supply Acceptance Data	2.3.2
Mainframe/Top Mechanical Assembly	2.4
Mainframe/Top Mechanical Summarized Performance	2.4.1
Mainframe/Top Mechanical Acceptance Data	2.4.2
Aft Optics Assembly	2.5
Aft Optics Summarized Performance	2.5.1
Aft Optics Acceptance Data	2.5.2
Focal Plane Assembly	2.6
Focal Plane Summarized Performance	2.6.1
Focal Plane Acceptance Data	2.6.2
Radiative Cooler	2.7
Radiative Cooler Summarized Performance	2.7.1
Radiative Cooler Acceptance Data	2.7.2

ORIGINAL PAGE IS
OF POOR QUALITY

THEMATIC MAPPER
FLIGHT MODEL
PRE SHIPMENT REVIEW
VOLUME II
SUBSYSTEMS

TABLE OF CONTENTS

(Continued...)

	<u>Section</u>
Radiative Cooler Door Assembly	2.8
Radiative Cooler Door Summarized Performance	2.8.1
Radiative Cooler Door Acceptance Data	2.8.2
Top Optical Assembly	2.9
Top Optical Summarized Performance	2.9.1
Top Optical Acceptance Data	2.9.2
Telescope Assembly	2.10
Telescope Summarized Performance	2.10.1
Telescope Acceptance Data	2.10.2
Relay Optics	2.11
Relay Summarized Performance	2.11.1
Relay Acceptance Data	2.11.2
Electronics Module	2.12
Electronics Summarized Performance	2.12.1
Electronics Acceptance Data	2.12.2
Cable Harness	2.13
Cable Harness Summarized Performance	2.13.1
Cable Harness Acceptance Data	2.13.2

ORIGINAL PAGE IS
OF POOR QUALITY

2.0 Subsystems Acceptance Data

Each of the major subsystems of the Flight Model Thematic Mapper was reviewed as an entity prior to integration into the system. The intent of this section is to present for each major subsystem, acceptance data for the subsystem (test results); reference lists of the configuration status; and reference lists of Non-Conforming Material Reports, Failure Reports (with copies), and Requests for Deviation/Waiver (with copies).

The acceptance data for each subsystem (where applicable) is contained in the Appendix to this report, as referenced in the first subsection for each subsystem.

The second subsection for each subsystem contains a tabular summary of the "as designed" and "as built" configuration lists, showing all applicable drawings, specifications, or standards. (An "as built" configuration list for the total system is included in Volume I and is also included herein immediately following this page). This is followed by a listing of all items against the subsystem, with copies of NCRM's, RT's, and RD/W's.

SUMMARY
AS-BUILT CONFIGURATION LIST
TM FLIGHT S/N 003

TRD LVL	PART NO.	NOMENCLATURE	CURRENT REVISION	ACCEPT. REVISION	AS-BUILT REVISION	SERIAL NUMBER
1	51065	THEMATIC MAPPER ASSY	J	J	J	003
			4257A	4257A	4257A	
			4487A	4487A	4487A	
			4557A	4557A	4557A	
			4573A	4573A	4573A	
			4643A	4643A	4643A	
			4658A	4658A	4658A	
			D143R1	D143R1	D143R1	
			D144	D144	D144	
			D146	D146	D146	
			D148	D148	D148	
			D155	D155	D155	
			D158	D158	D158	
			D161	D161	D161	
			D162	D162	D162	
			D163	D163	D163	
			D164	D164	D164	
			D165	D165	D165	
			W166	W166	W166	
			W169	W169	W169	
			W170	W170	W170	
			W171R1	W171R1	W171R1	
			W173	W173	W173	
2	50840	MAIN FRAME ASSY	E	E	E	003
2	52347	ELECTRONICS MODULE ASSY	D	B	B	201
			4588A	4091A	4091A	
				4113A	4113A	
				4242A	4242A	
				4293A	4293A	

ORIGINAL PAGE IS
OF POOR QUALITY

TND LVL	PART NO.	NOMENCLATURE	CURRENT REVISION	ACCEP. REVISION	AS-BUILT REVISION	SERIAL NUMB
3	3533003-100	MULTIPLEXER ASSY	C 43009 43074 65661 65662 W124 W125	C 43074 65661 65662 W124 W125	C 43009 43074 65661 65662 W124 W125	003
3	50869	POWER SUPPLY ASSY	D 2015A 2039A 4347A D030 D068 W074 W092 W093 W101	D 2015A 2039A 4347A D030 D068 W074 W092 W093 W101	D 2015A 2039A 4347A D030 D068 W074 W092 W093 W101	004
3	52348	CABLE ROUTING ASSY	F 3844A	F 3844A	F 3844A	005
2	52532	OPTICAL ASSY	F 3174A 4100A 4187A 4266A 4488A 4559A 4656A D-151 D-154 W-148	F 3174A 4100A 4187A 4266A 4488A 4559A 4656A D-151 D-154 W-148	F 3174A 4100A 4187A 4266A 4488A 4559A 4656A D-151 D-154 W-148	003
3	51512	AFT OPTICS ASSY	E 3646A 3925A 3959A 4585A	D 3646A 3896A 3925A 3959A 4134A	D 3646A 3896A 3925A 3959A 4134A	001

ORIGINAL PAGE IS
OF POOR QUALITY

IND LVL	PART NO.	NOMENCLATURE	CURRENT REVISION	ACCEPT. REVISION	AS-BUILT REVISION	SERIAL NUMBER
4	50795	PRIME FOCAL PLANE ASSY	J W126	H 3934A 3963A 3982A W126	H 3934A 3968A 3982A W126	201
3	51200	RADIATIVE COOLER ASSY	E 3922A 4201A 4216A 4269A SB-W032 W144 W147 W149 W151	E 3922A 4201A 4216A 4269A SB-W032 W144 W147 W149 W151	E 3922A 4201A 4216A 4269A SB-W032 W144 W147 W149 W151	003
4	50973	COLD FOCAL PLANE ASSY	B 2870A 3895A 4173A SB-D004 W102R1 W109 W111 W134 W135	B 2870A 3895A 4173A SB-D004 W102R1 W109 W111 W134 W135	B 2870A 3895A 4173A SB-D004 W102R1 W109 W111 W134 W135	201
3	51337	TELESCOPE ASSY	D 3866A 3917A W129 W136	D 3866A 3917A W129 W136	D 3866A 3917A W129 W136	002

ORIGINAL PAGE IS
OF POOR QUALITY

TND LVL	PART NO.	NOMENCLATURE	CURRENT REVISION	ACCEPT. REVISION	AS-BUILT REVISION	SERIAL NUMBER
3	52534	RELAY OPTICS ASSY	D 1145A 4097A	D 1145A 4097A	D 1145A 4097A	003
2	3533002-100	SCAN MIRROR ASSY	E	D 13121 13122 64358 64363 64369 64374 W020	D 13121 13122 64358 64363 64369 64374 W020	004

ORIGINAL PAGE IS
OF POOR QUALITY

ORIGINAL PAGE IS
OF POOR QUALITY

SECTION 2.11
RELAY OPTICS

2.11.1

ORIGINAL PAGE IS
OF POOR QUALITY

2.11.1 Relay Optics

2.11.1.1

No performance data was taken at the subsystem level on this subsystem.

2.11.2

ORIGINAL PAGE IS
OF POOR QUALITY

2.11.2

Acceptance Data

2.11.2.1

ORIGINAL PAGE IS
OF POOR QUALITY

2.11.2.1
Configuration Lists

AS-BUILT CONFIGURATION LIST

RELAY OPTICS ASSY

P/N 52534 S/N 003, FLIGHT

IND LVL	PART NO.	NOMENCLATURE	CURRENT REVISION	ACCEPY. REVISION	AS-BUILT REVISION	SERIAL NUMBER
1	52534	RELAY OPTICS ASSY	D + 1145A 4097A	D + 1145A 4097A	D + 1145A 4097A	003
2	50845	RELAY OPTICS BASE	C	C	C	003
2	50846	RELAY OPTICS HOUSING	D	D	D	003
2	51339	FOLDING MIRROR ASSY	A	A	A	003
3	50857	MIRROR, FOLDING	B	B	B	005
2	51340	SPHERICAL MIRROR ASSY	A	A	A	003
3	50855	MIRROR, SPHERICAL RELAY	B	B	B	005
2	51342	TRANSLATOR, INCHWORM	B + 9721	B + 9721	B + 9721	5426 5428 5436
2	53412	THERMISTOR ASSY	B + 1120A 3801A	B + 1120A 3801A	B + 1120A 3801A	202
2	53414	TRANSFORMER ASSY	A	A	A	204 205 206
2	53744	ELECTRONIC ASSY, RIGHT BANK- IPS	A + 9552 9710 2924A 3817A	A + 9552 9710 2924A 3817A	A + 9552 9710 2924A 3817A	201
2	53753	ELECTRONIC ASSY, LEFT BANK- IPS	B + 3810A	A + 9551 1842A 2949A 3810A	A + 9551 1842A 2949A 3810A	201

ORIGINAL PAGE IS
OF POOR QUALITY

P/N 52534


D L	PART NO.	NOMENCLATURE	CURRENT REVISION	ACCEPY. REVISION	AS-BUYLT REVISION	SERIAL NUMBER
	53749	ELEX ASSY-OUTPUT ASSY-IPS	C + 3808A	C + 3808A	C + 3808A	201 202 203
	52024-1	PWB ASSY-IPS	B	A + 7579 8385 8669 8964 9040	A + 7579 8385 8669 8964 9040	107 108 109 201 205 2C9
	52024-2	PWB ASSY-IPS	B	A + 7579 8385 8669 8964 9040	A + 7579 8385 8669 8964 9040	102 104 105
	52029	PWB ASSY-IPS	B	B	B	104 202 203
	53746	ELEX ASSY-OUTPUT PWB-IPS	A + 9597 9682 1706A	A + 9597 9682 1706A	A + 9597 9682 1706A	102 201 203
	53757	ELEX ASSY-REGULATOR MODULE	B + 3916A 4116A	A + 9277 9865 1289A 2086A 2102A 3916A 4116A	A + 9277 9865 1289A 2086A 2102A 3916A 4116A	201
	53754	ELEX ASSY-100V REGULATOR	A + 9862 1705A D039R1	A + 9862 1705A D039R1	A + 9862 1705A D039R1	201

ORIGINAL PAGE IS
OF POOR QUALITY

P/N 52534

ND VL	PART NO.	NOMENCLATURE	CURRENT REVISION	ACCEPT. REVISION	AS-BUILT REVISION	SERIAL NUMBER
4	52041	PWB ASSY, XFMR-MOUNTING	B	A + 8673 9256 9731 9828 1704A 1717A	A + 8673 9256 9731 9828 1704A 1717A	205
5	50875	CHOKE	B	A + 8443 1356A	A + 8443 1356A	F104


Quality Assurance 3-25-82


Configuration Management 3-25-82

ORIGINAL PAGE IS
OF POOR QUALITY

ORIGINAL PAGE IS
OF POOR QUALITY

Listing of Liens

RELAY OPTICS

P/N 52534

FLIGHT

ORIGINAL PAGE IS
OF POOR QUALITY

Failure Reports Number

Open	Closed
	F0553
	F0555
	F1669
	F1744
	F1747
	F1748

Deviation

Waivers

Deviation	Waivers

ORIGINAL PAGE IS
OF POOR QUALITY

RELAY OPTICS

P/N 52534

FLIGHT
Failure Report
No.

PROTOFLIGHT
Failure Report
No.

ENGINEER
Failure Report
No.

Open	Closed	Open	Closed	Open	Closed
	F0553		F0584		F0511
	F0555		F1708		F0514
	F1669		F1710		F0519
	F1744		F1711		F0520
	F1747		F1762		F0526
	F1748		F1763		F1731
			S8011		
			S8046		

ORIGINAL PAGE IS
OF POOR QUALITY

HUGHES
HUGHES AIRCRAFT COMPANY

SPACE AND COMMUNICATION GROUP
FAILURE REPORT

F 0553

1. PROGRAM NAME AND NUMBER TM		2. OLA	3. MODEL F-1	4. TIME OBSERVED 16:00	5. DATE OBSERVED 2 25 82
6. HARDWARE LEVEL WHEN FAILURE WAS OBSERVED <input type="checkbox"/> AIRCRAFT <input type="checkbox"/> SYSTEM <input type="checkbox"/> SUBSYSTEM <input type="checkbox"/> UNIT <input type="checkbox"/> ASSEMBLY <input type="checkbox"/> SUBASSEMBLY <input type="checkbox"/> MODULE <input type="checkbox"/> MECHANISM <input type="checkbox"/> CARD <input type="checkbox"/> PART					
EQUIPMENT IDENTIFICATION					
7. SUBSYSTEM		NAME		PART NUMBER	SN
8. UNIT				51512	003
9. <input checked="" type="checkbox"/> ASSEMBLY <input type="checkbox"/> SUBASSEMBLY		RELAY OPTICS ASSY		52534	003
10. <input type="checkbox"/> MODULE <input type="checkbox"/> MECHANISM <input type="checkbox"/> CARD					
11. OTHER					
12. TEST WHEN FAILURE WAS OBSERVED <input type="checkbox"/> DEVELOPMENT <input type="checkbox"/> QUALIFICATION <input type="checkbox"/> INTEGRATION <input type="checkbox"/> LAUNCH OPERATIONS <input checked="" type="checkbox"/> IMPROGRESS <input type="checkbox"/> ACCEPTANCE <input type="checkbox"/> SYSTEM					
13. ENVIRONMENT WHEN FAILURE WAS OBSERVED <input checked="" type="checkbox"/> AMBIENT <input type="checkbox"/> RADIATION <input type="checkbox"/> TEMPERATURE <input type="checkbox"/> THERMAL VAC <input type="checkbox"/> VIBRATION <input type="checkbox"/> OTHER ASST FOR: _____ USE: _____ TYPE: _____					
14. DESCRIPTION OF FAILURE INCHWORM NO. 2 COMMAND ON TEST BOX (USING FLIGHT IPS) YIELDS NO MOTION IN "DOWN" (RETRACT) DIRECTION. R.O. MOUNTED ON DUMMY A.D. PLATE, WITH .070 SHIP TO "RELAX" SPHERICAL MIRROR DIAPHRAGM					
15. TEST PROCEDURE SEE FR 0555		16. ORIGINATOR W. Balinski		17. ORG 22-35	18. DATE 2-29-82
19. VERIFICATION AND FAILURE ANALYSIS FOUND MISSING WIRE IN TEST CABLE - L3 MISSING FROM CABLE CONNECTING BREAKOUT BOX TO WEPPSAUER					
20. FOLLOWING REMEDIATION REQUIRED FOR CORRECTION OF FAILURE L3 WIRE INSTALLED AS REQUIRED. UNIT WAS IN TEST CONFIGURATION NO OVERSTRESS TO POWER SUPPLY WAS EXPERIENCED					
21. AUTHORIZER W. Balinski				22. ORG 22-35	23. DATE 2-25-82
24. REMEDIATION ACTION TAKEN L3 WIRE INSTALLED.					
25. LIST ALL PARTS REPLACED					
26. REWORK BY Y. Evans ORG 2213 DATE 2/5/82					
27. CAUSE AND CORRECTIVE ACTION WORKMANSHIP AND INSPECTION DISAPPOINTMENT. ALL PERSONNEL INVOLVED HAVE BEEN ADVISED OF PROBLEM AND CAUTIONED TO CHECK CABLES OF TEST EQUIPMENT FOR PROPER INPUT AND OUTPUT CAPACITANCE. CAUSED BY ENGINEERING ERROR. ENGINEER REQUESTED A SPECIAL TEST CABLE TO					
28. BASIC CAUSE OF VERIFIED FAILURE <input type="checkbox"/> DESIGN <input checked="" type="checkbox"/> TEST EQUIP. <input type="checkbox"/> NPL PROCEDURE <input type="checkbox"/> WIRING ERROR <input type="checkbox"/> UNKNOWN DEFECT CODE <input type="checkbox"/> ENVIRONMENTAL <input type="checkbox"/> TEST PROC. <input type="checkbox"/> ACRY/PAG ERROR <input type="checkbox"/> ROUGH HANDLING <input type="checkbox"/> DEFECTIVE PARTS <input type="checkbox"/> TEST SET-UP <input type="checkbox"/> WORKMANSHIP <input type="checkbox"/> WEAR-OUT					
29. FAILURE TYPE <input checked="" type="checkbox"/> PRIMARY <input type="checkbox"/> UNUSUAL <input type="checkbox"/> NO FAILURE <input type="checkbox"/> INDUCED					
30. FAILURE CLASSIFICATION <input type="checkbox"/> CRITICAL <input type="checkbox"/> MAJOR <input type="checkbox"/> MINOR <input type="checkbox"/> SAFETY					
31. RESPONSIBLE ENGINEER W. Balinski ORG 22-35 DATE 3-5-82		32. SPACECRAFT SYSTEM ENGR. J. Engel ORG 22-41 DATE 3/8/82		33. RELIABILITY W. Balinski ORG 5141 DATE 3-5-82	
34. CUSTOMER OR SUPPLIER W. Balinski ORG 5141 DATE 3-5-82					

HUGHES

HUGHES AIRCRAFT COMPANY
SPACE AND COMMUNICATIONS GROUP
EL SEGUNDO, CALIFORNIA

SPACE AND COMMUNICATIONS GROUP

**FAILURE REPORT
CONTINUATION SHEET**

FR SERIAL NO.
F0553
CONTINUATION SHEET LETTER
A

*LABEL FIRST CONTINUATION SHEET USED 'A', SECOND 'B', AND SO ON

IDENTIFY ENTRIES BY REFERENCING FR BLOCK NUMBER IN COLUMN, DATE EACH ENTRY.

ADDITIONAL FR CONTINUATION SHEET(S) USED

30 FABRICATED FOR THIS TEST. HE MARKED UP A COPY OF THE SCHEMATIC DRAWING TO SHOW LEADS REQUIRED FOR THIS TEST. HE THOUGHT THE TWO +5V LINES, K3 AND L3 WERE REDUNDANT, THEREFORE HE DID NOT REQUEST L3 BE WIRED INTO THE ENGINEER. INVOLVED IN THIS DISCREPANCY IS AWARE OF THE ERROR. HE WILL DISPLAY MORE CAUTION IN THE FUTURE.

ORIGINAL PAGE IS
OF POOR QUALITY

ORIGINAL PAGE IS
OF POOR QUALITY



SPACE AND COMMUNICATION GROUP
FAILURE REPORT

F 0555

1. PROGRAM NAME AND NUMBER TM		2. OLA	3. MODEL F-1	4. TIME OBSERVED 17:30	5. DATE OBSERVED 13 82
6. HAZARDOUS LEVEL WHEN FAILURE WAS OBSERVED <input type="checkbox"/> SPACECRAFT <input type="checkbox"/> SYSTEM <input checked="" type="checkbox"/> SUBSYSTEM <input checked="" type="checkbox"/> UNIT <input type="checkbox"/> ASSEMBLY <input type="checkbox"/> SUBASSEMBLY <input type="checkbox"/> MODULE <input type="checkbox"/> MICAM <input type="checkbox"/> CARD <input type="checkbox"/> PART					
EQUIPMENT IDENTIFICATION: NAME PART NUMBER SN MANUFACTURER					
7. QUESYSTEM					
8. UNIT RELAY OPTICS ASSY 52534 003					
9. <input type="checkbox"/> ASSEMBLY <input type="checkbox"/> SUBASSEMBLY					
10. <input type="checkbox"/> MODULE <input type="checkbox"/> MICAM <input type="checkbox"/> CARD					
11. OTHER					
12. TEST WHEN FAILURE WAS OBSERVED <input type="checkbox"/> DEVELOPMENT <input type="checkbox"/> QUALIFICATION <input type="checkbox"/> INTEGRATION <input type="checkbox"/> LAUNCH OPERATIONS <input checked="" type="checkbox"/> PROGRESS <input type="checkbox"/> ACCEPTANCE <input type="checkbox"/> SYSTEM					
13. ENVIRONMENT WHEN FAILURE WAS OBSERVED <input checked="" type="checkbox"/> ACCIDENT <input type="checkbox"/> RADIATION <input type="checkbox"/> TEMPERATURE <input type="checkbox"/> THERMAL VAC <input type="checkbox"/> KSL AT <input type="checkbox"/> EMC/RFI <input type="checkbox"/> VIBRATION <input type="checkbox"/> AXIS FOR <input type="checkbox"/> USE <input type="checkbox"/> TYPE <input type="checkbox"/> OTHER					
14. DESCRIPTION OF FAILURE INCHWORM NO. 2 COMMAND ON TEST BOX YIELDS LOW MV READINGS PER STEP DURING FIRST STEPS IN EITHER DIRECTION. SUBSEQUENT STEPS IN "DOWN" DIRECTION ARE SMALL, APPROX 1 TO 2 MV.					
15. TEST PROCEDURE		16. ORIGINATOR W. Balucha	17. ORG 22-35	18. DATE 12-13-82	19. CONTINUATION SHEET USED
20. VERIFICATION AND FAILURE ANALYSIS SUBSERVENT OPERATION IN RETRACT ("DOWN") DIRECTION NEARER TO OPTICAL ALIGNMENT POSITION YIELDS LITTLE OR NO MOVEMENT. LVDT CLAMP LOOSENING SHOWN PROBLEM TO BE INDEPENDANT OF LVDT ALIGNMENT.					
21. FOLLOWING REWORK/RETEST REQUIRED L3 WIRE TO BE INSTALLED IN TEST CABLE. UNIT WAS IN TEST CONFIGURATION. NO OVERSTRESS TO POWER SUPPLY WAS EXPERIENCED.					
22. REWORK/RETEST ACTION TAKEN L3 WIRE INSTALLED AS REQUIRED.		23. AUTHORIZATION W. Balucha	24. ORG 22-35	25. DATE 1	26. CONTINUATION SHEET USED
27. REWORK BY ORG DATE 28. RETESTED BY ORG DATE 29. CONTINUATION SHEET USED					
30. CAUSE AND CORRECTIVE ACTION ENGINEER REQUESTED A SPECIAL TEST CABLE BE FABRICATED FOR THIS TEST. HE MARKED UP A COPY OF SCHEMATIC TO SHOW LEADS REQUIRED FOR THIS TEST. HE THOUGHT K3 AND L3 WERE REDUNDANT BOTH ARE +5V LINES, THEREFORE HE DID NOT REQUEST L3 BE WIRED IN. THE ENGINEER INVOLVED IS AWARE OF THE DISCREPANCY AND WILL BE MORE CAUTIOUS.					
31. PRO CLOSURE <i>[Signature]</i> 3/16/82					
32. DOCUMENT IMPLEMENTING CORRECTIVE ACTION					
33. BASIC CAUSE OF VERIFIED FAILURE <input type="checkbox"/> DESIGN <input checked="" type="checkbox"/> TEST EQUIP. <input type="checkbox"/> MFG. PROCEDURE <input type="checkbox"/> WIRING ERROR <input type="checkbox"/> UNKNOWN <input type="checkbox"/> ENVIRONMENTAL <input type="checkbox"/> TEST PROC. <input type="checkbox"/> ASBY/FAB ERROR <input type="checkbox"/> ROUGH HANDLING <input type="checkbox"/> DEFECT CODE <input type="checkbox"/> DEFECTIVE PARTS <input type="checkbox"/> TEST SET-UP <input type="checkbox"/> WORKMANSHIP <input type="checkbox"/> WEAR-OUT					
34. FAILURE TYPE <input type="checkbox"/> PRIMARY <input type="checkbox"/> UNKNOWN <input type="checkbox"/> NO FAILURE <input checked="" type="checkbox"/> INDUCED					
35. FAILURE CLASSIFICATION <input type="checkbox"/> CRITICAL <input checked="" type="checkbox"/> MINOR <input type="checkbox"/> MAJOR <input type="checkbox"/> SAFETY					
37. RESPONSIBLE ENGINEER W. Balucha		38. ORG 22-35	39. DATE 3-12-82	40. SPACECRAFT SYSTEM ENGR. [Signature]	
38. RELIABILITY [Signature]		41. ORG 57-41	42. DATE 3-12-82	43. CUSTOMER OR SUPPLIER [Signature]	

ORIGINAL PAGE IS
OF POOR QUALITY

HUGHES
HUGHES AIRCRAFT COMPANY

SPACE AND COMMUNICATION GROUP
FAILURE REPORT

F 1669

1. PROGRAM NAME AND NUMBER THEMATIC MAP		2. GLA	3. MODEL FLT	4. TIME OBSERVED 0900	5. DATE OBSERVED FEB 3 82
6. HARDWARE LEVEL WHEN FAILURE WAS OBSERVED <input type="checkbox"/> SPACECRAFT <input type="checkbox"/> SYSTEM <input checked="" type="checkbox"/> UNIT <input type="checkbox"/> SUBASSEMBLY <input type="checkbox"/> MODULE <input type="checkbox"/> MICAM <input type="checkbox"/> CARD <input type="checkbox"/> PART					
EQUIPMENT IDENTIFICATION: NAME PART NUMBER SYN MANUFACTURER					
7. SUBSYSTEM					
8. UNIT					
9. <input checked="" type="checkbox"/> ASSEMBLY <input type="checkbox"/> SUBASSEMBLY RELAY OPTICS 52534 3 SBRC					
10. <input type="checkbox"/> MODULE <input type="checkbox"/> MICAM <input type="checkbox"/> CARD					
11. OTHER					
12. TEST WHEN FAILURE WAS OBSERVED <input type="checkbox"/> DEVELOPMENT <input type="checkbox"/> IN-PROGRESS <input type="checkbox"/> QUALIFICATION <input type="checkbox"/> ACCEPTANCE <input type="checkbox"/> INTEGRATION <input type="checkbox"/> SYSTEM <input type="checkbox"/> LAUNCH OPERATIONS PRE <input type="checkbox"/> SPECIAL VACUUM					
13. ENVIRONMENT WHEN FAILURE WAS OBSERVED <input checked="" type="checkbox"/> AMBIENT <input type="checkbox"/> RADIATION <input checked="" type="checkbox"/> TEMPERATURE ROOM <input type="checkbox"/> THERMAL VAC <input type="checkbox"/> MRS. AT <input type="checkbox"/> OTHER					
14. DESCRIPTION OF FAILURE LEFT BANK LVDT DOES NOT REVERSE RIGHT BANK DOES NOT RESPOND					
15. TEST PROCEDURE JTR F-003 PARA		16. ORIGINATOR L. CRISS		ORG	DATE FEB 3
17. VERIFICATION AND FAILURE ANALYSIS FUSIONICABLE LEASIBLE SHORTING SHOWS OPEN WIRE IN PR OF FLIGHT CABLE AND WIRE WAS MISSING IN WEARSAVER CABLE. UNIT WAS IN TEST CONFIGURATION. NO OVERSTRESS OF PARTS OCCURRED					
18. FOLLOWING REWORK/RETEST REQUIRED REPAIR FLIGHT CABLE AND WEARSAVER. RETEST RELAY OPTICS, INCHWORM & LVDT					
21. AUTHORIZATION W. Balinski		ORG	DATE 22-35 82-3-8	22. CONTINUATION SHEET USED	
23. REWORK/RETEST ACTION TAKEN REPAIRED FLIGHT CABLE AND WEARSAVER. RETEST SUCCESSFULLY					
24. LIST ALL PARTS REPLACED					
25. REWORK BY ORG DATE 26. RETESTED BY ORG DATE 27. CONTINUATION SHEET USED					
28. CAUSE AND CORRECTIVE ACTION POOR WORKMANSHIP CAUSED OPENS. ONE DISCREPANCY WAS AN OPEN AT HR IN CONNECTOR PR, THE OTHER WAS A MISSING WIRE IN WEAR SAVER.					
29. ASSEMBLY TECHNICIANS AND QUALITY CONTROL PERSONNEL WERE ADVISED OF THE DISCREPANCIES AND CAUTIONED TO PREVENT THEIR REOCCURRENCE.					
30. BASIC CAUSE OF VERIFIED FAILURE <input type="checkbox"/> DESIGN <input type="checkbox"/> ENVIRONMENTAL <input type="checkbox"/> DEFECTIVE PARTS <input type="checkbox"/> TEST EQUIP <input type="checkbox"/> TEST PROC. <input type="checkbox"/> TEST SET-UP <input type="checkbox"/> MFG. PROCEDURE <input type="checkbox"/> ASSY/FAB ERROR <input checked="" type="checkbox"/> WORKMANSHIP <input type="checkbox"/> WIRING ERROR <input type="checkbox"/> ROUGH HANDLING <input type="checkbox"/> WEAR-OUT <input type="checkbox"/> UNKNOWN <input type="checkbox"/> DEFECT CODE					
31. FAILURE TYPE <input checked="" type="checkbox"/> PRIMARY <input type="checkbox"/> INDUCED <input type="checkbox"/> UNKNOWN <input type="checkbox"/> NO FAILURE					
32. FAILURE CLASSIFICATION <input type="checkbox"/> CRITICAL <input checked="" type="checkbox"/> MAJOR <input type="checkbox"/> MINOR <input type="checkbox"/> SAFETY					
33. RESPONSIBLE ENGINEER W. Balinski		ORG 122-35	DATE 12-3-82	34. SPACECRAFT SYSTEM ENGR L. Criss	
35. RELIABILITY 2		ORG 151-41	DATE 12-8-82	36. CUSTOMER SUPPLIER SA	

[Handwritten Signature]
3/10/82

HUGHES

HUGHES AIRCRAFT COMPANY
SPACE AND COMMUNICATIONS GROUP
EL SEGUNDO, CALIFORNIA

ORIGINAL PAGE IS
OF POOR QUALITY
SPACE AND COMMUNICATIONS GROUP
FAILURE REPORT

23/ F1744
~~XXXXXXXXXX~~

ORIGINATOR	1. PROGRAM NAME AND NUMBER <i>T.M. PL1162</i>		2. GLA <i>V011</i>		3. MODEL <i>F1</i>		4. TIME OBSERVED		5. DATE OBSERVED <i>MO 9 DA 29 YR 80</i>			
	6. HARDWARE LEVEL WHEN FAILURE WAS OBSERVED		<input type="checkbox"/> SPACECRAFT <input type="checkbox"/> SYSTEM		<input type="checkbox"/> SUBSYSTEM <input type="checkbox"/> UNIT		<input type="checkbox"/> ASSEMBLY <input checked="" type="checkbox"/> SUBASSEMBLY		<input type="checkbox"/> MODULE <input type="checkbox"/> MICAM			
	EQUIPMENT IDENTIFICATION:		NAME		PART NUMBER		S/N		MANUFACTURER			
	7. SUBSYSTEM											
	8. UNIT											
	9. <input type="checkbox"/> ASSEMBLY <input checked="" type="checkbox"/> SUBASSEMBLY		<i>INPS</i>		<i>53757</i>		<i>201</i>		<i>SBRC</i>			
	10. <input type="checkbox"/> MODULE <input type="checkbox"/> MICAM <input type="checkbox"/> CARD											
	11. OTHER		<i>XMPR</i>		<i>52041</i>							
	12. TEST WHEN FAILURE WAS OBSERVED		<input type="checkbox"/> DEVELOPMENT <input type="checkbox"/> IN-PROCESS		<input type="checkbox"/> QUALIFICATION <input checked="" type="checkbox"/> ACCEPTANCE		<input type="checkbox"/> INTEGRATION <input type="checkbox"/> SYSTEM		<input type="checkbox"/> LAUNCH OPERATIONS			
	13. ENVIRONMENT WHEN FAILURE WAS OBSERVED		<input checked="" type="checkbox"/> AMBIENT <input type="checkbox"/> EMC/RF		<input type="checkbox"/> RADIATION <input type="checkbox"/> VIBRATION		<input type="checkbox"/> TEMP _____ ° AXIS FOR _____		<input type="checkbox"/> THERMAL VAC _____ HRS AT _____ <input type="checkbox"/> OTHER			
	14. DESCRIPTION OF FAILURE		<i>TRANSFORMER (T1) MEMBERS OPEN AT SECONDARY CIRCUIT.</i>									
	ENGINEERING EVALUATION	18. TEST PROCEDURE <i>16796</i>		PARA <i>4.1</i>		16. ORIGINATOR <i>J. KOBAS</i>		ORG <i>2235</i>		DATE <i>10-3-80</i>		
		19. VERIFICATION AND FAILURE ANALYSIS		<i>TRANSFORMER WAS FOUND TO BE DEFECTIVE PRIOR TO APPLICATION OF POWER.</i>								
		19. FAILED ITEM NAME AND PART NUMBER		<i>52041 (T1)</i>								
20. <input checked="" type="checkbox"/> FOLLOWING REWORK/RETEST REQUIRED <input type="checkbox"/> REWORK/RETEST NOT REQUIRED BECAUSE		<i>REPLACE T1 (52041 S/N 202) & RETEST PCL 16796 NOTE: TRANSFORMER P/5094 WAS REMOVED & REPLACED BY PRINTED WIRING BOARD P/52041.</i>										
21. AUTHORIZATION				ORG <i>2235</i>		DATE <i>10-21-80</i>		17. CONTINUATION SHEET USED				
22. REWORK/RETEST ACTION TAKEN		<i>TRANSFORMER REPLACED & RETEST PERFORMED. SEE ATTACHED DATA.</i>										
23. LIST ALL PARTS REPLACED		PART NUMBER		CKT SYM		PART LOT NUMBER		DATE CODE		MANUFACTURER		
		<i>50940</i>		<i>T1</i>								
27. REWORK BY		ORG		DATE		28. RETESTED BY		ORG		DATE		
29. CAUSE AND CORRECTIVE ACTION		<i>UNKNOWN. PART LOST BY RELIABILITY. CONTROL OF REMOVED PARTS HAS BEEN CHANGED. PARTS ARE NOW SENT TO MRR ON A NON CONFORMING MATERIAL REPORT AND DISPOSITIONED AS NECESSARY. PARTS REQUIRING FAILURE ANALYSIS WILL BE SENT TO THE PARTS BOARD ON A 778 FORM (REIT) AND A SHIPPER TO MAINTAIN PARTS CONTROL.</i>										
ENGINEERING/RELIABILITY	31. DOCUMENT IMPLEMENTING CORRECTIVE ACTION											
	34. BASIC CAUSE OF VERIFIED FAILURE		<input type="checkbox"/> DESIGN ENVIRONMENTAL DEFECTIVE PARTS		<input type="checkbox"/> TEST EQUIPMENT <input type="checkbox"/> TEST PROCEDURE <input type="checkbox"/> TEST SET-UP		<input type="checkbox"/> MFG. PROCEDURE <input type="checkbox"/> ASSY/FAB ERROR <input type="checkbox"/> WORKMANSHIP		<input type="checkbox"/> WIRING ERROR <input type="checkbox"/> ROUGH HANDLING <input type="checkbox"/> WEAR-OUT		35. UNKNOWN DEFECT CODE	
	35. FAILURE TYPE		<input type="checkbox"/> PRIMARY <input type="checkbox"/> INDUCED		<input checked="" type="checkbox"/> UNKNOWN <input type="checkbox"/> NO FAILURE		33. FAILURE CLASSIFICATION		<input type="checkbox"/> CRITICAL <input checked="" type="checkbox"/> MAJOR		<input type="checkbox"/> MINOR <input type="checkbox"/> SAFETY	
	37. RESPONSIBLE ENGINEER		ORG <i>2235</i>		DATE <i>1-31-82</i>		38. SPACECRAFT SYSTEM ENGINEER		ORG <i>SBRC</i>		DATE <i>2/2/82</i>	
39. RELIABILITY		ORG <i>51-41</i>		DATE <i>2-2-82</i>		40. WORKMAN OR SUPPLIER						

ORIGINAL PAGE IS
OF POOR QUALITY

SECTION 2.12
ELECTRONICS MODULE

ORIGINAL PAGE IS
OF POOR QUALITY

2.12.1

Section 2.12.2

Electronics Module

Performance Data

The acceptance performance (test) data for the Electronic
Module is contained in Appendix E of this report
(Vol. IV, part E).

2.12.2

ORIGINAL PAGE IS
OF POOR QUALITY

2.12.2
Acceptance Data

2.12.2.1

ORIGINAL PAGE 19
OF POOR QUALITY

2.12.2.1

Configuration Lists

AS-BUILT CONFIGURATION LIST

ELECTRONICS MODULE ASSY REV 2
52347 S/N 201

IND LVL	PART NO.	NOMENCLATURE	CURRENT REVISION	ACCEPT. REVISION	AS-BUILT REVISION	SERIAL NUMBER
2	52347	ELECTRONICS MODULE	D 4588A	B 4293A 4242A 4091A 4113A	B 4293A 4242A 4091A 4113A	201
3	3533003-100	MULTIPLEXER ASSY	C R43009 43074 65661 65662 W124 W125	C 43074 65661 65662 W124 W125	C 43009 43074 65661 65662 W124 W125	003
3	50869	POWER, SUPPLY ASSY	D 2015A 2039A D030 D068 W074 W092 W093 W101	D 2015A 2039A D030 D068 W074 W092 W093 W101	D 2015A 2039A D030 D068 W074 W092 W093 W101	004
3	50900	PWB ASSY, SERIAL MAGNITUDE COMMAND	C 3716A D046 W06CR1 W097	C 3716A D046 W06OR1 W097	C 3716A D046 W06OR1 W097	002

ORIGINAL PAGE IS
OF POOR QUALITY

D I	PART NO.	NOMENCLATURE	CURRENT REVISION	ACCEP. REVISION	AS-BUILT REVISION	SERIAL NUMBER
	50904-1	PWB ASSY, POSTAMP BAND #1	G	G	G	101
		NOTE: Configuration will conform to "As Built" pending incorporation of EO 3142A	4072A	4072A	4072A	
			D045	D045	D045	
			D090	D090	D090	
			D105	D105	D105	
			W017	W017	W017	
			W060R1	W060R1	W060R1	
			W097	W097	W097	
			W167	W167	W167	
	50904-2	PWB ASSY, POSTAMP BAND #2	G	G	G	201
		NOTE: Configuration will conform to "As Built" pending incorporation of EO 3142A	4072A	4072A	4072A	
			D045	D045	D045	
			D090	D090	D090	
			D105	D105	D105	
			W017	W017	W017	
			W060R1	W060R1	W060R1	
			W097	W097	W097	
	50904-3	PWB ASSY, POSTAMP BAND #3	G	G	G	201
		NOTE: Configuration will conform to "As Built" pending incorporation of EO 3142A	4072A	4072A	4072A	
			D045	D045	D045	
			D090	D090	D090	
			D105	D105	D105	
			D135	D135	D135	
			W017	W017	W017	
			W060R1	W060R1	W060R1	
			W097	W097	W097	
	50904-4	PWB ASSY, POSTAMP BAND #4	G	G	G	201
		NOTE: Configuration will conform to "As Built" pending incorporation of EO 3142A	4072A	4072A	4072A	
			D045	D045	D045	
			D090	D090	D090	
			D105	D105	D105	
			W017	W017	W017	
			W060R1	W060R1	W060R1	
			W097	W097	W097	
			W120	W120	W120	

ORIGINAL PAGE IS
OF POOR QUALITY

P/N 52347

S 3

ID /L	PART NO.	NOMENCLATURE	CURRENT REVISION	ACCEP. REVISION	AS-BUILT REVISION	SERIAL NUMBER
	50908-1	PWB ASSY, POSTAMP BAND #5	D 3567A D090 W018 W060R1 W097	D 3567A D090 W018 W060R1 W097	D 3567A D090 W018 W060R1 W097	201
	50908-2	PWB ASSY, POSTAMP BAND #7	D 3567A D090 W018 W060R1 W097	D 3567A D090 W018 W060R1 W097	D 3567A D090 W018 W060R1 W097	201
	50912	PWB ASSY, POSTAMP BAND #6	E D091 D094 D136 W060R1 W097	E D091 D094 D136 W060R1 W097	E D091 D094 D136 W060R1 W097	201
	50916	PWB ASSY CALIB. SHUTTER MAIN	F D080 D104R1 D109R1 D111 D116 D117 W035 W060R1 W097	F D080 D104R1 D109R1 D111 D116 D117 W035 W060R1 W097	F D080 D104R1 D109R1 D111 D116 D117 W035 W060R1 W097	201

ORIGINAL PAGE IS
OF POOR QUALITY

ID	PART NO.	NOMENCLATURE	CURRENT REVISION	ACCEPT. REVISION	AS-BUILT REVISION	SERIAL NUMBER
3	50920	PWB ASSY, TEMP CONTROL	D 3717A 4290A D054 D077 D093 D101 D116 W012 W060R1 W097	C 3457A 4290A D054 D077 D093 D101 D116 W012 W060R1 W097	C 3457A 4290A D054 D077 D093 D101 D116 W012 W060R1 W097	101
3	50926	PWB ASSY, CALIB LAMP AND INCHWORM DRIVERS	E D044 D088R1 D115 SB-W031 W060R1 W097	E D044 D088R1 D115 SB-W031 W060R1 W097	E D044 D088R1 D115 SB-W031 W060R1 W097	201
	50942	TEMPERATURE CONTROL	G 4343A 4565A D150	F 3740A 3763A 3809A 3819A 4343A 4565A D150	F 3740A 3763A 3809A 3819A 4343A 4565A D150	202
	50948	PWB ASSY, VERIFICATION REGISTER	E 3218A 3718A 3836A D079 D114 D131 W022 W060R1 W097	E 3218A 3718A 3836A D079 D114 D131 W022 W060R1 W097	E 3218A 3718A 3836A D079 D114 D131 W022 W060R1 W097	201

ORIGINAL PAGE IS
OF POOR QUALITY

P/N 52347

Sh 6

ND VL	PART NO.	NOMENCLATURE	CURRENT REVISION	ACCEP. REVISION	AS-BUILT REVISION	SERIAL NUMBER
	51813	MACRO DISCRETE	C	C	C	201
			3705A	3705A	3705A	
			D078	D078	D078	
			W060R1	W060R1	W060R1	
			W097	W097	W097	
	52250-1	PWB ASSY, SCAN LINE CORRECTOR	C	C	C	
			1080A	1080A	1080A	
			1638A	1638A	1638A	
			2671A	2671A	2671A	
			3272A	3272A	3272A	
			3712A	3712A	3712A	
			W011	W011	W011	
			D116	D116	D116	
			W060R1	W060R1	W060R1	
			W097	W097	W097	
	52250-2	PWB ASSY, SCAN LINE CORRECTOR	C	C	C	
			1080A	1080A	1080A	
			1638A	1638A	1638A	
			2671A	2671A	2671A	
			3272A	3272A	3272A	
			3712A	3712A	3712A	
			W011	W011	W011	
			D116	D116	D116	
			W060R1	W060R1	W060R1	
			W097	W097	W097	
	52348	CABLE RTG ASSY	F	F	F	005
			3844A	3844A	3844A	

ORIGINAL PAGE IS
OF POOR QUALITY

P/N 52347

Sh 7

IND LVL	PART NO.	NOMENCLATURE	CURRENT REVISION	ACCEPT. REVISION	AS-BUILT REVISION	SERIAL NUMBER
3	52360	COVER, TOP	B 1620A 1854A 1877A	B 1620A 1854A 1877A	B 1620A 1854A 1877A	
3	52362	COVER, BOTTOM	B 1855A 1884A	B 1855A 1884A	B 1855A 1884A	
3	52363	COVER, BOTTOM FRONT	B 1621A 1856A 1878A	B 1621A 1856A 1878A	B 1621A 1856A 1878A	
3	52797	PWB ASSY AUX CIRCUIT BOARD	C 3711A W014 W060R1 W097	C 3711A W014 W060R1 W097	C 3711A W014 W060R1 W097	201
3	53393	COVER FRONT	A 1879A	A 1879A	A 1879A	
3	53877	PWB ASSY, MOTOR DRIVER COOLER DOOR	B 3706A D037 D098 D100 D116 W019 W060R1 W097 4456A	B 3706A D037 D098 D100 D116 W019 W060R1 W097 4456A	B 3706A D037 D098 D100 D116 W019 W060R1 W097 4456A	101

ORIGINAL PAGE IS
OF POOR QUALITY

P/N 52347

She. 8

IND LVL	PART NO.	NOMENCLATURE	CURRENT REVISION	ACCEPT. REVISION	AS-BUILT REVISION	SERIAL NUMBER
3	16268	PROCESS SPEC, SURFACE MTD COMPONENTS	A	A	A	
			2216A	2216A	2216A	
			2940A	2940A	2940A	
			3080A	3080A	3080A	
			3283A	3283A	3283A	
3	16704	ACCEPTANCE TEST, PROCEDURE FOR ELECTRONICS MODULES	C	C	C	
			3987A	3987A	3987A	
			4059A	4059A	4059A	
			4089A	4089A	4089A	
			4159A	4159A	4159A	
			4180A	4180A	4180A	


 R. A. Groves, CDMO


 W. D. Adams, Quality

ORIGINAL PAGE IS
 OF POOR QUALITY

2.12.2.2

ORIGINAL PAGE 18
OF POOR QUALITY

Listing of Liens

ELECTRONIC MODULE

P/N 52347

FLIGHT

ORIGINAL PAGE IS
OF POOR QUALITY

Failure Reports Number

<u>Open</u>	<u>Closed</u>	<u>Closed</u>
S8021	F0606	S8315
	F0622	S8316
	F1666	S8320
	F1667	S8321
	F1668	S8325
	F1761	S8326
	F1769	S8327
	F1774	S8329
	F1776	S8343
	F1781	S8363
	F1783	S8364
	F2722	S8365
	F2723	S8367
	F2724	S8368
	S8049	S8372
	S8050	S8384
	S8051	S8390
	S8107	S8407
	S8108	S8446
	S8109	S8447
	S8110	S8456
	S8112	S8460
	S8125	S8464
	S8126	
	S8133	
	S8139	
	S8180	
	S8283	
	S8309	
	S8310	
	S8311	
	S8312	
	S8313	
	S8314	

Deviations

Waivers

D-125	
D-129	
D-130	
D-131	
D-133	
D-135	
D-136	
D-137	
D-147	
D-150	
D-159	

ORIGINAL PAGE IS
OF POOR QUALITY

ELECTRONIC MODULE

P/N 52347

FLIGHT			PROTOFLIGHT		ENGINEER	
Failure Report No.			Failure Report No.		Failure Report No.	
Open	Closed		Open	Closed	Open	Closed
S8021	F0606	S8326		F0551 F2707		F0501
	F0622	S8327		F0582 F2708		F0509
	F1666	S8329		F0584 F2720		F0515
	F1667	S8343		F0590 F2738		F0516
	F1668	S8363		F0601 F2741		F0534
	F1761	S8364		F0621 F2758		F0539
	F1769	S8365		F1703 F2759		F0542
	F1774	S8367		F1709 F2760		F0548
	F1776	S8368		F1712 F5175		?F0549
	F1781	S8384		F1713 F5183		F0563
	F1783	S8390		F1715 F5189		F0564
	F2722	S8407		F1719 S8012		F0593
	F2723	S8446		F1773 S8024		F1720
	F2724	S8447		F1777 S8044		F2646
		S8456		F1778 S8045		F2692
	S8049	S8460		F1779 S8047		F2743
	S8050	S8464		F1789 S8069		F2744
	S8051			F1796 S8073		F2750
	S8107			F1797 S8074		F2752
	S8108			F2362 S8466		F2754
	S8109			F2363		F2756
	S8110			F2391		F2797
	S8112			F2393		
	S8125			F2394		
	S8126			F2633		
	S8133			F2634		
	S8139			F2638		
	S8180			F2640		
	S8283			F2671		
	S8309			F2686		
	S8310			F2693		
	S8311			F2694		
	S8312			F2695		
	S8313			F2698		
	S8314			F2699		
	S8315			F2700		
	S8316			F2701		
	S8320			F2702		
	S8321			F2703		
	S8325			F2705		
				F2706		

ORIGINAL PAGE IS
OF POOR QUALITY

Program Instruction 010

REQUEST FOR DEVIATION/WAIVER
(SEE MIL-STD-460 OR 481 FOR INSTRUCTIONS)

DATE PREPARED

PROCURING ACTIVITY NO.

1. ORIGINATOR NAME AND ADDRESS
Santa Barbara Research Center (Hughes Aircraft Co)
75 Coromar Drive, Goleta, CA 93117

2. DEVIATION WAIVER
3. MINOR MAJOR CRITICAL

4. DESIGNATION FOR DEVIATION/WAIVER

a. MODEL/TYPE	b. MFR. CODE	c. SYS. DESIG.	d. DEV/WAIVER NO.
PF & F1	11323	TM	D125

5. BASE LINE AFFECTED
 FUNC-TIONAL ALLO-CATED PROD-UCT

6. OTHER SYSTEMS/CONFIGURATION ITEMS AFFECTED
 YES NO

7. SPECIFICATIONS AFFECTED-TEST PLAN			8. DRAWINGS AFFECTED				
	MFR. CODE	SPEC./DOC. NO.	SCN	MFR. CODE	NUMBER	REV.	NOR. NO.
a. SYSTEM							
b. ITEM				11323	51402	D	EO 3570A
c. TEST PLAN							

9. TITLE OF DEVIATION/WAIVER
LAMP SEQUENCER PWB ALTERNATE WIRING

10. CONTRACT NO. & LINE ITEM
NAS 5-24200

11. CONFIGURATION TYPE NOMENCLATURE
Electronic Module Assembly

12. CD NO.
II

13. DEFECT NO. & 14. DEFECT CLASSIFICATION
 MINOR MAJOR CRITICAL

15. NAME OF PART OR LOWEST ASSEMBLY AFFECTED
PWB TLMY Scaling, Fuse-

16. PART NO. OR TYPE DESIG.
51402-D

17. LOT NO.
002/00B

18. QTY
2

19. RECURRING DEVIATION/WAIVER
 YES NO

20. EFFECT ON COST/PRICE link, Lamp Seq.

21. EFFECT ON DELIVERY SCHEDULE
5 Month Schedule Impact if disapproved.

22. EFFECT ON INTEGRATED LOGISTIC SUPPORT, INTERFACE, ETC.

23. DESCRIPTION OF DEVIATION/WAIVER
Request authorization to add Resistor and alternate wiring (jumpers) to accommodate circuit design changes.

24. NEED FOR DEVIATION/WAIVER
Redesign and reprourement of electronic circuit boards would be required in order to eliminate alternate wiring and addition of resistor. Minimum 5 months' schedule slip and considerable cost would be involved. Redesign is not considered cost effective at this time.

25. PRODUCTION EFFECTIVITY BY SERIAL NUMBER
51065 S/N 002 & SUBSO

26. SUBMITTING ACTIVITY AUTHORIZING SIGNATURE
L. Evans
SYS ENGR J. Engel

27. APPROVAL/DISAPPROVAL
RE: [Signature]
QA: [Signature]
PE: [Signature]
CMO: [Signature]

27. APPROVAL/DISAPPROVAL
TITLE: Minor - System Engineering
Major/Critical - Program Manager

28. APPROVAL/RECOMMENDATION
 APPROVAL RECOMMENDED APPROVED DISAPPROVED

29. GOVERNMENT ACTIVITY
NASS CSFC

SIGNATURE: [Signature]
DATE: 9/1/81

ORIGINAL PAGE IS
OF POOR QUALITY

Program Instruction 810

REQUEST FOR DEVIATION/WAIVER
SEE MIL-STD-883C FOR INSTRUCTIONS

DATE PREPARED
11/05/81

PROCESSING ACTIVITY NO.

1. ORIGINATOR NAME AND ADDRESS Santa Barbara Research Center 75 Coromar Dr. Goleta, CA 93117				<input checked="" type="checkbox"/> DEVIATION <input type="checkbox"/> WAIVER <input checked="" type="checkbox"/> MINOR <input type="checkbox"/> MAJOR <input type="checkbox"/> CRITICAL	
2. DESIGNATION FOR DEVIATION/WAIVER				3. BASE LINE AFFECTED	
4. MODEL TYPE Flight	5. WFR. CODE 11323	6. SYS. DESIG. TM	7. DEVIATION NO. D-129	<input type="checkbox"/> FUNCTIONAL	<input type="checkbox"/> ALL-DAYED
8. SPECIFICATIONS AFFECTED-TEST PLAN				9. DRAWINGS AFFECTED	
10. SYSTEM				11. STEP SYSTEMS/CONNECTIONS AFFECTED	
12. WFR. CODE 52934-A				13. YES <input checked="" type="checkbox"/> NO	
14. TITLE OF DEVIATION/WAIVER Use of alternate terminal assembly.				15. CONTRACT NO. / LINE NO. NAS5-24200	
16. IDENTIFICATION ITEM NOMENCLATURE Board Capacitor and Relay Assy.				17. DEFECT CLASSIFICATION <input checked="" type="checkbox"/> MINOR <input type="checkbox"/> MAJOR <input type="checkbox"/> CRIT. CA.	
18. NAME OF PART OR SUB-ASSEMBLY AFFECTED Terminal STUD, Insulated E25-E29				19. RECORDING DEVIATION/WAIVER <input type="checkbox"/> YES <input checked="" type="checkbox"/> NO	
20. EFFECT ON COST/PRICE None				21. EFFECT ON DELIVERY SCHEDULE 5 month schedule slip if dev. not approved.	
22. EFFECT ON INTEGRATED LOGISTIC SUPPORT, INTERFACE, ETC. None					
23. DESCRIPTION OF DEVIATION/WAIVER Request usage of Qty. 5 53413 bond on type terminals in place of Qty. 5 54310 terminals for designated E25 to E29 on EO 2853A of 52934-A assembly.					
24. NEED FOR DEVIATION/WAIVER 54310 terminals are unavailable in SBRC or HAC stores. Outside procurement estimated at 3 months. Thematic Mapper schedule slip of 3 months will result if alternate terminal usage is not approved. Note: P/N 53413 is not on the TM Approved Parts and Materials List, however they are on the MES Approved Parts and Materials List.					
25. PRODUCTION EFFECTIVITY BY SERIAL NUMBER 51065 SN 003 ONLY				26. APPROVAL/DISAPPROVAL <input type="checkbox"/> APPROVAL RECOMMENDED <input checked="" type="checkbox"/> APPROVED <input type="checkbox"/> DISAPPROVED	
27. SIGNATURE J.A. Bonach				28. SIGNATURE H. E. ...	
29. TITLE SYS ENGR				30. TITLE Minor - System Engineer Major/Critical - Program Manager	
31. DEPARTMENT ACTIVITY 11/05/81					

DD FORM 1694

Go to previous page, insert by T.M.P.

ORIGINAL PAGE IS
OF POOR QUALITY

PROCEED INSTRUCTIONS 010

REQUEST FOR DEVIATION/WAIVER
SEE 48-127-40 OR 41 FOR INSTRUCTIONS

DATE PREPARED

11/05/81

PROCURING ACTIVITY NO

1. ORIGINATOR NAME AND ADDRESS Santa Barbara Research Center 75 Coromar Dr. Goleta, CA 93117				2. X DEVIATION <input checked="" type="checkbox"/> WAIVER <input type="checkbox"/>	
3. DESIGNATION FOR DEVIATION/WAIVER				13. BASE LINE EFFECTED	
4. MODEL TYPE Plt.	5. WFR CODE 11323	6. SYS. DESIGN. TM	7. DEVIA/WAIVER NO. D-130	8. <input type="checkbox"/> FUNC. ORIGINAL <input type="checkbox"/> ALLG. DATES <input checked="" type="checkbox"/> PROD. DATE	9. OTHER SYSTEM/COMPONENTS AFFECTED <input type="checkbox"/> YES <input checked="" type="checkbox"/> NO
10. SPECIFICATIONS AFFECTED-TEST PLAN			11. DRAWINGS AFFECTED		
12. SYSTEM	14. WFR CODE 11323	15. SPEC. DOC. NO.	16. WFR CODE 51795	17. REV. E	18. DOC. NO. EO 3835A
19. TYPE OF DEVIATION/WAIVER Alternate component placement (non contact to board)					20. CONTRACT NO. & LINE NO. NAS5-24200
21. NAME OF DEVIATION/WAIVER Thematic Mapper Assy.					22. EFFECT CLASSIFICATION <input checked="" type="checkbox"/> KN <input type="checkbox"/> MAJOR <input type="checkbox"/> CRITICAL
23. PRINTED WIRING BOARD ASSY. Macro discrete Com. #1					24. LOT NO. & P 51795-E
25. EFFECT ON DELIVERY SCHEDULE None					26. EFFECT ON DELIVERY SCHEDULE
27. EFFECT ON INTEGRATED SCHEMATIC APPROVAL, INTERFACE, ETC. None					
28. DESCRIPTION OF DEVIATION/WAIVER					

Need to be able to mount components off the board surface as shown on drawing. Support bonding shall be used to secure part. Does not meet requirements of Para. 3A503 of Spec NHB 5300.4 (3A).

29. NEED FOR DEVIATION/WAIVER

Circuit changes required from RCR05 to RNN55 resistors after the circuit boards were procured. As a result, pad spacing is too close in some cases to mount the component on the board surface and still meet lead minimum bend radius.

REQ J.A. Baruch SYS ENGR J.L. Esquil QA [Signature] 11/15/81
PE [Signature] 11/15/81

30. PRODUCTION EFFECTIVITY BY SERIAL NUMBER
51065 SN 003 ONLY

31. APPROVAL/RECOMMENDATION
[Signature] 11/05

32. APPROVAL/RECOMMENDATION
 APPROVED DISAPPROVED

DD FORM 1694

ORIGINAL PAGE IS
OF POOR QUALITY

STANDARD INSTRUCTIONS 010

HSP

REQUEST FOR DEVIATION/WAIVER
SEE REF. STD. 400 OR 401 FOR INSTRUCTIONS

DATE PREPARED
11/05/81

PROCURING ACTIVITY NO.

1. ORIGINATOR NAME AND ADDRESS Santa Barbara Research Center 75 Coromar Dr. Goleta, CA 93117				2. <input checked="" type="checkbox"/> DEVIATION <input type="checkbox"/> WAIVER	
3. DESIGNATION FOR DEVIATION/WAIVER				4. <input checked="" type="checkbox"/> MINOR <input type="checkbox"/> MAJOR <input type="checkbox"/> CRITICAL	
5. MODEL/TYPE Flt.	6. WFR. CODE 11323	7. SYS. DESIG. TM	8. DEV. ORDER NO. D-131	9. <input type="checkbox"/> FUNC. TIONAL <input type="checkbox"/> ALLO. CATED	10. <input checked="" type="checkbox"/> YES <input type="checkbox"/> NO
11. SPECIFICATIONS AFFECTED-TEST PLAN			12. DRAWINGS AFFECTED		
13. SYSTEM	14. WFR. CODE	15. SPEC. DOC. NO.	16. WFR. CODE	17. REV. I	18. REV. NO.
			11323	50948	E EO 3630A
19. DESCRIPTION OF DEVIATION/WAIVER Alternate component placement (no contact with board).				20. CONTRACT NO. & LINE NO. NAS5-24200	
21. IDENTIFICATION OF DEFECT Thematic Mapper Assy.				22. DEFECT NO. & DEFECT CLASSIFICATION <input checked="" type="checkbox"/> MINOR <input type="checkbox"/> MAJOR <input type="checkbox"/> CRITICAL	
23. NAME OF PART OR SUB-ASSY. Printed wiring board assy. verification resistor				24. LOT NO. 50948-E	25. QTY. 1
26. EFFECT ON COST/PRICE				27. EFFECT ON DELIVERY SCHEDULE	
28. EFFECT ON INTEGRATED LOGISTIC SUPPORT, INTERFACE, ETC.					
29. DESCRIPTION OF DEVIATION/WAIVER Need to be able to mount components off the board surface as shown on drawing. Support bonding shall be used to secure part. Does not meet requirements fo Para. 3A503 of Spec NHB 5300.4 (3A).					
30. REASON FOR DEVIATION/WAIVER Circuit changes required changes from RCR05 to RNN55 resistors after the circuit boards were procured. As a result, pad spacing is too close in some cases to mount the component on the board surface and still meet lead minimum bend radius.					

REQ CA Conach SYS ENGR *J. L. Conach* 11/5/81
 QA *[Signature]* 11/5/81
 PE *[Signature]* 11/5/81
 51065 SN 003 ONLY
J. L. Conach 811105
 Major - System Engineering
 Minor/Critical - Proposed Changes
 APPROVAL RECOMMENDED APPROVED DISAPPROVED
 DD FORM 1694

ORIGINAL PAGE IS
OF POOR QUALITY

Program Instruction 010

REQUEST FOR DEVIATION/WAIVER
(SEE MIL-STD-460 OR 481 FOR INSTRUCTIONS)

DATE PREPARED

PROCURING ACTIVITY NO.

4 JANUARY 1982

1. ORIGINATOR NAME AND ADDRESS SANTA BARBARA RESEARCH CENTER 75 COROMAR DR. GOLETA, CA. 93117				2. <input checked="" type="checkbox"/> DEVIATION <input type="checkbox"/> WAIVER	
4. DESIGNATION FOR DEVIATION/WAIVER				3. <input checked="" type="checkbox"/> MINOR <input type="checkbox"/> MAJOR <input type="checkbox"/> CRITICAL	
a. MODEL/TYPE F1	b. MFR. CODE 11323	c. SYS. DESIG. TM	d. DEV/WAIVER NO. D-133	5. BASE LINE AFFECTED <input checked="" type="checkbox"/> PURC-TIONAL <input type="checkbox"/> ALLO-CATED <input type="checkbox"/> PROD-UCT	
7. SPECIFICATIONS AFFECTED-TEST PLAN				6. OTHER SYSTEMS/CONFIGURATION ITEMS AFFECTED <input type="checkbox"/> YES <input checked="" type="checkbox"/> NO	
a. SYSTEM			b. DRAWINGS AFFECTED	10. CONTRACT NO. & LINE ITEM NAS 5-24200 #32	
b. ITEM			MFR. CODE 11323	NUMBER 51398	REV. E
c. TEST PLAN			11. CONFIGURATION ITEM NOMENCLATURE Electronics Module Assembly		
d. TITLE OF DEVIATION/WAIVER Alternate Wiring			12. CD NO. II		
13. NAME OF PART OR LARGEST ASSEMBLY AFFECTED Cal Shutter Back (A7)			14. DEFECT CLASSIFICATION <input checked="" type="checkbox"/> MINOR <input type="checkbox"/> MAJOR <input type="checkbox"/> CRITICAL		
15. PART CO. OR TYPE DESIG. 51398-E			16. DEFECT NO. 1		
17. LOT NO.			18. QUANTITY 1		
19. EFFECT ON COST/PRICE			19. RECURRING DEVIATION/WAIVER <input type="checkbox"/> YES <input checked="" type="checkbox"/> NO		
20. EFFECT ON DELIVERY SCHEDULE 5 months schedule impact if disapproved			21. EFFECT ON INTEGRATED LOGISTIC SUPPORT, INTERFACE, ETC.		
23. DESCRIPTION OF DEVIATION/WAIVER Alternate wiring (trace cuts, jumper wires and added parts) incorporated on assembly drawing to accommodate circuit design changes. Sec. 51398 assembly drawing and referenced SP80165 alternate wiring process specification attached. SEE EOs: EO 2992A 3072A Ref: W033 per EO 8703 D056 per EO 1084A D108R1					
24. NEED FOR DEVIATION/WAIVER Redesign and re-procurement of electronic circuit boards would be required in order to eliminate alternate wiring. Minimum 5 months schedule slip and considerable costs would be involved. Redesign is not considered cost effective at this time.					

23. DESCRIPTION OF DEVIATION/WAIVER
Alternate wiring (trace cuts, jumper wires and added parts) incorporated on assembly drawing to accommodate circuit design changes. Sec. 51398 assembly drawing and referenced SP80165 alternate wiring process specification attached.
SEE EOs: EO 2992A
3072A
Ref: W033 per EO 8703
D056 per EO 1084A
D108R1

24. NEED FOR DEVIATION/WAIVER
Redesign and re-procurement of electronic circuit boards would be required in order to eliminate alternate wiring. Minimum 5 months schedule slip and considerable costs would be involved. Redesign is not considered cost effective at this time.

RE: James 1/4/82
QA: W. O. Miller 1/6/82
PE: James 1/7/82

REA: G. A. Busch SYS ENGR J. H. Craig

25. PRODUCTION EFFECTIVITY BY SERIAL NUMBER
51065 SN 003 only

26. SIGNATURE AND TITLE
J. H. Craig 17 Jan 82 Minor - System Engineering
Major/Critical - Program Manager

27. APPROVAL/DISAPPROVAL
 APPROVAL RECOMMENDED APPROVED DISAPPROVED

28. GOVERNMENT ACTIVITY
NASA GSFC

SIGNATURE: Robert B. Kutt DATE: 1/21/82

ORIGINAL PAGE IS
OF POOR QUALITY

Program Instruction 010

REQUEST FOR DEVIATION/WAIVER
(SEE MIL-STD-460 OR 461 FOR INSTRUCTIONS)

DATE PREPARED
8 January 82

PROCURING ACTIVITY NO.

HIP

1. ORIGINATOR NAME AND ADDRESS SANTA BARBARA RESEARCH CENTER (HUGHES AIRCRAFT) 75 Coromar Drive, Goleta, CA 93117				2. <input checked="" type="checkbox"/> DEVIATION <input type="checkbox"/> WAIVER	
				3. <input checked="" type="checkbox"/> MINOR <input type="checkbox"/> MAJOR <input type="checkbox"/> CRITICAL	

4. DESIGNATION FOR DEVIATION/WAIVER				5. BASE LINE AFFECTED			6. OTHER SYSTEMS/CONFIGURATION ITEMS AFFECTED		
a. MODEL/TYPE F	b. MFR. CODE 11323	c. SYS. DESIG. TM	d. DEVIATION NO. D-135	<input type="checkbox"/> FUNCTIONAL	<input type="checkbox"/> ALLOCATED	<input type="checkbox"/> PRODUCT	<input type="checkbox"/> YES	<input type="checkbox"/> NO	

7. SPECIFICATIONS AFFECTED-TEST PLAN				8. DRAWINGS AFFECTED			
a. SYSTEM	b. ITEM	c. TEST PLAN	d. MFR. CODE	e. NUMBER	f. REV.	g. NDR. NO.	
			11323	50904	C		

9. TITLE OF DEVIATION/WAIVER Alternate Wiring						10. CONTRACT NO. & LINE ITEM NAS 5-24200
--	--	--	--	--	--	---

11. CONFIGURATION ITEM NOMENCLATURE Electronics Module Assembly			12. CD NO. II			13. DEFECT NO.			14. DEFECT CLASSIFICATION <input checked="" type="checkbox"/> MINOR <input type="checkbox"/> MAJOR <input type="checkbox"/> CRITICAL		
--	--	--	------------------	--	--	----------------	--	--	---	--	--

15. NAME OF PART OR LOWEST ASSEMBLY AFFECTED PWB Assy Post Amp Bands 1-4		16. PART NO. OR TYPE DESIG. 50904-3		17. LOT NO.		18. QTY -1-		19. RECURRING DEVIATION/WAIVER <input type="checkbox"/> YES <input checked="" type="checkbox"/> NO			
---	--	--	--	-------------	--	----------------	--	---	--	--	--

20. EFFECT ON COST/PRICE				21. EFFECT ON DELIVERY SCHEDULE 5 Month Schedule Impact if disapproved			
--------------------------	--	--	--	---	--	--	--

22. EFFECT ON INTEGRATED LOGISTIC SUPPORT, INTERFACE, ETC.

23. DESCRIPTION OF DEVIATION/WAIVER

Alternate wiring (added wires) to PWB assembly. Adding jumpers between R70B-U4P33, R73B-U7P56, R79A-U12P47 per SP80165, Procedure B, using item 32 of 50904.

Ref: NCMR 412474

24. NEED FOR DEVIATION/WAIVER

Redesign and reprourement of electronic circuit boards would be required in order to eliminate alternate wiring. Minimum 5 months schedule slip and considerable cost would be involved. Redesign is not considered cost effective at this time.

RE <i>Donnell</i>	QA <i>W. H. D. Jones</i>	PE <i>W. H. D. Jones</i>
REQ <i>For Action</i>	FOR <i>Donnell</i>	SYS ENGR <i>W. H. D. Jones</i>

25. PRODUCTION EFFECTIVITY BY SERIAL NUMBER

26. SUBMITTING ACTIVITY AUTHORIZING SIGNATURE <i>W. H. D. Jones</i>	TITLE Minor - System Engineering Major/Critical - Program Manager
--	---

27. APPROVAL/DISAPPROVAL

a. <input type="checkbox"/> APPROVAL RECOMMENDED	b. <input checked="" type="checkbox"/> APPROVED <input type="checkbox"/> DISAPPROVED
--	--

c. GOVERNMENT ACTIVITY NASA	SIGNATURE <i>Donnell</i>	DATE 4/9/82
--------------------------------	-----------------------------	----------------

ORIGINAL PAGE IS
OF POOR QUALITY

MATERIAL REVIEW
CONTROL ORDER

M R C O

4	1	2	4	7	4	R
---	---	---	---	---	---	---

PART NO. 509045 REVISION F

W / A

✓	0	1	2
---	---	---	---

PART NAME POSTAL P PLUG BAND 3

QUANTITY 1 S/N 201

ROUTE TO: _____

P. O. MASTER CLEARED 1 of 2

OPR NO.	INSTRUCTIONS	DATE	QTY ACC	QTY SUS	INSP OPER	COMMENTS
2274 100	1) INSTALL 30 AWG TYP M (J-W-1177) WIRE FROM R79 (A SIDE) PAD TO U12 PAD AT PIN 47 PER SP 80165. PER _____					
	2) INSTALL 30 AWG TYP M (J-W-1177) WIRE FROM R73 (B SIDE) PAD TO U7 PAD AT PIN 52 PER SP 80165. PER _____					
	3) INSTALL 30 AWG TYP M (J-W-1177) WIRE FROM R70 (B SIDE) PAD TO U4 PAD AT PIN 33 PER SP 80165 PER _____					
LAST	RETURN THIS CARD TO MATERIAL REVIEW FOR RECORD CLEARANCE.					
OPR						

SB 0344-B-1 FEB 75

CA APPROVAL [Signature] DATE _____

ENG APPROVAL _____ DATE _____

ORIGINAL PAGE IS
OF POOR QUALITY

MATERIAL REVIEW
CONTROL ORDER

M R C O


4	1	2	4	7	4	R
W	/	A	U	0	1	2

CONTINUATION SHEET
PAGE 2 OF 2

OPR NO.	INSTRUCTIONS	DATE	QTY ACC	QTY SUS	INSP OPER	COMMENTS
	4) When RECEIVING ST-AS 1, 2 & 3, REFER WORKSHEET ATTACHED TO MRCO					
57-10200	INSPECT QTY# 100 Per SP 80165 & WORKSHEET					
AF 300	MCT					
400	Return to MEB					
LAST	RETURN THIS CARD TO MATERIAL REVIEW FOR RECORD CLEARANCE.					
CPR						

ORIGINAL PAGE IS
OF POOR QUALITY

PARKSIL & L.V. MURPHY 42474 2 of 3

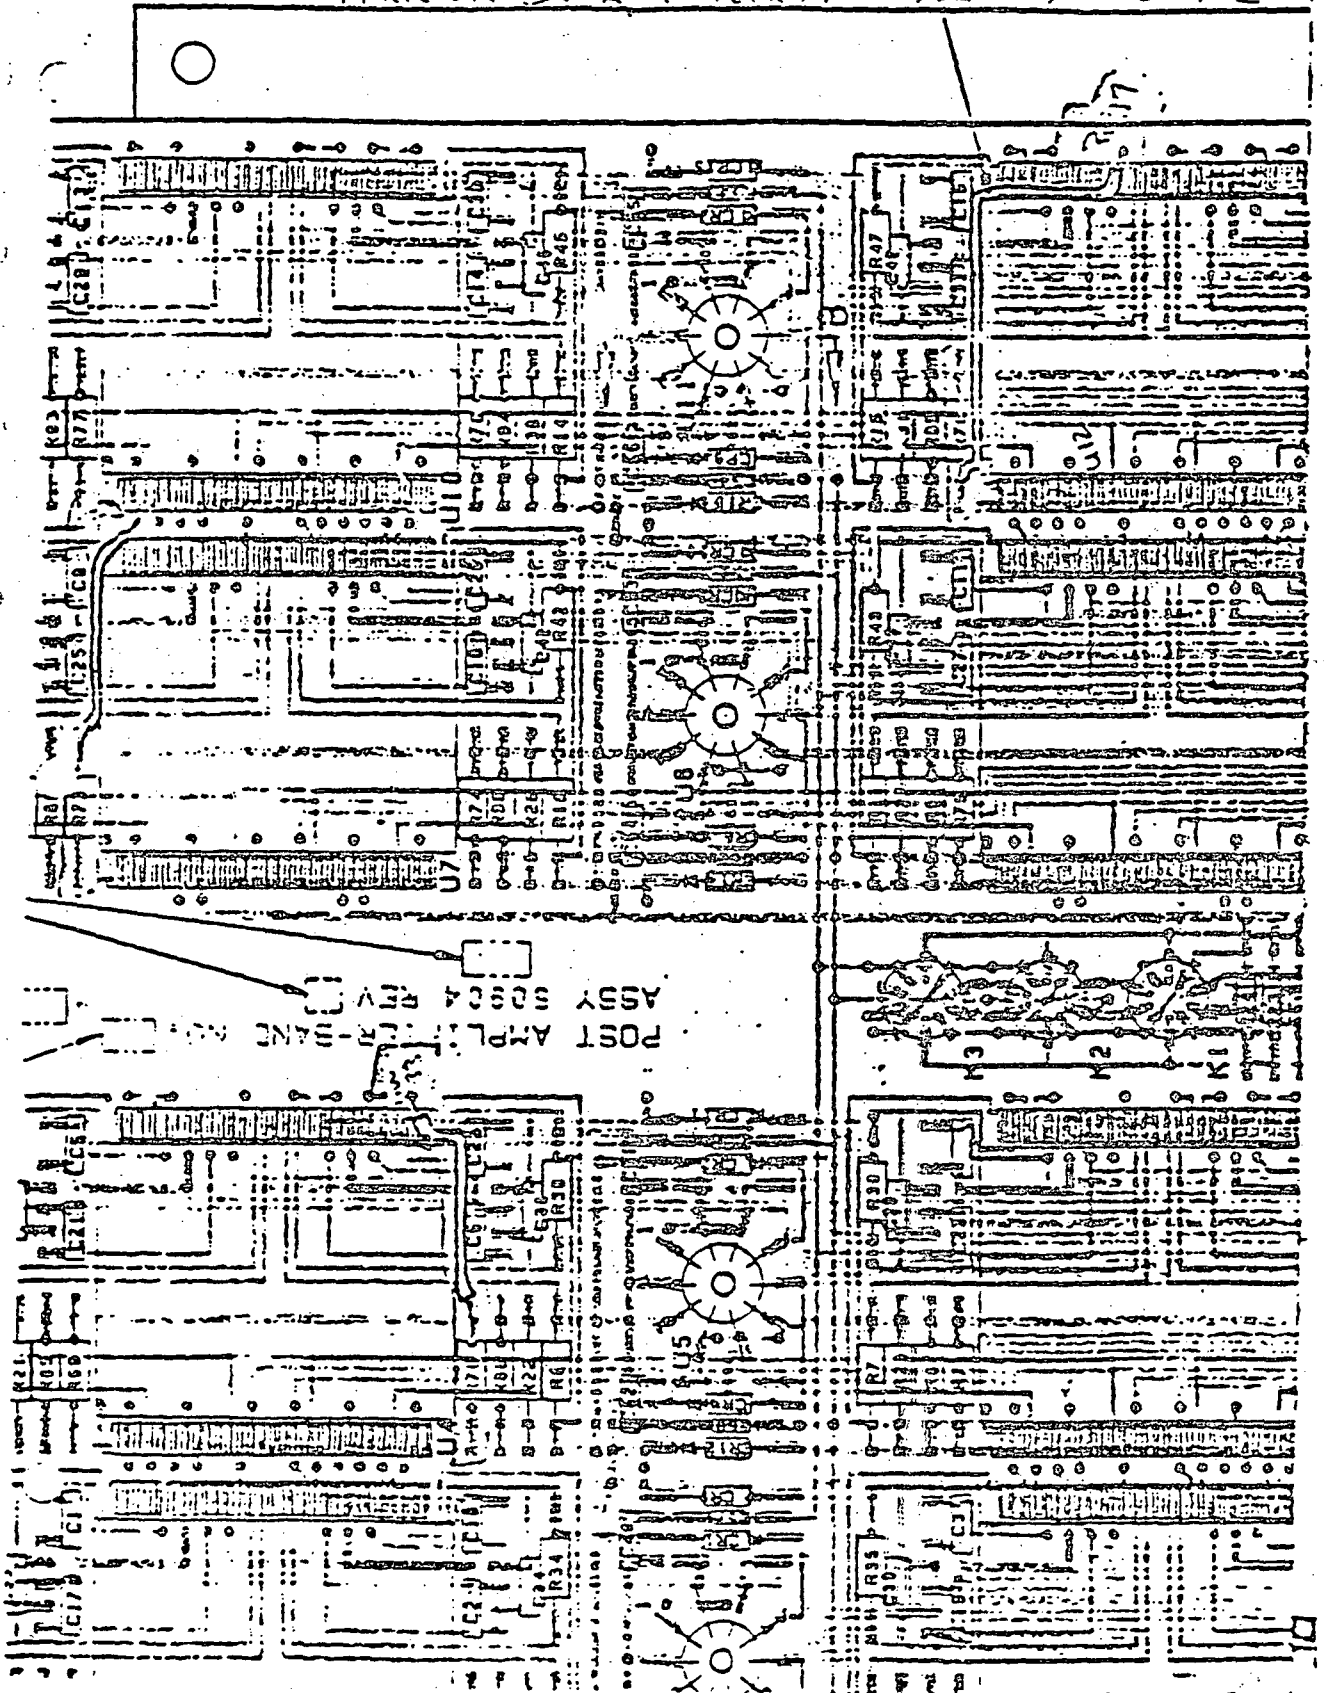

SBRC ENGINEERING ORDER / ~~REVISION NOTICE~~ NO. 3414A
SHEET 1 OF 3

DRAWING TITLE AMPLIFIER 6 & COMMAND RELAYS (A16)		DRAWING NUMBER 50912 (e)	
PROJECT NUMBER PL1162	ITEM DISPOSITION	CLASS CHANGE	DRAWING TYPE
SPECIFICITY E1005 COL & SUBS	REWORK <input checked="" type="checkbox"/> ITEMS CONFORM <input type="checkbox"/> NO ITEMS MADE <input type="checkbox"/> REJECT <input type="checkbox"/> USE <input type="checkbox"/> NOT APPLICABLE <input type="checkbox"/>	<input type="checkbox"/> I <input checked="" type="checkbox"/> A <input type="checkbox"/> II	<input type="checkbox"/> A <input checked="" type="checkbox"/> B
DESCRIPTION OF CHANGE		AUTHORIZING ECR NUMBER	
THIS EO CANCELS AND SUPERSEDES EOs 3291A & 3414A		TFA 2402/01	

- IN LM, CHANGED PN, ITEM 16
 IS: 908611-204 RESISTOR, 13, 1%, 2W
 WAS: 908665-23 RESISTOR, 22, 5%, 1/8W

- IN LM, ADDED ITEMS *1 THRU *26
- | | | | | |
|--------|-------------|-------|------------------------------------|----|
| 2 REQD | 908606-1 | 22577 | TRANSISTOR, PNP, NPN (2N3752) | *1 |
| 1 | 908678-135 | | RESISTOR, 2.49, 1%, 1W | *2 |
| 1 | 908678-126 | | RESISTOR, 2.00, 1%, 1W | *3 |
| 2 | 908555-186 | 22577 | CAPACITOR, 10UF, 10%, 50V | *4 |
| 8 | SC80181-8-2 | | PAD PATTERN | *5 |
| 2 | NAS1291C3 | | NUT, SELF-LOCK, 190-32 (NAS1291) | *6 |
| 2 REQD | NAS620C10 | | WASHER FLAT, No. 10 (NAS620) | *7 |
| AR | J-W-1177/14 | | WIRE, INSUL; AWG 26, J-W-1177 TYPE | *8 |

- IN GENERAL NOTES, ADDED:
 *9 INSTALL COMPONENTS, PAD PATTERNS AND WIRE PER SP20165, PROCEDURE C.

- IN COMPONENT IDENT TABLE, ADDED
 Q1, 2 ITEM *1
 R29 ITEM *2
 R30 ITEM *3
 C23, 24 ITEM *4

* NOTE AND/OR ITEM NUMBER TO BE ASSIGNED AT TIME OF INCORPORATION

DESIGNED BY CE	DATE 7-20-61	QUALITY APPROVAL <i>[Signature]</i>	DATE 7-20-61	RELEASED BY
CHECKED BY	DATE	MANUFACTURING APPROVAL	DATE	INCORPORATED
SEAL/ESA APPROVAL	DATE	PROJECT APPROVAL <i>[Signature]</i>	DATE 5/19/70	DRAWING REV LETTER

DO NOT STATUS THIS PRINT
 UNTIL ORDER OR REVISION IS
 RECEIVED
 JUL 21 1961
 USE THIS PRINT
 REVISION 12: THRU 1


ORIGINAL PAGE IS
OF POOR QUALITY

SENC ENGINEERING ORDER / REVISION NOTICE NO. 3457
CODE IDENT 11373 SHEET 2

DRAWING TITLE PRINTED WIRING BOARD ASSY
AMPLIFIER 6 & COMMAND RELAYS (A16)

DRAWING NUMBER 50912 (2)

DESCRIPTION OF CHANGE
5. ON F/D, SH3, ZONE 3 D
ADDED Q1-2, R29-30, C23-24 & PAD PATTERNS;
RELOCATED R11-12.

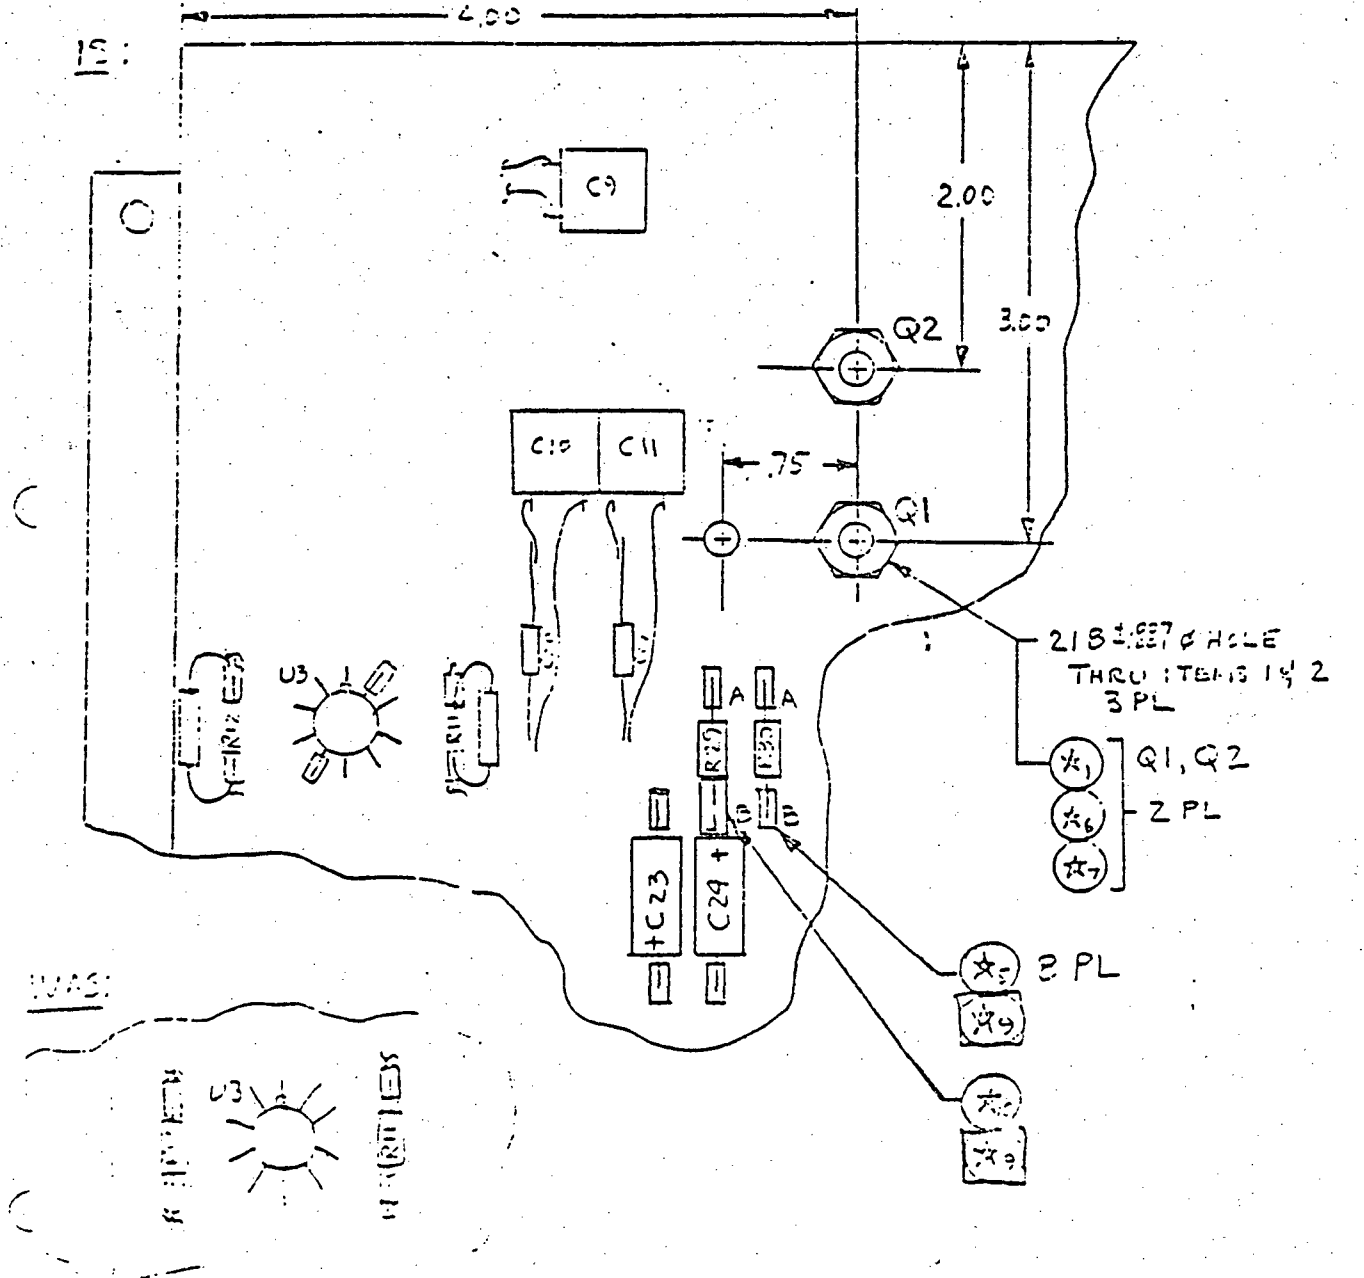

ORIGINAL PAGE IS
OF POOR QUALITY

SEPCO ENGINEERING ORDER / ~~REVISION NOTICE~~ NO. PL1162A
SHEET 1 OF 3

PROJECT TITLE: PRINTED WIRING BOARD ASSY
AMPLIFIER 6 & COMMAND RELAYS (A16) DRAWING NUMBER: 50912 (2)

PROJECT NUMBER <u>PL1162</u>	ITEM DISPOSITION REWORK <input checked="" type="checkbox"/> ITEMS CONFORM <input type="checkbox"/> NO ITEMS MADE <input type="checkbox"/> REJECT <input type="checkbox"/> USE <input type="checkbox"/> NOT APPLICABLE <input type="checkbox"/>	CLASS CHANGE <input type="checkbox"/> I <input checked="" type="checkbox"/> A	DRAWING TYPE <input type="checkbox"/> A <input type="checkbox"/> B
EFFECTIVITY <u>31005</u>		AUTHORIZING ECR NUMBER <u>TR 4422/01</u>	

DESCRIPTION OF CHANGE
3 EO CANCELS AND SUPERSEDES EOs 3291A & 3414A

- IN LM, CHANGED PN, ITEM 18
IS: 908611-204 RESISTOR, 13, 1%, 2W
WAS: 908665-23 RESISTOR, 22, 5%, 1/8W

- IN LM, ADDED ITEMS *1 THRU *8

2 REQD	908606-1	22577	TRANSISTOR, PNP, NPN (2N3752)	*1
	908678-135		RESISTOR, 2.49, 1%, 1W	*2
	908678-126		RESISTOR, 2.00, 1%, 1W	*3
	908555-186	22577	CAPACITOR, 10NF, 10%, 50V	*4
8	SC80181-8-2		PAD PATTERN	*5
2	NAS1291C3		NUT, SELF-LKG, 190-32 (NAS1291)	*6
2 REQD	NAS620C10		WASHER FLAT, No. 10 (NAS620)	*7
AR	J-W-1177/14		WIRE, INSUL, AWG 26, J-W-1177, TYPE M	*8

- IN GENERAL NOTES, ADDED:
 INSTALL COMPONENTS, PAD PATTERNS AND WIRE PER SP20165, PROCEDURE C.

- IN COMPONENT IDENT TABLE, ADDED
Q1, 2 ITEM *1
R29 ITEM *2
R30 ITEM *3
C23, 24 ITEM *4

* NOTE AND/OR ITEM NUMBER TO BE ASSIGNED AT TIME OF INCORPORATION

DESIGNED BY <u>...</u>	DATE <u>7-20-61</u>	QUALITY APPROVAL <u>[Signature]</u>	DATE <u>7-20-61</u>	RELEASED BY <u>...</u>
CHECKED BY <u>...</u>	DATE <u>...</u>	MANUFACTURING APPROVAL <u>...</u>	DATE <u>...</u>	INCORPORATED <u>...</u>
DESIGNER'S APPROVAL <u>[Signature]</u>	DATE <u>7-20-61</u>	PROJECT APPROVAL <u>[Signature]</u>	DATE <u>7-20-61</u>	DRAWING REV LETTER <u>...</u>

REVISION STATUS THIS PRINT
NOT MAINTAINED AFTER
JUL 21 1961
DO NOT USE THIS PRINT
UNLESS IN ORIGINAL OR IN REVISION
FORMS ONLY

ORIGINAL PAGE IS
OF POOR QUALITY

Asw 2/1/82
Supply

Program Instruction 010

File

REQUEST FOR DEVIATION/WAIVER
(SEE MIL-STD-480 OR 481 FOR INSTRUCTIONS)

DATE PREPARED

14 January 1982

PROCESsing ACTIVITY NO.

1. ORIGINATOR NAME AND ADDRESS Santa Barbara Research Center 75 Coromar Dr., Goleta, Ca 93117				2. <input checked="" type="checkbox"/> DEVIATION <input type="checkbox"/> WAIVER	
4. DESIGNATION FOR DEVIATION/WAIVER				3. <input checked="" type="checkbox"/> MINOR <input type="checkbox"/> MAJOR <input type="checkbox"/> CRITICAL	
6. MODEL/TYPE F1	8. MFR. CODE 11323	9. SYS. DESIG. TM	4. DESIGNED NO. D137	5. BASE LINE AFFECTED <input type="checkbox"/> FUNC-TIONAL <input type="checkbox"/> ALLO-CATED <input checked="" type="checkbox"/> PROD-UCT	
7. SPECIFICATIONS AFFECTED-TEST PLAN			6. OTHER SYSTEMS/CONFIGURATION ITEMS AFFECTED <input type="checkbox"/> YES <input type="checkbox"/> NO		
8. SYSTEM			8. DRAWINGS AFFECTED		
9. TEST PLAN			10. CONTRACT NO. & LINE ITEM		
11. CONFIGURATION ITEM NOMENCLATURE Radiometer			12. CD NO. II		
13. NAME OF PART OR LATEST ASSEMBLY AFFECTED PWB Cal Shutter Backup			14. DEFECT NO. E		
15. MFR. CODE 51398			16. QTY 1		
17. LOT NO. F1			18. REQUIRES DEVIATION/WAIVER <input type="checkbox"/> YES <input checked="" type="checkbox"/> NO		
19. EFFECT ON COST/PRICE			20. EFFECT ON DELIVERY SCHEDULE		
21. EFFECT ON INTEGRATED LOGISTIC SUPPORT, INTERFACE, ETC.					
22. DESCRIPTION OF DEVIATION/WAIVER					

Alternate wiring and added component required per SP80165.
See EO 4031A.
This action will insure that Timing Jitter in the Phase Control Loop of the Redundant Shutter does not occur.

23. NEED FOR DEVIATION/WAIVER

It has been observed that under special conditions which are possible during operation that Redundant Shutter timing signals can move out of tolerance. E.O. 4031A corrects this problem completely. Redesign and reprourement of 51398 PWB would be required to eliminate alternate wiring. Minimum 5 month schedule slip and considerable cost would be involved.

REQ *J.A. Banach* 1/14/82 SYS ENGR *John J. Cordover* 1/14/82
QA *J.H. Brandon* 1-14-82
PE *George B. Lunt* 1/14/82

24. PRODUCTION EFFECTIVITY BY SERIAL NUMBER

25. SUBMITTING ACTIVITY AUTHORIZING SIGNATURE
J.H. Brandon *John J. Cordover*
Minor - System Engineering
Major/Critical - Program Manager

26. APPROVAL/DISAPPROVAL

APPROVAL RECOMMENDED

APPROVED

DISAPPROVED

27. GOVERNMENT ACTIVITY

SIGNATURE

DATE

NASA GSFC

George B. Lunt 1/15/82

DD FORM 1694 DEC 68

111080

Program Instruction 010

REQUEST FOR DEVIATION/WAIVER
(SEE MIL-STD-460 OR 461 FOR INSTRUCTIONS)

DATE PREPARED

16 April 1982

PROCURING ACTIVITY NO. *1-10*

1. ORIGINATOR NAME AND ADDRESS Santa Barbara Research Center Div. of Hughes Aircraft Co., 75 Coromar Dr., Goleta, CA 93117				2. <input checked="" type="checkbox"/> DEVIATION <input type="checkbox"/> WAIVER	
				3. <input checked="" type="checkbox"/> MINOR <input type="checkbox"/> MAJOR <input type="checkbox"/> CRITICAL	
4. DESIGNATION FOR DEVIATION/WAIVER				5. BASE LINE AFFECTED	
a. MODEL/TYPE Flt. I	b. MFR. CODE	c. SYS. DESIG. TM	d. DEVIATION NO. D-147	<input type="checkbox"/> FUNCTIONAL <input type="checkbox"/> ALLOCATED <input type="checkbox"/> PRODUCT <input type="checkbox"/> YES <input checked="" type="checkbox"/> NO	
7. SPECIFICATIONS AFFECTED-TEST PLAN				8. DRAWINGS AFFECTED	
a. SYSTEM				MFR. CODE	
b. ITEM				NUMBER 51398	
c. TEST PLAN				REV.	
d. MFR. CODE				NO. NO.	
9. TITLE OF DEVIATION/WAIVER Soldering of two resistors to R130 pads.				10. CONTRACT NO. & LINE ITEM NAS 5-24200	
11. CONFIGURATION ITEM NOMENCLATURE 51398 PWB Assy Cal Shutter Backup (A7)				12. CD NO.	
13. DEFECT NO.				14. DEFECT CLASSIFICATION <input checked="" type="checkbox"/> MINOR <input type="checkbox"/> MAJOR <input type="checkbox"/> CRITICAL	
15. NAME OF PART OR LOCUS AFFECTED A7 PWB		16. PART NO. OR TYPE DESIGNATION 51398-E		17. LOT NO.	
18. QTY.		19. REQUIRING DEVIATION/WAIVER <input type="checkbox"/> YES <input checked="" type="checkbox"/> NO		20. EFFECT ON COST/PRICE None.	
21. EFFECT ON DELIVERY SCHEDULE 2 months if not approved.		22. EFFECT ON INTEGRATED LOGISTIC SUPPORT, INTERFACE, ETC.			

23. DESCRIPTION OF DEVIATION/WAIVER

Request permission to use select resistors (R130 and R130 B, 698 ohm each) outside of select range list (52732-23). Also request permission to use two resistors instead of one in order to satisfy power derating criteria for the resistors. See dra attached.

ORIGINAL PAGE IS
OF POOR QUALITY

24. NEED FOR DEVIATION/WAIVER

Mechanical adjustment of symmetry is not possible without a minimum of two months schedule delay, so we want to use electrical adjustments instead. The required value of resistance is not on the select list. The power rating is too low for the new resistance value required; therefore, two 698 ohm 1/10 watt resistors are needed.


REQA <i>NI Current</i> 4/16/82	RE <i>[Signature]</i>
SYS ENGR <i>[Signature]</i>	QA <i>[Signature]</i>
PE <i>[Signature]</i>	PE <i>[Signature]</i>

25. SUBMITTING ACTIVITY AUTHORIZING SIGNATURE <i>[Signature]</i> for J Engr 4/16/82	TITLE Minor - System Engineering Major/Critical - Program Manager
--	---

27. APPROVAL/DISAPPROVAL	
<input type="checkbox"/> APPROVAL RECOMMENDED	<input checked="" type="checkbox"/> APPROVED <input type="checkbox"/> DISAPPROVED

26. GOVERNMENT ACTIVITY NASA ASFC	SIGNATURE <i>[Signature]</i>	DATE 4/16/82
--------------------------------------	---------------------------------	-----------------

ORIGINAL PAGE IS
OF POOR QUALITY

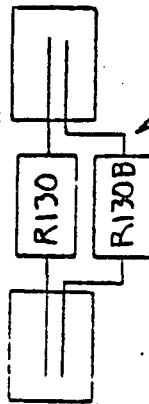

LEAD
BEND RADI:
TO BE IN
ACCORDANCE
WITH NHB 5300.4(3)

(TW)
4/19/82

Program Instruction 010A

REPORT FOR DEVIATION/CHANGE
(SEE 44-50-409 OF 481 FOR INSTRUCTIONS)

DATE PREPARED

4 May 1982

Review
5/6/82

P-H-V

1. DEVELOPER NAME AND ADDRESS Santa Barbara Research Center 75 Coronar Drive, Goleta CA 93117				<input checked="" type="checkbox"/> EXISTING <input type="checkbox"/> NEW <input type="checkbox"/> CRITICAL	
2. IDENTIFICATION FOR DEVIATION/CHANGE				3. BASIC LINE AFFECTED	
a. MODEL/TYPE PLT-1	b. CDR. CODE 11323	c. CDR. CODE TH	d. DRAWING NO. D-150	<input type="checkbox"/> REVISION <input type="checkbox"/> ADD-ON <input checked="" type="checkbox"/> LATE	4. OTHER SYSTEMS/CORRELATED ITEMS AFFECTED <input type="checkbox"/> YES <input checked="" type="checkbox"/> NO
7. SPECIFICATIONS AFFECTED-TEST PLAN				8. GRADINGS AFFECTED	
a. TEST PLAN				b. CDR. CODE 11323	c. GRADE 50942
9. TITLE OF DEVIATION/CHANGE Alternate Wiring				10. CONTRACT NO. & LINE ITEM N/A	
11. CUSTOMER'S ITEM NAME Printed Circuit Board Assembly				11. QTY. II	12. QTY. CLASSIFICATION <input checked="" type="checkbox"/> CRITICAL <input type="checkbox"/> MAJOR <input type="checkbox"/> MINOR
13. NAME OF PART OR SUBASSEMBLY AFFECTED Temp Controller		14. PART NO. OR PART GROUP 50942		15. QTY. 1	16. REASON FOR DEVIATION/CHANGE <input type="checkbox"/> YES <input checked="" type="checkbox"/> NO
17. IMPACT TO SCHEDULE None				18. IMPACT TO COST 9 months schedule impact if disapproved	
19. DESCRIPTION OF DEVIATION/CHANGE Alternate wiring (wire jumper/splice and added parts) incorporated on Assembly drawing to accommodate circuit design change. See 50942 assembly drawing and referenced SP 80165 alternate wiring process specification and EO 4343A (does not conform to NHB S300.4(3A) para. 3A402-4)					

ORIGINAL PAGE IS
OF POOR QUALITY

Redesign and re-procurement of electronic circuit board would be required in order to eliminate alternate wiring. Minimum 9 months schedule slip and considerable cost would be involved. Redesign is not considered cost effective at this time.

RE *[Signature]* 5/6/82
QA *[Signature]* 5/6/82

REA *NJC* 5/6/82, Sys Engr *[Signature]* 5/6/82, PE *[Signature]* 5-6-82

16. IDENTIFY AUTHORITY ORIGINATING DEVIATION
[Signature]
Title: Minor - system engineering
Major/Critical - Program Manager

17. APPROVAL/DISAPPROVAL
 APPROVED
 DISAPPROVED

18. DEVELOPER SIGNATURE
NASA GSFC
[Signature] 5/6/82

DD FORM 1694

GPO: 1979 - 445-100/018

Program Instruction 010

ORIGINAL PAGE IS OF POOR QUALITY

REQUEST FOR DEVIATION/WAIVER (SEE MIL-STD-460 OR 461 FOR INSTRUCTIONS)

DATE PREPARED

7/7/82

PROCURING ACTIVITY NO.

1. ORIGINATOR NAME AND ADDRESS
SANTA BARBARA RESEARCH CENTER, 75 Coromar Drive, Goleta, California 93117

2. DEVIATION WAIVER
3. MINOR MAJOR CRITICAL

4. DESIGNATION FOR DEVIATION/WAIVER
a. MODEL/TYPE: Flight I
b. MFR. CODE: 11323
c. SYS. DESIG.: TM
d. DEVIATED NO.: D-159
5. BASE LINE AFFECTED
 FUND. ALLG. PROD. YES NO

7. SPECIFICATIONS AFFECTED - TEST PLAN
a. SYSTEM
b. ITEM
c. TEST PLAN
8. DRAWINGS AFFECTED
a. MFR. CODE: 11323
b. NUMBER: 50904
c. REV.: G
d. NOR. NO.: 4072A

9. TITLE OF DEVIATION/WAIVER
Alternate Wiring
10. CONTRACT NO. & LINE ITEM
NAS 5-24200 Item 32

11. CONFIGURATION ITEM NUMBER AND PART NO.
Electronics Module Assembly
12. IS NO.: II
13. DEFECT NO.:
14. DEFECT CLASSIFICATION
 MINOR MAJOR CRITICAL

15. NAME OF PART OR LOWEST ASSEMBLY AFFECTED
PWB PostAmp Band 1
16. PART NO. OR TYPE DESIGNATION
50904-1/G
17. LOT NO.:
18. QTY: 1
19. RECORDING DEVIATION/WAIVER
 YES NO

20. EFFECT ON COST/PRICE
None
21. EFFECT ON DELIVERY SCHEDULE
8 mos. schedule impact, if disapproved

22. EFFECT ON INTEGRATED LOGISTIC SUPPORT, INTERFACE, ETC.
None

23. DESCRIPTION OF DEVIATION/WAIVER
BAND 1
Alternate wiring (added 16 resistors per PWB) incorporated an assembly drawing to accommodate circuit design change. See assembly drawing (EO 4515A) and referenced SP80165 alternate wiring process specification. Added resistors to eliminate coherent noise per SR5779.

24. NEED FOR DEVIATION/WAIVER
Redesign and re-procurement of electronic circuit boards would be required in order to eliminate alternate wiring. Minimum 8 months' schedule slip and considerable cost would be involved. Redesign is not considered cost effective at this time.

25. APPROVALS
REQ: [Signature] 7/7/82
SYS ENGR: [Signature]
QA: [Signature] 7/7/82
PS: [Signature]

26. PRODUCTION EFFECTIVITY BY SERIAL NUMBER
51065 S/N 003 only.
27. APPROVAL/DISAPPROVAL
Minor - System Engineering
Major/Critical - Program Manager

28. APPROVAL/RECOMMENDED
 APPROVAL RECOMMENDED APPROVED DISAPPROVED
29. GOVERNMENT ACTIVITY
NASA CSFC
30. SIGNATURE
George B. Britt 7/16/82
DD FORM 1694

ELECTRONIC MODULE -

533 X7

ORIGINAL PAGE IS OF POOR QUALITY

HUGHES

HUGHES AIRCRAFT COMPANY

SPACE AND COMMUNICATION GROUP

FAILURE REPORT

F 0606

1. PROGRAM NAME AND NUMBER HS 236		2. CLA	3. MODE FLIGHT	TIME OBSERVED 1100	4. DATE OBSERVED 3 28 80
5. HADDOABLE LEVEL WHEN FAILURE WAS OBSERVED		<input type="checkbox"/> SPACECRAFT	<input type="checkbox"/> SUBSYSTEM	<input type="checkbox"/> ASSEMBLY	<input type="checkbox"/> MODULE
		<input type="checkbox"/> SYSTEM	<input type="checkbox"/> UNIT	<input type="checkbox"/> SUBASSEMBLY	<input type="checkbox"/> MCCAS
				<input checked="" type="checkbox"/> CARD	<input type="checkbox"/> PART
6. EQUIPMENT IDENTIFICATION					
7. SUBSYSTEM		NAME		PART NUMBER	MANUFACTURER
8. UNIT					
9. <input type="checkbox"/> ASSEMBLY <input type="checkbox"/> SUBASSEMBLY					
10. <input type="checkbox"/> MODULE <input type="checkbox"/> MCCAS <input checked="" type="checkbox"/> CARD		POSTAMP 6 & CMD. RELAY A 50912		201	HAC
11. OTHER					
12. TEST WHEN FAILURE WAS OBSERVED		<input type="checkbox"/> DEVELOPMENT	<input type="checkbox"/> QUALIFICATION	<input type="checkbox"/> INTEGRATION	<input type="checkbox"/> LAUNCH OPERATIONS
		<input type="checkbox"/> REPRODUCTION	<input checked="" type="checkbox"/> ACCEPTANCE	<input type="checkbox"/> SYSTEM	<input type="checkbox"/>
13. ENVIRONMENT WHEN FAILURE WAS OBSERVED		<input checked="" type="checkbox"/> AMBIENT	<input type="checkbox"/> RADIATION	<input type="checkbox"/> TEMPERATURE	<input type="checkbox"/> THERMAL VAC
		<input type="checkbox"/> OSC/SH	<input type="checkbox"/> VIBRATION	AXIS FOR _____	WEL AT _____
14. DESCRIPTION OF FAILURE		STEP 16 MEASURES INFINITE, INSTEAD OF 10K. STEP 35 AND STEP 36 MEASURE INFINITE, INSTEAD OF 10K.			
15. TEST PROCEDURE		16368	4.2.2	16. ORIGINATOR	NILE PATTY 22013
				DATE	3-25-80
17. VERIFICATION AND FAILURE ANALYSIS		SCHEMATIC 50913 REV C INDICATES THE RESISTOR IN STEP 16 IS NO LONGER USED AND R-9 IN STEP 35 IS NO LONGER CONNECTED. TEST PROCEDURE WILL BE E.O.D TO BRING UP TO SCHEMATIC LEVEL.			
18. FOLLOWING REWORK/TEST REQUIRED OR NONE/TEST NOT REQUIRED (SCALE)		NO DEFECT IN HARDWARE. TEST SPEC 16368 IN RECOR.			
19. FAILED ITEM NAME AND PART NUMBER		N/A.			
20. AUTHORIZATION		McC		DATE	3-25-80
21. REWORK/TEST ACTION TAKEN					
22. LIST ALL PARTS REPLACED					
23. REWORK BY		ORG	24. REQUESTED BY	ORG	DATE
25. CAUSE AND CORRECTIVE ACTION		TEST SPEC 16368 WAS IN ERROR E.O 9732 DATED 4-24-80 CHANGED PROCEDURE.			
26. FAILURE TYPE		27. FAILURE CLASSIFICATION		28. FAILURE MODE	
<input type="checkbox"/> PRIMARY <input type="checkbox"/> INDUCED <input type="checkbox"/> UNKNOWN <input checked="" type="checkbox"/> NO FAILURE		<input type="checkbox"/> DESIGN <input type="checkbox"/> TEST EQUIP <input type="checkbox"/> MFG. PROCEDURE <input type="checkbox"/> ASSEMBLY ERROR <input type="checkbox"/> WORKMANSHIP <input type="checkbox"/> WIRING ERROR <input type="checkbox"/> ROUGH HANDLING <input type="checkbox"/> WEAR-OUT <input type="checkbox"/> UNKNOWN <input type="checkbox"/> DEFECT CODE		<input type="checkbox"/> CRITICAL <input type="checkbox"/> MAJOR <input type="checkbox"/> MINOR <input type="checkbox"/> SAFETY	
29. RESPONSIBLE ENGINEER		ORG	DATE	30. SPACECRAFT SYSTEM ENG. DATE	
30. RELIABILITY		ORG	DATE	31. CUSTOMER OR SUPPLIER DATE	

ORIGINAL PAGE IS
OF POOR QUALITY



SPACE AND COMMUNICATION GROUP
FAILURE REPORT

F 0622

1. PROGRAM NAME AND NUMBER HS 236TM		2. GLA		3. MODEL FL		4. TIME OBSERVED 4 PM		5. DATE OBSERVED 5 8 80	
6. HARDWARE LEVEL WHEN FAILURE WAS OBSERVED <input type="checkbox"/> SPACECRAFT <input type="checkbox"/> SYSTEM		<input type="checkbox"/> SUBSYSTEM <input type="checkbox"/> UNIT		<input type="checkbox"/> ASSEMBLY <input type="checkbox"/> SUBASSEMBLY		<input type="checkbox"/> MODULE <input type="checkbox"/> MECAM		<input checked="" type="checkbox"/> PCARD <input type="checkbox"/> PART	
EQUIPMENT IDENTIFICATION:									
7. SUBSYSTEM		NAME		PART NUMBER		SN		MANUFACTURER	
8. LIGHT									
9. <input type="checkbox"/> ASSEMBLY <input type="checkbox"/> SUBASSEMBLY									
10. <input type="checkbox"/> MODULE <input type="checkbox"/> MECAM <input checked="" type="checkbox"/> PCARD POSTAMP BOARD 2									
		50904-2		2.01		HAC			
11. OTHER									
12. TEST WHEN FAILURE WAS OBSERVED		<input type="checkbox"/> DEVELOPMENT <input type="checkbox"/> IN PROGRESS		<input checked="" type="checkbox"/> QUALIFICATION <input checked="" type="checkbox"/> ACCEPTANCE		<input type="checkbox"/> INTEGRATION <input type="checkbox"/> SYSTEM		<input type="checkbox"/> LAUNCH OPERATIONS	
13. ENVIRONMENT WHEN FAILURE WAS OBSERVED		<input checked="" type="checkbox"/> AMBIENT <input type="checkbox"/> EMC/RFI		<input type="checkbox"/> RADIATION <input type="checkbox"/> VIBRATION		<input type="checkbox"/> TEMPERATURE AXIS FOR _____ MIN TYPE _____		<input type="checkbox"/> THERMAL VAC REQ. AT _____	
14. DESCRIPTION OF FAILURE ALL 16 CHANNELS EXCEED MAX GAIN OF 20 DB FOR MAX BOOST ABOVE THE 100 H_z GAIN.									
15. TEST PROCEDURE 16368		4.3.8		16. ORIGINATOR N. PATTY		22.13		DATE 5/6-80	
17. CONTINUATION SHEET USED <input checked="" type="checkbox"/>									
18. VERIFICATION AND FAILURE ANALYSIS									
19. FAILED ITEM NAME AND PART NUMBER NONE									
20. FOLLOWING REMARK/RETEST REQUIRED REMARK/RETEST NOT REQUIRED BECAUSE RESOLUTION OF FAILURE TO BE ACCOMPLISHED BY CHANGING TOLERANCE OF TEST PROCEDURE 16368 PAR 4.3.8 WITH AN E.O.									
21. AUTHORIZATION									
22. ORG									
23. DATE									
24. CONTINUATION SHEET USED									
25. REMARK/RETEST ACTION TAKEN NO RETEST REQUIRED BECAUSE ORIGINAL SPECS WERE TOO STRINGENT. FAILURE CURED BY E.O.									
26. QA RETEST									
27. LIST ALL PARTS REPLACED									
28. PART NUMBER									
29. QTY									
30. PART LOT NO.									
31. DATE CODE									
32. MFG									
33. PROBABLE DEFECT									
34. ANALYSIS NO.									
35. REMARK BY									
36. ORG									
37. DATE									
38. RETESTED BY									
39. ORG									
40. DATE									
41. CONTINUATION SHEET USED									
42. CAUSE AND CORRECTIVE ACTION THIS IS NOT A FAILURE - OP									
43. E.O. 9897 CHANGES SPEC. MAX GAIN ALLOWED IS NOW 26 db. MAX TEST GAIN WAS 21.6 db. TEST DATA SHEETS ATTACHED									
44. 33. PRO CLOSURE									
45. CONTINUATION SHEET USED									
46. DOCUMENT IMPLEMENTING CORRECTIVE ACTION									
47. BASIC CAUSE OF VERIFIED FAILURE		<input type="checkbox"/> DESIGN <input type="checkbox"/> ENVIRONMENTAL <input type="checkbox"/> DEFECTIVE PARTS		<input checked="" type="checkbox"/> TEST EQUIP. <input checked="" type="checkbox"/> TEST PROC. <input checked="" type="checkbox"/> TEST SET-UP		<input type="checkbox"/> MFG. PROCEDURE <input type="checkbox"/> ASSEY/PAS ERROR <input type="checkbox"/> WORKMANSHIP		<input type="checkbox"/> WIRING ERROR <input type="checkbox"/> ROUGH HANDLING <input type="checkbox"/> WEAR-OUT	
48. FAILURE TYPE		<input type="checkbox"/> PRIMARY <input type="checkbox"/> INDUCED		<input type="checkbox"/> UNKNOWN <input checked="" type="checkbox"/> NO FAILURE		49. FAILURE CLASSIFICATION		<input type="checkbox"/> CRITICAL <input type="checkbox"/> MAJOR <input type="checkbox"/> MINOR <input type="checkbox"/> SAFETY	
50. DEFECT CODE		51. RESPONSIBLE ENGINEER SS M.M. RANDALL		52. JRG 21.23		53. DATE 9-17-80		54. SPACECRAFT SYSTEM ENGR SS S.G. DIXLEY	
55. JRG 51.41		56. DATE 9-18-80		57. JRG 40-92		58. DATE 4-19-80		59. CUSTOMER OR SUPPLIER HS	

ORIGINAL PAGE IS
OF POOR QUALITY

HUGHES

HUGHES AIRCRAFT COMPANY

SPACE AND COMMUNICATION GROUP
FAILURE REPORT

F 1666

1. PROGRAM NAME AND NUMBER V011		2. GLA	3. MODEL FLT	4. TIME OBSERVED A.M.	5. DATE OBSERVED JULY 21, 1981
6. HARDWARE LEVEL WHEN FAILURE WAS OBSERVED <input type="checkbox"/> SPACECRAFT <input type="checkbox"/> SUBSYSTEM <input checked="" type="checkbox"/> ASSEMBLY <input type="checkbox"/> MODULE <input type="checkbox"/> CARD <input type="checkbox"/> SYSTEM <input type="checkbox"/> UNIT <input checked="" type="checkbox"/> MECHANISM <input type="checkbox"/> PART					
EQUIPMENT IDENTIFICATION: NAME PART NUMBER SIN MANUFACTURER					
7. SUBSYSTEM					
8. UNIT					
9. <input checked="" type="checkbox"/> ASSEMBLY <input type="checkbox"/> SUBASSEMBLY BAND 4 POST AMP Bd. 5090 G-X 401 SBRG					
10. <input type="checkbox"/> MODULE <input type="checkbox"/> MECHANISM <input type="checkbox"/> CARD					
11. OTHER					
12. TEST WHEN FAILURE WAS OBSERVED <input type="checkbox"/> DEVELOPMENT <input type="checkbox"/> QUALIFICATION <input type="checkbox"/> INTEGRATION <input type="checkbox"/> LAUNCH OPERATIONS <input type="checkbox"/> IN-PROCESS <input checked="" type="checkbox"/> ACCEPTANCE <input type="checkbox"/> SYSTEM					
13. ENVIRONMENT WHEN FAILURE WAS OBSERVED <input type="checkbox"/> ACCIDENT <input type="checkbox"/> RADIATION <input checked="" type="checkbox"/> TEMPERATURE 15 °C <input type="checkbox"/> THERMAL VAC <input type="checkbox"/> HRS. AT _____ ° <input type="checkbox"/> SHOCK/PSI <input type="checkbox"/> VIBRATION _____ ANIS FOR _____ MIN TYPE _____ OTHER _____					
14. DESCRIPTION OF FAILURE CHANNELS 1, 2, 4, 5, 6, 7, 9, 10, 11, 12, 13, 14, 15 & 16 FAIL TO MEET TRANSIENT AND/OR FREQUENCY RESPONSE REQUIREMENTS AFTER SELECT RESISTORS MOVED FROM STANDOFFS TO BOARD.					
15. TEST PROCEDURE 16597		16. ORIGINATOR N. C. DAVIS	17. ORG 2213	18. DATE 7-21-81	19. CONTINUATION SHEET USED
18. VERIFICATION AND FAILURE ANALYSIS					
19. FAILURE ITEM NAME AND PART NUMBER					
20. <input checked="" type="checkbox"/> FOLLOWING REWORK/RETEST REQUIRED <input type="checkbox"/> REWORK/RETEST NOT REQUIRED EXCEPT TEMPORARILY PLACE BOOST & ROLLOFF RESISTORS ON STANDOFFS. MEASURE RESISTANCE VALUES, TRANSIENT & FREQUENCY RESPONSE (R11-R16 AND R15-R20)					
21. AUTHORIZATION D.M. RANNEY ORG 1723 DATE 7-22-81 CONTINUATION SHEET USED					
22. REWORK/RETEST ACTION TAKEN Correction was done with tubing modification from FPA and an improved flow of H₂ was established to feed the FPA. The improvement is a result of retubing listed on FR 18317. No correction to any components.					
23. LIST ALL PARTS REPLACED					
24. CAUSE AND CORRECTIVE ACTION Morator was condensing on the FPA being select stating due to inadequate H₂ gas flow on the FPA. No flow had been increased and is now directed to FPA.					
25. DOCUMENT IMPLEMENTING CORRECTIVE ACTION 12-23-81					
26. BASIC CAUSE OF VERIFIED FAILURE <input type="checkbox"/> DESIGN <input type="checkbox"/> TEST EQUIP <input type="checkbox"/> MFG. PROCEDURE <input type="checkbox"/> WIRING ERROR <input type="checkbox"/> UNKNOWN <input type="checkbox"/> ENVIRONMENTAL <input type="checkbox"/> TEST PROC. <input type="checkbox"/> ASSY/FAB ERROR <input type="checkbox"/> ROUGH HANDLING <input type="checkbox"/> DEFECT CODE <input type="checkbox"/> DEFECTIVE PARTS <input checked="" type="checkbox"/> TEST SET UP <input type="checkbox"/> WORKMANSHIP <input type="checkbox"/> WEAR/OUT					
27. FAILURE TYPE <input type="checkbox"/> PRIMARY <input type="checkbox"/> UNKNOWN <input type="checkbox"/> NO FAILURE <input type="checkbox"/> FAILURE CLASSIFICATION <input type="checkbox"/> CRITICAL <input checked="" type="checkbox"/> MINOR <input type="checkbox"/> SAFETY					
28. RESPONSIBLE ENGINEER D. M. Ranney		29. DATE 7/22/81	30. SPACECRAFT SYSTEM ENGR J. L. Long	31. DATE 7/21/81	32. CUSTOMER OR SUPPLIER 96
33. RELIABILITY 10 CARD DRG SI-41 DATE 12-18-81					

ORIGINAL PAGE IS
OF POOR QUALITY



SPACE AND COMMUNICATION GROUP
FAILURE REPORT

F 1667

1. PROGRAM NAME AND NUMBER <i>TM, HS 236</i>		2. GLA	3. MODEL <i>F17</i>	4. TIME OBSERVED <i>9:00A</i>	5. DATE OBSERVED <i>9 21 81</i>
6. HARDWARE LEVEL WHEN FAILURE WAS OBSERVED <input type="checkbox"/> SPACECRAFT <input type="checkbox"/> SUBSYSTEM <input checked="" type="checkbox"/> ASSEMBLY <input type="checkbox"/> MODULE <input type="checkbox"/> CARD <input type="checkbox"/> SYSTEM <input type="checkbox"/> UNIT <input type="checkbox"/> SUBASSEMBLY <input type="checkbox"/> INCAP <input type="checkbox"/> PART					
EQUIPMENT IDENTIFICATION:					
7. SUBSYSTEM		NAME		PART NUMBER	S/N
8. UNIT					
9. <input checked="" type="checkbox"/> ASSEMBLY <input type="checkbox"/> SUBASSEMBLY		<i>PWR ASSY-Motor Driver, Colder Door</i>		<i>53877</i>	<i>101</i>
10. <input type="checkbox"/> MODULE <input type="checkbox"/> INCAP <input type="checkbox"/> CARD					
11. OTHER					
12. TEST WHEN FAILURE WAS OBSERVED <input type="checkbox"/> DEVELOPMENT <input type="checkbox"/> QUALIFICATION <input type="checkbox"/> INTEGRATION <input type="checkbox"/> LAUNCH OPERATIONS <input type="checkbox"/> IN-PROCESS <input checked="" type="checkbox"/> ACCEPTANCE <input type="checkbox"/> SYSTEM					
13. ENVIRONMENT WHEN FAILURE WAS OBSERVED <input checked="" type="checkbox"/> AMBIENT <input type="checkbox"/> RADIATION <input type="checkbox"/> TEMPERATURE _____ ° _____ THERMAL VAC _____ HRS. AT _____ <input type="checkbox"/> EMC/RFI <input type="checkbox"/> VIBRATION _____ AXIS FOR _____ MIN TYPE _____ OTHER _____					
14. DESCRIPTION OF FAILURE <i>Adjusted Mod 2005 Voltage reference to -1.500V, output was +5.628V and should be ±0.3V.</i>					
15. TEST PROCEDURE <i>16237</i>		16. PART <i>13.3.2.1</i>	18. ORIGINATOR <i>E. Aasted</i>	19. DATE <i>7-20-81</i>	20. CONTINUATION SHEET USED
18. VERIFICATION AND FAILURE ANALYSIS <i>Open Circuit on pin 4 of AR1, AR2, and AR3 where an incomplete "cut and jump" had been reworked per EO 2762A. Added resistors were soldered to traces to cut instead of to pad. No overstressed components.</i>					
19. FAILED ITEM NAME AND PART NUMBER					
22. FOLLOWUP REPORT/RETEST REQUIRED <input type="checkbox"/> REPORT/RETEST REQUIRED <input checked="" type="checkbox"/> REPORT/RETEST NOT REQUIRED BECAUSE <i>Rework to Print 53877 and EO 2762A</i>					
21. AUTHORIZATION <i>E. Aasted</i>					
22. CONTINUATION SHEET USED					
23. REWORK/RETEST ACTION TAKEN <i>Reworked to EO 2762A</i>					
24. FUNCTIONAL TEST <i>Functional Test per 16237 - Rev F</i>					
25. LIST ALL PARTS REPLACED					
PART NUMBER					
NONE					
27. REWORK BY <i>Hortencia Sanchez</i>					
DATE <i>9/21/81</i>					
28. RETESTED BY <i>E. Aasted</i>					
DATE <i>22-13</i>					
29. DATE <i>9-22-81</i>					
30. CAUSE AND CORRECTIVE ACTION <i>EO 2762A was not correctly implemented. More careful initial visual check prior to test will identify this problem in future. Mr. Jim Duncan was informed of this problem and his instructions his permission to review current work closely to prevent wires from being wired to wrong terminations.</i>					
31. PRECLOSURE <i>[Signature]</i> <i>10/15/81</i>					
32. DOCUMENT IMPLEMENTING CORRECTIVE ACTION <i>EO 2762A</i>					
33. BASIC CAUSE OF VERIFIED FAILURE <input type="checkbox"/> DESIGN <input type="checkbox"/> TEST EQUIP <input type="checkbox"/> MFG. PROCEDURE <input type="checkbox"/> WIRING ERROR <input type="checkbox"/> UNKNOWN <input type="checkbox"/> ENVIRONMENTAL <input type="checkbox"/> TEST PROC. <input checked="" type="checkbox"/> ASSY/PKG ERROR <input type="checkbox"/> ROUGH HANDLING <input type="checkbox"/> DEFECT CODE <input type="checkbox"/> DEFECTIVE PARTS <input type="checkbox"/> TEST SET-UP <input type="checkbox"/> WORKMANSHIP <input type="checkbox"/> WEAR-OUT					
34. FAILURE TYPE <input type="checkbox"/> PRIMARY <input type="checkbox"/> UNKNOWN <input checked="" type="checkbox"/> NO FAILURE <input type="checkbox"/> INDUCED					
35. FAILURE CLASSIFICATION <input type="checkbox"/> CRITICAL <input type="checkbox"/> MINOR <input type="checkbox"/> SAFETY <input checked="" type="checkbox"/> MAJOR					
37. RESPONSIBLE ENGINEER <i>A. Bonatti</i>					
DATE <i>22-13</i>					
38. SPACECRAFT SYSTEM ENGR <i>[Signature]</i>					
DATE <i>9-28-81</i>					
39. RELIABILITY <i>A. Weber</i>					
DATE <i>10-5-81</i>					
40. CUSTOMER OR SUPPLIER <i>[Signature]</i>					
DATE <i>10-16-81</i>					

ORIGINAL PAGE IS
OF POOR QUALITY



SPACE AND COMMUNICATION GROUP
FAILURE REPORT

F 1668

1. PROGRAM NAME AND NUMBER TM, HS-236		2. GL	3. MODEL F14	4. TIME OBSERVED 9:00A	5. DATE OBSERVED 11/18/81	MO	DA	YR
6. HARDWARE LEVEL WHEN FAILURE WAS OBSERVED <input type="checkbox"/> SPACECRAFT <input type="checkbox"/> SYSTEM		<input type="checkbox"/> SUBSYSTEM <input type="checkbox"/> UNIT	<input checked="" type="checkbox"/> ASSEMBLY <input type="checkbox"/> SUBASSEMBLY	<input type="checkbox"/> MODULE <input type="checkbox"/> MICAM	<input type="checkbox"/> CARD <input type="checkbox"/> PART			
EQUIPMENT IDENTIFICATION:								
7. SUBSYSTEM			PART NUMBER		S/N	MANUFACTURER		
8. UNIT								
9. <input checked="" type="checkbox"/> ASSEMBLY <input type="checkbox"/> SUBASSEMBLY		PWJ ASSY, Temp. Control		50920	101	SBRC		
10. <input type="checkbox"/> MODULE <input type="checkbox"/> MICAM <input type="checkbox"/> CARD								
11. OTHER								
12. TEST WHEN FAILURE WAS OBSERVED <input type="checkbox"/> DEVELOPMENT <input type="checkbox"/> IN-PROCESS		<input type="checkbox"/> QUALIFICATION <input checked="" type="checkbox"/> ACCEPTANCE	<input type="checkbox"/> INTEGRATION <input type="checkbox"/> SYSTEM	<input type="checkbox"/> LAUNCH OPERATIONS				
13. ENVIRONMENT WHEN FAILURE WAS OBSERVED <input checked="" type="checkbox"/> AMBIENT <input type="checkbox"/> PROCR/PI		<input type="checkbox"/> RADIATION <input type="checkbox"/> VIBRATION	<input type="checkbox"/> TEMPERATURE AXIS FOR	<input type="checkbox"/> MIN	<input type="checkbox"/> TYPE	<input type="checkbox"/> THERMAL VAC	HRS. AT	
14. DESCRIPTION OF FAILURE Mean resistance of values determined is 4.32 and 4.33 is not within specification limits, nor is it capable of being corrected per 10.1.5.3. Mean Value is 12.77KΩ Should Be 10.41KΩ								
15. TEST PROCEDURE 16236		PARA 4.3.4	16. OPERATOR E. Aasted	ORG 12213	DATE 11/18/81	17. CONTINUATION SHEET USE		
18. VERIFICATION AND FAILURE ANALYSIS Reworked To Print. R2 was 12.7KΩ instead of 12.7KΩ per print. R68 in a similar circuit was reworked as well. No overstress on any components.								
19. FOLLOWING REWORK/RETEST REQUIRED				19. FAILED ITEM NAME AND PART NUMBER R2 and R68.				
20. <input checked="" type="checkbox"/> REWORK/RETEST NOT REQUIRED BECAUSE Retesting already written in planning.								
21. AUTHORIZATION E. Aasted				ORG 122-13	DATE 11/18/81	22. CONTINUATION SHEET USED		
23. REWORK/RETEST ACTION TAKEN R2 and R68 removed and replaced with components per 50920 assembly print. Para 4.3 successfully performed.								
24. LIST ALL PARTS REPLACED								
PART NUMBER	CAT SYM	PART LOT NO	DATE CODE	MFR	POSSIBLE DEFECT	ANALYSIS NO.		
25. REWORK BY M. Guerra								
ORG 122-74		DATE 11/18/81	26. RETESTED BY E. Aasted		ORG 122-13	DATE 11/18/81	27. CONTINUATION SHEET USED	
28. CAUSE AND CORRECTIVE ACTION Assy component placement error. THE VALUE OF THE INSTALLED RESISTOR WAS HIGHER THAN PRINT CALLOUT. THIS RESISTOR IS IN SERIES WITH A 10K RESISTOR. THE POWER DISSIPATED ACROSS THE RESISTORS, V^2/R, WAS REDUCED, THEREBY ELIMINATING THE POSSIBILITY OF OVERSTRESS. TECHNICIANS HAVE BEEN CAUTIONED TO CHECK THAT PROPER VALUES ARE KITTED.								
29. DOCUMENT IMPLEMENTING CORRECTIVE ACTION								
30. BASIC CAUSE OF VERIFIED FAILURE <input checked="" type="checkbox"/> DESIGN <input type="checkbox"/> ENVIRONMENTAL <input type="checkbox"/> DEFECTIVE PARTS		<input type="checkbox"/> TEST EQUIP <input type="checkbox"/> TEST PROC. <input type="checkbox"/> TEST SET-UP	<input type="checkbox"/> MFG. PROCEDURE <input checked="" type="checkbox"/> ASSY/FAB ERROR <input type="checkbox"/> WORKMANSHIP	<input type="checkbox"/> WIRING ERROR <input type="checkbox"/> ROUGH HANDLING <input type="checkbox"/> WEAR-OUT	<input type="checkbox"/> UNKNOWN DEFECT CODE			
31. FAILURE TYPE <input checked="" type="checkbox"/> PRIMARY <input type="checkbox"/> INDUCED		<input type="checkbox"/> UNKNOWN <input type="checkbox"/> NO FAILURE	32. FAILURE CLASSIFICATION <input type="checkbox"/> CRITICAL <input type="checkbox"/> MAJOR		<input checked="" type="checkbox"/> MINOR <input type="checkbox"/> SAFETY			
33. PERSONNEL INVOLVED A.A. Banach			ORG 122-13	DATE 11/21/81	34. SPACECRAFT SYSTEM ENG Change to Eng 1		ORG SBRC	DATE 12/2/81

Handwritten signature
6/2/11

ORIGINAL PAGE IS
OF POOR QUALITY

11/17/81
101
1

DATE F/1668
SER NO.
SET NO.

SMA HEATER CONTROLLERS

- 4.3.1 + 80 V Line Current ✓ (≤ 1.0 mA) LED IS ON OK (OK)
 + 28 V Line Current ✓ (≤ 1.0 mA)
 + 21 V Line Current 22.96 mA (25 ± 10 mA)
 - 21 V Line Current 2.92 mA (5 ± 4 mA)
- 4.3.2 + 80 V Line current ✓ (≤ 1.0 mA)
 + 28 V Line Current 10.99 mA ($800/1000/1300 \pm 150$ mA)
 + 21 V Line Current 2.3 mA (25 ± 10 mA)
 - 21 V Line Current 2.9 mA (5 ± 4 mA)
 R1 12.8K Ω +Z HEATER 27.18V +Z COMP 1.39V +Z RET .32V TOGGLE OK (OK)
- 4.3.3 R2 10.337K Ω +Z HEATER 0.0V +Z COMP .271V +Z RET 28.11V
- 4.3.4 Mean (R1 + R2)/2 10.354K Ω (10.41 K Ohms ± 84 Ohms)
 Difference (R1 - R2) 45 Ω (210 Ohms maximum)
- 4.3.5 + 80 V Line Current ✓ (≤ 1.0 mA) LED IS OFF OK (OK)
 + 28 V Line Current ✓ (≤ 1.0 mA)
 + 21 V Line Current ✓ (≤ 1.0 mA)
 - 21 V Line Current ✓ (≤ 1.0 mA)
- 4.3.6 + 80 V Line Current ✓ (≤ 1.0 mA) LED IS ON OK (OK)
 + 28 V Line Current ✓ (≤ 1.0 mA)
 + 21 V Line Current 18.65 mA (25 ± 10 mA)
 - 21 V Line Current 2.7 mA (5 ± 4 mA)
- 4.3.7 + 80 V Line Current ✓ (≤ 1.0 mA)
 + 28 V Line Current 11.30 mA ($800/1000/1300 \pm 150$ mA)
 + 21 V Line Current 14.6 mA (25 ± 10 mA)
 - 21 V Line Current 2.9 mA (5 ± 4 mA)
 R1 10.3924K Ω -Z HEATER 27.18V -Z COMP 2.333V -Z RET .291V TOGGLE ✓ (OK)
- 4.3.8 R2 10.309K Ω -Z HEATER 0.001 -Z COMP .269V -Z RET 28.14V
- 4.3.9 Mean (R1 + R2)/2 10.345K Ω (10.41 K Ohms ± 84 Ohms)
 Difference (R1 - R2) 73 Ω (210 Ohms maximum)
- 4.3.10 + 80 V Line Current ✓ (≤ 1.0 mA) LED IS OFF OK (OK)
 + 28 V Line current ✓ (≤ 1.0 mA)
 + 21 V Line Current ✓ (≤ 1.0 mA)
 - 21 V Line Current ✓ (≤ 1.0 mA)



SIZE	CODE IDENT NO.	NUMBER
A	11323	16297
SCALE	REV D	SHEET 6

PART NO. 50920		PART NAME PWB ASSY, Temperature Control		ASSY/LOT SERIAL NO. 101	QTY
OPER NO.	DATE	OPERATOR OR INSP	COMMENTS, TEST DATA, ETC	DISPOSITION	APPROVAL
1520	11/18/81	E. Hastad	1) Lift one leg of R2 for a measurement of its resistance. Refer to ER 1668. 2) Return to test for trouble shooting.	P.L. Driffler R-2-	J. Miller
			RETURN TO MFG. ENG.		
1520	11/18/81	E. Hastad	Lifted one leg of R2 Rework to print R2 and R68	P.L. Driffler R-2-	J. Miller
	11-18-81		both are 12.7K Ω and should be 10.7K Ω .		
	11-18-81	Pienna	replaced R2 & R68		
1520	11/18/81	E. Hastad	R Change select nominals as follows: R302 From: 287 Ω To: 523 Ω R ¹²⁷ 127 From: 287 Ω To: 487 Ω per ^{para} 10.1.5.3 of spec 16236		
	11/19/81	Sanchez	Reworked above		
1520	11/18/81	(E) Hastad	Change select nominals as follows: R102 From: 523 Ω To: 619 Ω spec 16236 per 10.1.5.3 R127 From: 487 Ω To: 590 Ω spec 16236 per 10.1.5.3 R45 From: 18.2K Ω To: 17.8K Ω spec 16236 per 10.1.6.3		
	11/19/81	Sanchez	Changed above nominals		

ORIGINAL PAGE IS OF POOR QUALITY

E 1668

ORIGINAL PAGE IS
OF POOR QUALITY



SPACE AND COMMUNICATION GROUP
FAILURE REPORT

F 1761

1. PROGRAM NAME AND NUMBER HS 236 TM		2. GLA		3. MODEL PT-7		4. TIME OBSERVED 1530		5. DATE OBSERVED 2 27 80	
6. HARDWARE LEVEL WHEN FAILURE WAS OBSERVED		<input type="checkbox"/> SPACECRAFT		<input type="checkbox"/> SUBSYSTEM		<input type="checkbox"/> ASSEMBLY		<input type="checkbox"/> MODULE	
		<input type="checkbox"/> SYSTEM		<input type="checkbox"/> UNIT		<input checked="" type="checkbox"/> SUBASSEMBLY		<input type="checkbox"/> MICAM	
7. SUBSYSTEM		NAME		PART NUMBER		S/N		MANUFACTURER	
8. UNIT									
9. <input type="checkbox"/> ASSEMBLY <input checked="" type="checkbox"/> SUBASSEMBLY		POST AMP-BAND 1		50904-1 A		101		HAC	
10. <input type="checkbox"/> MODULE <input type="checkbox"/> MICAM <input type="checkbox"/> CARD									
11. OTHER									
12. TEST WHEN FAILURE WAS OBSERVED		<input type="checkbox"/> DEVELOPMENT <input checked="" type="checkbox"/> IN-PROCESS		<input type="checkbox"/> QUALIFICATION <input checked="" type="checkbox"/> ACCEPTANCE		<input type="checkbox"/> INTEGRATION <input type="checkbox"/> SYSTEM		<input type="checkbox"/> LAUNCH OPERATIONS	
13. ENVIRONMENT WHEN FAILURE WAS OBSERVED		<input checked="" type="checkbox"/> AMBIENT <input type="checkbox"/> RADIATION		<input type="checkbox"/> TEMPERATURE		<input type="checkbox"/> THERMAL VAC		HRS. AT	
		<input type="checkbox"/> EMC/RFI <input type="checkbox"/> VIBRATION		AXIS FOR		MIN		TYPE	
14. DESCRIPTION OF FAILURE		OFFSET LIMITS OUT OF SPEC ON ELEVEN CHANNELS							
15. TEST PROCEDURE		16597 4 PARA 4		16. ORIGINATOR		NILE PATTY		17. CONTINUATION SHEET USED	
18. VERIFICATION AND FAILURE ANALYSIS									
19. ENGINEERING EVALUATION									
20. FOLLOWING REMOVAL/RETEST REQUIRED REMOVE/RETEST NOT REQUIRED BECAUSE		This failure occurred when this PUB wasn't hardware. That PUB was replaced by SN 201 and SN 101 became flight. This PUB has had DC offset subject determined and tested on the flight and had no problem as well.		21. AUTHORIZATION		W.M. Randall		22. DATE	
23. REMOVAL/RETEST ACTION TAKEN		DC offset subject redetermined on flight Band 1 Band 2 and 3. Tests within specification. No over stress of any components.						24. CAUSE	
								11/19/81	
25. LIST ALL PARTS REPLACED		PART NUMBER		CXT SYM		PART LOT NO.		DATE CODE	
								MFR	
								PROBABLE DEFECT	
								ANALYSIS NO.	
27. REMOVED BY		ORG		DATE		28. RETESTED BY		ORG	
								DATE	
29. CAUSE AND CORRECTIVE ACTION		could not be accomplished until flight Band 1 Band 2 and 3 was available. THE FLIGHT PUB (SN 201) WAS USED FOR P.F. BECAUSE OF SCHEDULE CONSIDERATIONS. SELFS FOR THIS CURRENT FLIGHT PUB (SN 101) HAD TO BE REDETERMINED TO BE COMPATIBLE WITH BAND 2 PREAMP TO MEET SPEC. REPAIRS. NO CORRECTIVE ACTION BEING		30. FAILURE CLOSURE					
31. DOCUMENT IMPLEMENTING CORRECTIVE ACTION									
32. BASIC CAUSE OF VERIFIED FAILURE		<input type="checkbox"/> DESIGN <input type="checkbox"/> ENVIRONMENTAL <input type="checkbox"/> DEFECTIVE PARTS		<input type="checkbox"/> TEST EQUIP <input type="checkbox"/> TEST PROC. <input type="checkbox"/> TEST SET-UP		<input checked="" type="checkbox"/> MFG. PROCEDURE <input type="checkbox"/> ASSY/FAB ERROR <input type="checkbox"/> WORKMANSHIP		<input type="checkbox"/> WIRING ERROR <input type="checkbox"/> ROUGH HANDLING <input type="checkbox"/> WEAR-OUT	
33. FAILURE TYPE		<input type="checkbox"/> PRIMARY <input checked="" type="checkbox"/> INDUCED		<input type="checkbox"/> UNKNOWN <input checked="" type="checkbox"/> NO FAILURE		34. FAILURE CLASSIFICATION		<input type="checkbox"/> CRITICAL <input checked="" type="checkbox"/> MAJOR <input type="checkbox"/> MINOR <input type="checkbox"/> SAFETY	
35. RESPONSIBLE ENGINEER		W.M. Randall		36. SPACECRAFT SYSTEM ENGR		J. J. ...		DATE	
37. RESPONSIBILITY		ORG		DATE		38. CUSTOMER SUPPLIER		DATE	
		S-41		11/19/81		22-41		1/19/81	

ORIGINAL PAGE IS
OF POOR QUALITY

HUGHES

HUGHES AIRCRAFT COMPANY

SPACE AND COMMUNICATION GROUP
FAILURE REPORT

F 1769

1. PROGRAM NAME AND NUMBER HS 236		2. CLA	3. MODEL FLIGHT	4. TIME OBSERVED 1500	5. DATE OBSERVED 3/25/80
6. HARDWARE LEVEL WHEN FAILURE WAS OBSERVED <input type="checkbox"/> SPACECRAFT <input type="checkbox"/> SUBSYSTEM <input type="checkbox"/> ASSEMBLY <input type="checkbox"/> MODULE <input checked="" type="checkbox"/> CARD <input type="checkbox"/> SYSTEM <input type="checkbox"/> UNIT <input type="checkbox"/> SUBASSEMBLY <input type="checkbox"/> MICAM <input type="checkbox"/> PART					
EQUIPMENT IDENTIFICATION:					
7. SUBSYSTEM		NAME		PART NUMBER	S/N
8. UNIT					
9. <input type="checkbox"/> ASSEMBLY <input type="checkbox"/> SUBASSEMBLY BAND 4 POST AMP					
10. <input type="checkbox"/> MODULE <input type="checkbox"/> MICAM <input checked="" type="checkbox"/> CARD				50904-23	201 HAC
11. OTHER				QA	
12. TEST WHEN FAILURE WAS OBSERVED <input type="checkbox"/> DEVELOPMENT <input type="checkbox"/> IN PROGRESS <input type="checkbox"/> QUALIFICATION <input type="checkbox"/> INTEGRATION <input type="checkbox"/> LAUNCH OPERATIONS <input type="checkbox"/> ACCEPTANCE <input type="checkbox"/> SYSTEM					
13. ENVIRONMENT WHEN FAILURE WAS OBSERVED <input type="checkbox"/> AMBIENT <input type="checkbox"/> RADIATION <input type="checkbox"/> TEMPERATURE <input type="checkbox"/> THERMAL VAC <input type="checkbox"/> HRS. AT <input type="checkbox"/> ELEC/RFI <input type="checkbox"/> VIBRATION <input type="checkbox"/> AXIS FOR <input type="checkbox"/> MIN <input type="checkbox"/> TYPE					
14. DESCRIPTION OF FAILURE CHANNEL SEVEN SINGLE ENDED OUTPUT IS REDUCED 7.2 DB WHEN VAL IS DISCONNECTED. S.1 DB WHEN VAL IS DISCONNECTED. SHOULD BE 6 ± 0.5 DB.					
15. TEST PROCEDURE 16368 PAR 4.3.6		16. ORIGINATOR NILE PATTY 27		17. ORG 13	18. DATE 3/26/80
19. VERIFICATION AND FAILURE ANALYSIS CHANNEL SEVEN SINGLE ENDED OUTPUT UNWARRANTY DEFECT. RECOMMEND REPLACEMENT OF U3. CONFIGURATION DID NOT VARY FROM POINT. NO OUT OF SPEC POWER WAS APPLIED, THEREFORE NO ELECTRICAL STRESS COULD HAVE BEEN INDUCED.					
20. FOLLOWING REWORK/RETEST REQUIRED REWORK/RETEST NOT REQUIRED BECAUSE		19. FAILED ITEM NAME AND PART NUMBER 50857-4 4C4679-04		20. CONTINUATION SHEET USED	
21. AUTHORIZATION <i>[Signature]</i>		ORG 13		DATE 3-26-80	
22. REWORK/RETEST ACTION TAKEN U3 Replaced and retested per 16368 Par 4.3.6 ATTACHED AHR SHOWS SUCCESSFUL COMPLETION OF 16368 ON 4-1-80.		23. QA NETWORK		24. QA RETEST	
25. LIST ALL PARTS REPLACED					
PART NUMBER	QTY SYN	PART LOT NO.	DATE CODE	WPR	PROBABLE DEFECT
27. REWORK BY		ORG	DATE	28. RETESTED BY	ORG
29. CAUSE AND CORRECTIVE ACTION See attached memo HS-236-6824					
30. HYBRID PASSES ACCEPTANCE TEST PROCEDURE BUT FAILS TO PERFORM PROPERLY IN CIRCUIT. SUSPECT BUILDUP OF TOLERANCES. CHANGE OF HYBRID CORRECTS CIRCUIT ANOMALY.					33. FRB CLOSURE <i>[Signature]</i> 1/27/81
32. DOCUMENT IMPLEMENTING CORRECTIVE ACTION					
34. BASIC CAUSE OF VERIFIED FAILURE <input type="checkbox"/> DESIGN <input type="checkbox"/> TEST EQUIP <input type="checkbox"/> MFG. PROCEDURE <input type="checkbox"/> WIRING ERROR <input type="checkbox"/> UNKNOWN DEFECT CODE <input type="checkbox"/> ENVIRONMENTAL <input type="checkbox"/> TEST PROC. <input type="checkbox"/> ASSEMBLY ERROR <input type="checkbox"/> ROUGH HANDLING <input checked="" type="checkbox"/> DEFECTIVE PARTS <input type="checkbox"/> TEST SET-UP <input type="checkbox"/> WORKMANSHIP <input type="checkbox"/> WEAR-OUT					
35. FAILURE TYPE <input checked="" type="checkbox"/> PRIMARY INDUCED <input type="checkbox"/> UNKNOWN <input type="checkbox"/> NO FAILURE		36. FAILURE CLASSIFICATION <input type="checkbox"/> CRITICAL <input type="checkbox"/> MINOR <input type="checkbox"/> SAFETY		<input checked="" type="checkbox"/> MAJOR	
37. RESPONSIBLE ENGINEER <i>[Signature]</i>		ORG 21-23	DATE 6/25/80	38. SPACECRAFT SYSTEM ENGINEER <i>[Signature]</i>	
39. RELIABILITY <i>[Signature]</i>		ORG 5191	DATE 6-25-80	40. CUSTOMER OR SUPPLIER SRRC	

F1769

THEMATIC MAPPER	HUGHES AIRCRAFT COMPANY FULLERTON MICROELECTRONIC TEST DATA SHEET	DATE: 12/31/9	
1950599-100		PAGE 1	OF 2
P/N: 50859-4		P.O. No.	
Date Code & S/N 4679-B4		POST AMPLIFIER	SPEC NO.: 1E075

Paragraph No	Results				Limits & Conditions
	Pre Burn-In		Final Elect.		
	CHA	CHB	CHA	CHB	
13.1	<u>Power</u>				
I +15	<u>1.67 ma</u>	<u>1.61 ma</u>	<u>1.68 ma</u>	<u>1.61 ma</u>	< 2 ma
I -15	<u>1.67 ma</u>	<u>1.60 ma</u>	<u>1.69 ma</u>	<u>1.62 ma</u>	< 2 ma
13.2	<u>Preamp Bias</u>				
PL	<u>-4.95 v</u>	<u>-4.93 v</u>	<u>-4.95 v</u>	<u>-4.93 v</u>	-5 ± 10% volts
13.3	<u>Input Balance</u>				
1H + 1L	<u>0.5 mv</u>	<u>0.4 mv</u>	<u>0.6 mv</u>	<u>0.4 mv</u>	3.0 mv p-p 100Hz - 100KHz max.
13.4	<u>Low Frequency Gain</u>				
CH - OL 100Hz	<u>9.5 dB</u>	<u>9.3 dB</u>	<u>9.5 dB</u>	<u>9.3 dB</u>	9.7 ± 1 dB
OH + OL	<u>-43 dB</u>	<u>-31 dB</u>	<u>-42 dB</u>	<u>-31 dB</u>	Min. -20dB below CH - OL
13.5	<u>Frequency Response and</u>				
13.6	<u>Common Mode Rejection</u>				
OH - OL 5KHz	<u>4.2 dB</u>	<u>4.2 dB</u>	<u>4.2 dB</u>	<u>4.0 dB</u>	+4/+5dB ref. 100Hz Gain
OH + OL	<u>-36 dB</u>	<u>-32 dB</u>	<u>-35 dB</u>	<u>-31 dB</u>	Min. -20dB below CH - OL
OH - OL 10KHz	<u>9.5 dB</u>	<u>9.3 dB</u>	<u>9.7 dB</u>	<u>8.5 dB</u>	+8/+10dB ref. 100Hz Gain
OH + OL	<u>-32 dB</u>	<u>-33 dB</u>	<u>-35 dB</u>	<u>-33 dB</u>	Min. -20dB below CH - OL
OH - OL 20KHz	<u>14.9 dB</u>	<u>13.8 dB</u>	<u>14.1 dB</u>	<u>13.8 dB</u>	+13/+15dB ref. 100Hz Gain
CH + OL	<u>-38 dB</u>	<u>-36 dB</u>	<u>-38 dB</u>	<u>-35 dB</u>	Min. -20dB below OH - OL
OH - OL 40KHz	<u>18.7 dB</u>	<u>18.4 dB</u>	<u>18.9 dB</u>	<u>18.6 dB</u>	+17/+20dB ref. 100Hz Gain
OH + OL	<u>-28 dB</u>	<u>-33 dB</u>	<u>-29 dB</u>	<u>-33 dB</u>	Min. -20dB below CH - OL
OH - OL 50KHz	<u>18.6 dB</u>	<u>18.5 dB</u>	<u>19.1 dB</u>	<u>18.8 dB</u>	+17/+20dB ref. 100Hz Gain
OH + OL	<u>-25 dB</u>	<u>-32 dB</u>	<u>-25 dB</u>	<u>-31 dB</u>	Min. -20dB below CH - OL

ORIGINAL PAGE IS
OF POOR QUALITY

F1769

Paragraph No.	Pre Burn-in	Final Elect.	Limits & Conditions	
13.5 and 13.6 (cont.)				
OH - OL 60KHz	<u>17.6 dB</u>	<u>17.3 dB</u>	<u>17.8 dB</u> <u>17.5 dB</u>	+15/+19db ref. 100Hz Gain
OH + OL	<u>-24 dB</u>	<u>-33 dB</u>	<u>-24 dB</u> <u>-33 dB</u>	Min. -20db below OH - OL
OH - OL 100KHz	<u>8.1 dB</u>	<u>7.6 dB</u>	<u>8.2 dB</u> <u>7.7 dB</u>	+1/+10db ref. 100Hz Gain
OH + OL 100KHz	<u>-23 dB</u>	<u>-32 dB</u>	<u>-23 dB</u> <u>-34 dB</u>	Min. -20db below OH - OL

13.7 Supply Voltage Rejection

OH - OL (+15V)	<u>9 mV</u>	<u>9 mV</u>	<u>8 mV</u>	<u>8 mV</u>	< 100 mV p-p
OH + OL (+15V)	<u>11 mV</u>	<u>12 mV</u>	<u>11 mV</u>	<u>12 mV</u>	< 100 mV p-p
OH - OL (-15V)	<u>8 mV</u>	<u>7 mV</u>	<u>7 mV</u>	<u>7 mV</u>	< 100 mV p-p
OH + OL (-15V)	<u>2 mV</u>	<u>2 mV</u>	<u>2 mV</u>	<u>2 mV</u>	< 100 mV p-p

13.8 D.C. Offset

OH	<u>-16 mV</u>	<u>-5 mV</u>	<u>19 mV</u>	<u>-8 mV</u>	0 ± 340 mV max.
OL	<u>18 mV</u>	<u>12 mV</u>	<u>20 mV</u>	<u>16 mV</u>	0 ± 340 mV max.

13.9 Roll off Terminal Check

Terminal 56 & 47	<u>13.63 KΩ</u>	<u>13.60 KΩ</u>	12.9K - 15.4K
Terminal 41 & 33	<u>13.65 KΩ</u>	<u>13.63 KΩ</u>	12.9K - 15.4K

ORIGINAL PAGE IS
OF POOR QUALITY

Tested by: [Signature]

Quality/Responsible Engineer: [Signature] [Signature] SBRL 12-12-79

THEMATIC MAPPER	HUGHES AIRCRAFT COMPANY FULLERTON MICROELECTRONIC TEST DATA SHEET	DATE: 4-9-80	
1050580-100		PAGE 1	OF 2
P/N: 50859-1		P.O. No.	
Date Code & S/H 4679 84	POST AMPLIFIER	SPEC NO.: 16075	REV R

ORIGINAL PAGE IS F1769
OF POOR QUALITY

Paragraph No.	Results				Limits & Conditions
	Pre-Burn-In		Final Elect.		
	CHA	CHB	CHA	CHB	
13.1 Power					
I +15	1.67mw	1.61mw			< 2 ma
I -15	1.67mw	1.60mw			< 2 ma
13.2 Preamp Bias					
RL	-4.99v	-4.98v			-5 ± 10% volts
13.3 Input Balance					
III + IL	0.6mv	0.4mw			3.0 mv p-p 100Hz - 100kHz max.
13.4 Low Frequency Gain					
OH - OL 100Hz	+7.5dB	+9.2dB			9.7 ± 1 db
OH + OL	-45dB	-21dB			Min. -20db below OH - OL
13.5 Frequency Response and					
13.6 Common Mode Rejection					
OH - OL 5KHz	+4.5dB	+4.2dB			+4/+5db ref. 100Hz Gain
OH + OL	-39dB	-33dB			Min. -20db below OH - OL
OH - OL 10KHz	+9.1dB	+9.0dB			+8/+10db ref. 100Hz Gain
OH + OL	-38dB	-24dB			Min. -20db below OH - OL
OH - OL 20KHz	+14.5dB	+14.4dB			+13/+15db ref. 100Hz Gain
OH + OL	-28dB	-36dB			Min. -20db below OH - OL
OH - OL 40KHz	+19.4dB	+19.0dB			+17/+20db ref. 100Hz Gain
OH + OL	-27dB	-33dB			Min. -20db below OH - OL
OH - OL 50KHz	+19.5dB	+19.3dB			+17/+20db ref. 100Hz Gain
OH + OL	-25dB	-32dB			Min. -20db below OH - OL

S/R:

PAGE 2 OF 2

F1769

Paragraph No.	Pre Burn-in	Final Elect.	Limits & Conditions
13.5 and 13.6 (cont.)			
OH - OL 60KHz	<i>+18.2dB</i>	<i>+18.0dB</i>	+15/+19db ref. 100Hz Gain
OH + OL	<i>-24dB</i>	<i>-32dB</i>	Min. -20db below OH - 0
OH - OL 100KHz	<i>+8.9dB</i>	<i>+8.5dB</i>	+1/+10db ref. 100Hz Gain
OH + OL 100KHz	<i>-24dB</i>	<i>-32dB</i>	Min. -20db below OH - 0
13.7 Supply Voltage Rejection			
OH - OL (+15V)	<i>8mv</i>	<i>8mv</i>	<100 mv p-p
OH + OL (+15V)	<i>10mv</i>	<i>10mv</i>	<100 mv p-p
OH - OL (-15V)	<i>8mv</i>	<i>7mv</i>	<100 mv p-p
OH + OL (-15V)	<i>2mv</i>	<i>2mv</i>	<100 mv p-p
13.8 D.C. Offset			
OH	<i>-16mv</i>	<i>-5mv</i>	0 + 300 mv max.
OL	<i>+17mv</i>	<i>+13mv</i>	0 + 340 mv max.
13.9 Roll off Terminal Check			
Terminal 56 & 47			12.9K - 15.4K
Terminal 41 & 33			12.9K - 15.4K

ORIGINAL PAGE IS
OF POOR QUALITY

Tested by: *A. J. ... / 12-61*

Quality/Responsible Engineer: _____

PART NO. 50904-4		PART NAME <i>CuB Assy Postamples 1-4</i>		ASSY/LOT SERIAL NO. 201	QTY 1
OPER NO.	DATE	OPERATOR OR INSP	COMMENTS, TEST DATA, ETC	DISPOSITION	APPROVAL
500 ▽	3-21/80		<i>U3 57 thru 72 missing from U3</i>	<i>P.R. P.C.F. to</i>	<i>J. Kelly</i>
500	3-25-80	<i>M. Pally</i>	<i>FAILED TEST 4.3.6 (CH. 7) EXCEEDS 60 ± 45 DB, IS 7.2 DB WHEN VOL DISC., S.I WIREN V_{OH} DISC. SEG 1769 gndmin</i>	<i>Review 7</i> <i>Proceed to op 500</i>	<i>3-25-80</i> <i>J. Kelly</i>
500	3-26-80	<i>R. Bacl</i>	<i>REPLACE failed (U3) 50859-4 POST-RAMP HYBRID.</i>	<i>REF FAILURE REPORT 1769</i> <i>REPLACE U3 AND RETEST TO 16368, PAR 4.3.6</i> <i>P.R. Place subject part on U3 in R</i> <i># 302310</i> <i>1 Route to Ray</i> <i>Health & Safety</i> <i>Analysis</i>	<i>J. Kelly</i>
	3-27/80	<i>King</i>	<i>inspect installation of new hybrids</i> <i>replaced above</i>		
500	MAR 31 1980		<i>INSPECT INSTALLATION OF U3</i>		
	4/1/80		<i>M.C.I.</i>		
			<i>RETEST TO 16368 AND CONTINUE OPER 500</i>		
500	4-1-80	<i>M. Pally</i>	<i>RETESTED PER 16368 - OK</i>	<i>PROCEED</i>	<i>J. Kelly</i>

ORIGINAL PAGE IS OF POOR QUALITY

F 1769

SBRC

ASSEMBLY HISTORY RECORD CONTINUATION SHEET

SHEET 5 OF 9

PART NUMBER 50904-4	SERIAL OR LOT NUMBER 201	ASSEMBLY NAME PWB AYSY POSTAMPLIFIER 1-4	CONTINUATION OF: AIR DATED 3-3-80 AIR SUPPLEMENT NO.
------------------------	-----------------------------	---	--

OPER NO.	S/C NO.	INSTRUCTIONS	PERFORMED BY			REMARKS
			OPER	INSP	DATE	
		NOTE: Notify QA & AF prior to start of testing.				
200	22-13	1) Perform initial circuit test at ambient temperature per Spec 16368.	M. Kelly	112	3-25-80	FAILED TEST PARA 4.3.6 (11,7) FR 1769 R.H. 4-11-80
		2) Perform Electrical test per Spec 16597. Para 4.0				OK TO PROCEED WITH TESTING 4-1-80 R. Kelly
		3) Select components using Spec 16597 & per B/P note 16 & 22.	M. Kelly		4-1-80	TESTED ON 16368 ON (GT) 4-1-80 D. White
		4) Record selected values on test data sheet with traceability.				
<p>See MASTER PLANNING Dated 3/25/80 FOR CONTINUATION.</p>						
800	2-14	Kit and enter traceability of selects R1-R16, R17-R32, R65-R80, R81, R96, C33-C48 and C57-C72 or ABC/TH from test data sheets and MR.				
900	51-11	Inspect selects.				

ORIGINAL PAGE IS
OF POOR QUALITY

FR 1769

ORIGINAL PAGE IS OF POOR QUALITY

DE Removal

HUGHES

HUGHES AIRCRAFT COMPANY

SPACE AND COMMUNICATION GROUP
FAILURE REPORT

F 1774

1. PROGRAM NAME AND NUMBER HS 136 TM		2. GLA		3. MODEL FL		4. TIME OBSERVED 2 PM		5. DATE OBSERVED 5 5 80	
6. HARDWARE LEVEL WHEN FAILURE WAS OBSERVED		<input type="checkbox"/> SPACECRAFT <input type="checkbox"/> SYSTEM		<input type="checkbox"/> SUBSYSTEM <input type="checkbox"/> UNIT		<input type="checkbox"/> ASSEMBLY <input type="checkbox"/> SUBASSEMBLY		<input type="checkbox"/> MODULE <input type="checkbox"/> MICAM <input checked="" type="checkbox"/> CARD <input type="checkbox"/> PART	
EQUIPMENT IDENTIFICATION:									
7. SUBSYSTEM		NAME		PART NUMBER		S/N		MANUFACTURER	
8. UNIT									
9. <input type="checkbox"/> ASSEMBLY <input type="checkbox"/> SUBASSEMBLY									
10. <input type="checkbox"/> MODULE <input type="checkbox"/> MICAM <input checked="" type="checkbox"/> CARD		POSTAMP BAND 7		50908-2		201		HAC	
11. OTHER									
12. TEST WHEN FAILURE WAS OBSERVED		<input type="checkbox"/> DEVELOPMENT <input type="checkbox"/> IN-PROCESS		<input type="checkbox"/> QUALIFICATION <input checked="" type="checkbox"/> ACCEPTANCE		<input type="checkbox"/> INTEGRATION <input type="checkbox"/> SYSTEM		<input type="checkbox"/> LAUNCH OPERATIONS	
12. ENVIRONMENT WHEN FAILURE WAS OBSERVED		<input checked="" type="checkbox"/> AMBIENT <input type="checkbox"/> EMC/RFI		<input type="checkbox"/> RADIATION <input type="checkbox"/> VIBRATION		<input type="checkbox"/> TEMPERATURE AXIS FOR _____ MIN TYPE _____		<input type="checkbox"/> THERMAL VAC _____ MRE AT _____	
13. DESCRIPTION OF FAILURE		ALL 16 CHANNELS EXCEED MAX GAIN OF 20 DB FOR MAX BOOST ABOVE THE 100 HZ GAIN.							
14. TEST PROCEDURE		16368 4.3.8		15. ORIGINATOR N. PATTY		72 13		DATE 5-6-80	
16. VERIFICATION AND FAILURE ANALYSIS		FAILURE WILL BE RESOLVED BY CHANGING TOLERANCES IN TEST PROCEDURE 16368 PARAGRAPH 4.3.8						17. CONTINUATION SHEET USED	
18. FOLLOWING REWORK/RETEST REQUIRED REWORK/RETEST NOT REQUIRED BECAUSE		RESOLUTION OF FAILURE TO BE ACCOMPLISHED BY CHANGING TOLERANCE OF TP. 16368 PAR 4.3.8 WITH AN E.O.		19. FAILED ITEM NAME AND PART NUMBER					
20. REWORK/RETEST ACTION TAKEN		No retest required. ORIGINAL SPECS WERE TOO STRINGENT. NO IS E.O. 9897 RESOLVES PROBLEM.		21. AUTHORIZATION		12-23 DATE 5-5-80		22. CONTINUATION SHEET USED	
23. LIST ALL PARTS REPLACED		PART NUMBER		CCT SYN		PART LOT NO.		DATE CODE	
24. CAUSE AND CORRECTIVE ACTION		THIS IS NOT A FAILURE - UP ORIGINAL SPECIFICATIONS WERE TOO STRINGENT. E.O. 9897 CHANGES REQUIREMENTS AND ITEM IS NOW WITHIN SPEC. NEW MAX GAIN IS 26 db. MAX TEST GAIN WAS 23.2 db. TEST DATA SHEETS ATTACHED.		25. RETESTED BY		ORG		DATE	
25. FAILURE TYPE		<input checked="" type="checkbox"/> PRIMARY <input type="checkbox"/> INDUCED		<input type="checkbox"/> UNKNOWN <input type="checkbox"/> NO FAILURE		26. FAILURE CLASSIFICATION		<input type="checkbox"/> CRITICAL <input type="checkbox"/> MAJOR <input checked="" type="checkbox"/> MINOR <input type="checkbox"/> SAFETY	
27. RESPONSIBLE ENGINEER		DATE 1-23 5-5-80		28. SPACECRAFT SYSTEM ENGR		DATE 4-7-80		DATE 9-19-80	
29. RELIABILITY		DATE 1-9-18-80		30. CUSTOMER OR SUPPLIER		DATE			

ORIGINAL PAGE IS
OF POOR QUALITY

DE REMOVE

HUGHES

HUGHES AIRCRAFT COMPANY

SPACE AND COMMUNICATION GROUP
FAILURE REPORT

F 1776

1. PROGRAM NAME AND NUMBER H.S. 236 TM		2. GLA	3. MODEL FL	4. TIME OBSERVED 10 AM	5. DATE OBSERVED 2 5 80
6. HARDWARE LEVEL WHEN FAILURE WAS OBSERVED <input type="checkbox"/> SPACECRAFT <input type="checkbox"/> SUBSYSTEM <input type="checkbox"/> ASSEMBLY <input type="checkbox"/> MODULE <input checked="" type="checkbox"/> CARD <input type="checkbox"/> SYSTEM <input type="checkbox"/> UNIT <input type="checkbox"/> SUBASSEMBLY <input type="checkbox"/> MICAM <input type="checkbox"/> PART					
EQUIPMENT IDENTIFICATION:					
7. SUBSYSTEM		NAME		PART NUMBER	SN
8. UNIT					
9. <input type="checkbox"/> ASSEMBLY <input type="checkbox"/> SUBASSEMBLY					
10. <input type="checkbox"/> MODULE <input type="checkbox"/> MICAM <input checked="" type="checkbox"/> CARD		POST AMB BAND 1		50904-1	2-01 HAC
11. OTHER					
12. TEST WHEN FAILURE WAS OBSERVED <input type="checkbox"/> DEVELOPMENT <input checked="" type="checkbox"/> QUALIFICATION <input type="checkbox"/> INTEGRATION <input type="checkbox"/> LAUNCH OPERATIONS <input type="checkbox"/> IN-PROCESS <input type="checkbox"/> ACCEPTANCE <input type="checkbox"/> SYSTEM					
13. ENVIRONMENT WHEN FAILURE WAS OBSERVED <input checked="" type="checkbox"/> AMBIENT <input type="checkbox"/> RADIATION <input type="checkbox"/> TEMPERATURE <input type="checkbox"/> THERMAL VAC <input type="checkbox"/> HRS. AT <input type="checkbox"/> EMC/RFI <input type="checkbox"/> VIBRATION <input type="checkbox"/> AXIS FOR <input type="checkbox"/> MIN <input type="checkbox"/> TYPE <input type="checkbox"/> OTHER					
14. DESCRIPTION OF FAILURE ALL 16 CHANNELS EXCEED MAX GAIN OF 20 DB FOR MAX BOOST ABOVE THE 100 HZ BAND					
15. TEST PROCEDURE 16368 4.3.8		15. ORIGINATOR N. PATTY		ORG 2213	DATE 5/6-80
16. VERIFICATION AND FAILURE ANALYSIS RESOLUTION OF FAILURE TO BE ACCOMPLISHED BY CHANGING TOLERANCES OF TEST PROCEDURE 16368 PAR 4.3.8 WITH AN E.O.					
19. FAILED ITEM NAME AND PART NUMBER NONE					
20. <input checked="" type="checkbox"/> FOLLOWING REWORK/RETEST REQUIRED <input type="checkbox"/> REWORK/RETEST NOT REQUIRED BECAUSE RESOLUTION OF FAILURE TO BE ACCOMPLISHED BY CHANGING TOL TOLERANCES IN T.P. 16348 PARA 4.3.8					
21. AUTHORIZATION <i>[Signature]</i>				ORG 21-23	DATE 5-5-80
22. REWORK/RETEST ACTION TAKEN NO RETEST REQUIRED. ORIGINAL SPECS WERE TOO STRINGENT. E.O. 9897 RESOLVES PROBLEM		24. QA REWORK		25. QA RETEST	
23. LIST ALL PARTS REPLACED					
PART NUMBER	QTY	SYM	PART LOT NO.	DATE CODE	MFR
27. REWORK BY		ORG	DATE	28. RETESTED BY	ORG
29. CAUSE AND CORRECTIVE ACTION THIS IS NOT A FAILURE - OP ORIGINAL SPECIFICATIONS WERE TOO STRINGENT. E.O. 9897 CHANGES REQUIREMENTS AND PARTS ARE NOW WITHIN SPEC. NEW MAX GAIN ALLOWED IS 2.6 db. MAX TEST GAIN WAS 21.6. TEST DATA SHEETS ATTACHED					
32. DOCUMENT IMPLEMENTING CORRECTIVE ACTION E.O. 9897					
34. BASIC CAUSE OF VERIFIED FAILURE <input type="checkbox"/> DESIGN <input type="checkbox"/> TEST EQUIP <input type="checkbox"/> MFG. PROCEDURE <input type="checkbox"/> WIRING ERROR <input type="checkbox"/> UNKNOWN <input type="checkbox"/> ENVIRONMENTAL <input checked="" type="checkbox"/> TEST PROC. <input type="checkbox"/> ASSY/PKG ERROR <input type="checkbox"/> ROUGH HANDLING <input type="checkbox"/> DEFECT CODE <input type="checkbox"/> DEFECTIVE PARTS <input type="checkbox"/> TEST SET-UP <input type="checkbox"/> WORKMANSHIP <input type="checkbox"/> WEAR-OUT					
35. FAILURE TYPE <input checked="" type="checkbox"/> PRIMARY <input type="checkbox"/> UNKNOWN <input type="checkbox"/> NO FAILURE <input type="checkbox"/> MINOR <input type="checkbox"/> MAJOR		38. FAILURE CLASSIFICATION <input type="checkbox"/> CRITICAL <input checked="" type="checkbox"/> MINOR <input type="checkbox"/> SAFETY			
37. RESPONSIBLE ENGINEER <i>[Signature]</i>		ORG 21-23	DATE 5-5-80	38. SPACECRAFT SYSTEM ENGR <i>[Signature]</i>	
39. RELIABILITY <i>[Signature]</i>		ORG 51-41	DATE 9-10-80	40. CUSTOMER OR SUPPLIER 65	

ORIGINAL PAGE IS
OF POOR QUALITY



SPACE AND COMMUNICATION GROUP
FAILURE REPORT

F 1781

1. PROGRAM NAME AND NUMBER <i>HS 236 TM.</i>		2. GLA	3. MODEL <i>FLT R/W</i>	4. TIME OBSERVED <i>1110A</i>	5. DATE OBSERVED <i>5 8 80</i>
6. HARDWARE LEVEL WHEN FAILURE WAS OBSERVED		<input type="checkbox"/> SPACECRAFT	<input type="checkbox"/> SUBSYSTEM	<input type="checkbox"/> ASSEMBLY	<input type="checkbox"/> MODULE
		<input type="checkbox"/> SYSTEM	<input type="checkbox"/> UNIT	<input type="checkbox"/> SUBASSEMBLY	<input type="checkbox"/> MICAM
EQUIPMENT IDENTIFICATION					
7. SUBSYSTEM		NAME		PART NUMBER	S/N
8. UNIT					
9. <input type="checkbox"/> ASSEMBLY <input type="checkbox"/> SUBASSEMBLY					
10. <input type="checkbox"/> MODULE <input type="checkbox"/> MICAM <input checked="" type="checkbox"/> CARD		<i>MACB - DESCARTES GEN B1</i>		<i>51795</i>	<i>102</i>
11. OTHER					<i>HAC</i>
12. TEST WHEN FAILURE WAS OBSERVED		<input type="checkbox"/> DEVELOPMENT	<input type="checkbox"/> QUALIFICATION	<input type="checkbox"/> INTEGRATION	<input type="checkbox"/> LAUNCH OPERATIONS
		<input type="checkbox"/> IN-PROCESS	<input checked="" type="checkbox"/> ACCEPTANCE	<input type="checkbox"/> SYSTEM	<input type="checkbox"/>
13. ENVIRONMENT WHEN FAILURE WAS OBSERVED		<input checked="" type="checkbox"/> AMBIENT	<input type="checkbox"/> RADIATION	<input type="checkbox"/> TEMPERATURE	<input type="checkbox"/> THERMAL VAC
		<input type="checkbox"/> EMC/RFI	<input type="checkbox"/> VIBRATION	AXIS FOR	WIR TYPE
14. DESCRIPTION OF FAILURE		<i>PINS 2, 6 AND 10 ON U35 SHORTED TOGETHER.</i>			
15. TEST PROCEDURE <i>16423</i>		PARA <i>5.3.3</i>	18. ORIGINATOR <i>J.A. Branch</i>	ORG <i>22-13</i>	DATE <i>11/10-5-8</i>
16. VERIFICATION AND FAILURE ANALYSIS		<i>PHYSICAL EXAMINATION SHOWS NO SOLDERING DEFECTS OR INSTALLATION DEFECTS. PINS 2, 6 AND 10 TO BE LIMITED TO ISOLATE DEFECTS.</i>			
17. FOLLOWING REWORK/RETEST REQUIRED REWORK/RETEST NOT REQUIRED BECAUSE		<i>REMOVE SHORT ON PWB TRACES FOR U35 PINS 2, 6, 10</i>			
		<i>Heatsink removed on MRCO 295760.</i>			
		<i>Retest per 16423 Para 5.3.3</i>			
21. AUTHORIZATION		<i>J.A. Branch</i>		ORG <i>22-13</i>	DATE <i>5-9-80</i>
23. REWORK/RETEST ACTION TAKEN		<i>Heatsink removed, shorted traces opened</i>			
		<i>Retest per 16423 Para 5.3.3</i>			
24. CAUSE		<i>MRB</i>			
		<i>11-19-80</i>			
25. CAUSE		<i>MRB</i>			
		<i>11-19-80</i>			
26. LIST ALL PARTS REPLACED					
PART NUMBER	QTY	SYM	PART LOT NO	DATE CODE	MFR
27. REWORK BY <i>A. BROWN</i>		ORG <i>22-17</i>	DATE <i>11-21-80</i>	28. RETESTED BY <i>J. GUYTON</i>	ORG <i>22-13</i>
					DATE <i>11-9-81</i>
29. CAUSE AND CORRECTIVE ACTION		<i>PRINTED WIRING BOARD FABRICATED WITH TRACE ERROR.</i>			
30. CHECK PWB TRACES COMPLETELY PRIOR TO HEATSINK INSTALLATION AND COMPONENT PLACEMENT.		31. FRB CLOSURE			
31. CA - PARTS DISPOSITION THEN MRB SEE NCMR #290489 DATE 5/12/80 (ATTACHED) WITH NO FUTURE COMPLICATIONS NOTED.					
32. DOCUMENT IMPLEMENTING CORRECTIVE ACTION		<i>MRCO 295760, NCRM # 290489 (ATTACHED)</i>			
33. BASIC CAUSE OF VERIFIED FAILURE		<input type="checkbox"/> DESIGN	<input type="checkbox"/> TEST EQUIP	<input type="checkbox"/> MFG. PROCEDURE	<input type="checkbox"/> HIRING ERROR
		<input type="checkbox"/> ENVIRONMENTAL	<input type="checkbox"/> TEST PROC.	<input checked="" type="checkbox"/> ASSY/FAB ERROR	<input type="checkbox"/> ROUGH HANDLING
		<input type="checkbox"/> DEFECTIVE PART	<input type="checkbox"/> TEST SET-UP	<input type="checkbox"/> WORKMANSHIP	<input type="checkbox"/> WEAR-OUT
34. FAILURE TYPE		<input checked="" type="checkbox"/> PRIMARY	<input type="checkbox"/> UNKNOWN	<input type="checkbox"/> CRITICAL	<input type="checkbox"/> MINOR
		<input type="checkbox"/> INDUCED	<input type="checkbox"/> NO FAILURE	<input type="checkbox"/> MAJOR	<input type="checkbox"/> SAFETY
35. RESPONSIBLE ENGINEER <i>J.A. Branch</i>		ORG <i>22-13</i>	DATE <i>11/17/81</i>	36. SPACECRAFT SYSTEM ENGINEER <i>William J. ...</i>	
37. RELIABILITY <i>100%</i>		ORG <i>31-4</i>	DATE <i>11/18/81</i>	38. CUSTOMER AS SUPPLIER <i>...</i>	

FORMS INSTRUCTIONS FOR FORM 11628 CS (COMPLETE ONLY APPLICABLE BLOCKS)

DIVISIONAL INSTRUCTIONS
PROVIDE INFORMATION.

SPECIFIC WORK STATIONS OR
SPECIFIC ORG CODES

WORK TRANSFER DOCUMENTS ETC.

THIS LINE USED BY REC. INSP

SPECIFY CLEAR CONCISE
DESCRIPTION OF EACH
NONCONFORMITY, INCLUDING:

- (1) SERIAL NO.
- (2) DRAWING AREA OR LOCATION
- (3) IS: S/B TOLERANCES
- (4) SPECIFICATION PARA. REF. NO.,
ETC.

DIVISIONAL PROCEDURES SPECIFY
LEVEL OF PERSONNEL REQUIRED

THIS AREA TO BE USED AS
NECESSARY TO SPECIFY:

1. REPAIR INSTRUCTIONS
2. REWORK INSTRUCTIONS
3. USE AS IS JUSTIFICATION
4. MRU INSTRUCTIONS

HUGHES

PHOTOGRAPH NO. _____

DATE _____

DESCRIPTION OF NONCONFORMANCE


REPAIR INSTRUCTIONS

REWORK INSTRUCTIONS

USE AS IS JUSTIFICATION

MRU INSTRUCTIONS

11628 CS (Rev. 1-77)

 

ORIGINAL PAGE IS
OF POOR QUALITY

THIS LINE USED BY MATERIEL

WHEN SUPPLIER CORRECTIVE
ACTION IS REQUESTED THE SUPPLIER
CORRECTIVE ACTION REQUEST
(SCAR) IS USED

DISTRIBUTION DETERMINED
BY DIVISIONAL INSTRUCTIONS

CORRECTIVE ACTION STATEMENTS
SHOULD INCLUDE THE FOLLOWING

- (1) DESCRIPTION OF THE CAUSE
OF THE NONCONFORMANCE
- (2) ACTION TAKEN TO PREVENT
REURRENCE
- (3) EFFECTIVITY OF C/A BY DATE,
LOT OR S/N

F1781

HUGHES

NONCONFORMING MATERIAL REPORT (NCMR)

051912

NO. 0489

052022

DATE 5/12/80

1 PKG/X-(F)

PAGE 1 OF 1

PROGRAM ID THEMATIC MAPPER VO12

RT NO. 51195	S/N 102	ENG. CHANGES	NOMENCLATURE MICRO DISCRETE 1 PLUB		
MRK ORDER DOC NO.	LOT SIZE 1	QTY. SUSP 1	SUSPENDED IN TEST	HARDWARE I.D. NO.	REF. DOCUMENTS
SUPPLIER HAC E/S		DIV. OR LOCATION	SUPPLIER CODE	P.O. NO. PA 9388	ITEM NO.
					R.R. NO.

ITEM NO.	QTY INSP.	QTY SUSP.	DESCRIPTION OF NONCONFORMANCE	RESP. DEPT.	PHIO OCCUR	M.R. LEVEL	CODE
1	1	1	SHORTED TRACE FAKSIDE IN AREA OF COMPONENT U-35. (FEEDTHRU HOLES ACROSS PINS 2 & 6) SEE X-RAY PROVIDED.		10	MRK	

SIGNATOR *M. Sawicki* DATE 5/12/80 QUALITY *J. Blum* DATE 5-22-80 ENGINEERING *[Signature]* DATE 5/12/80

ITEM NO.	DISP. CODE	DISPOSITION/INSTRUCTIONS	STAMP
1	1	REMOVE H/S FROM PLUB FOR FURTHER EVALUATION. PER MRK RETURN TO MRK	107
		PROCEED AT EXIST MRK WITH H/S FOR REWORK	

ENGINEER *[Signature]* DATE 5/22/80 QUALITY *J. Blum* DATE 6-11-80 CUSTOMER *V. Teller* DATE 10-23-81

ITEM NO.	CAUSE OF NONCONFORMANCE	RESULTS OF CORRECTIVE ACTION INVESTIGATION	CORRECTIVE ACTION
1	ISOLATED ERROR CAUSED BY SILK SCREEN PROCESSING AT PLUB MANUFACTURER.	Isolated process error not expected to be repetitive	

SIGNATURE *[Signature]* DATE 10-23-81 SIGNATURE *[Signature]* DATE 10-23-81

RESPONSIBILITY	DEBIT VENDOR	DISP CODE	VENDOR PACKING SHEET	QTY. R.T.V.	QTY. SCRAP	BUYERS SIGNATURE	DATE	COPY
NOOR	HAC	YES	NO					
<input type="checkbox"/>	<input type="checkbox"/>	<input type="checkbox"/>	<input type="checkbox"/>					

ORIGINAL PAGE IS OF POOR QUALITY

F1781

ORIGINAL PAGE IS
OF POOR QUALITY

F178

MATERIAL REVIEW
CONTROL ORDER

MRCO

3	0	0	4	8	9	1
W	/	A	V	0	1	

PART NO. 51795 REVISION _____

PART NAME MACRO DISCRETE NO 1 PWB

QUANTITY 1 SIN 102

ROUTE TO: RM 5322

P. O. MASTER CLEARED _____

S/C	OPR NO.	INSTRUCTIONS	DATE	QTY ACC	QTY SUS	INSP OPER	COMMENTS
22-14	100	REMOVE HEATSINK FROM PWB	6/10/80			SPK	
	200	INSPECT AND IDENTIFY SHORT	6/19/80 AUG 21 1980			25- 277 113	Determine cause of CH PHI L.H. #100248425
	300	REMOVE SHORT	8/21/80			113 113	
	400	INSPECT	AUG 21 1980			113	
	500	MCT	8/21/80	0	1	113	INSUFFICIENT PWB INSTRUCTIONS FOR CLEANING & BONDING THE HEAT SINK TO THE
	600	BOND HEATSINK TO PWB CURE HRS _____	8/22/80	1	0	113 113	SEE CONTINUATION FOR ADDITIONAL MIX NO.
	700	INSPECT					
LAST	RETURN THIS CARD TO MATERIAL REVIEW FOR RECORD CLEARANCE						
OPR							

SB 0344-B-1 FEB 78

QA APPROVAL [Signature] DATE 6/10/80
 ENG APPROVAL [Signature] DATE 5/22/80

F1781

T3
TEST PROGRAM NO. 3 - - - - > MACRO DISCRETE CMD. TEST - CH #1
SENDS ALTERNATING BIT PATTERN TO
BOARD AND VERIFIES PROPER OPERATION

ENTER OPERATOR DATA, YES OR NO : N

PRINT VERIFICATION ERRORS, YES OR NO : Y

ORIGINAL PAGE IS
OF POOR QUALITY

CURRENT CYCLE COUNT IS : 0000000050

CURRENT ERROR COUNT IS : 0000000000

MONITOR

T3
TEST PROGRAM NO. 3 - - - - > MACRO DISCRETE CMD. TEST - CH #1
SENDS ALTERNATING BIT PATTERN TO
BOARD AND VERIFIES PROPER OPERATION

ENTER OPERATOR DATA, YES OR NO : Y

ASSY. NO.: ----- 51795
CARD NAME: ----- MACRODISCRETE CMD GEN #1
SERIAL NO.: ----- 102
DATE & TIME: ---- NOV 15 '81 9:11
PRI. OR RDT.: --- RDT
TEST OPERATOR: -- J BANACH
OTHER TEST
CONDITIONS: ----- LIFE CYCLE TESTING AT AMBIENT (RDT)

TO START TEST EXECUTION
PRESS "G" KEY.

(TO TERMINATE TEST PRESS "ESC" KEY.)
G

PRINT VERIFICATION ERRORS, YES OR NO : Y

CURRENT CYCLE COUNT IS : 0001011026

CURRENT ERROR COUNT IS : 0000000000

- - TESTING COMPLETED - -

DATE & TIME: ---- NOV 17 '81 8:05
PRI. OR RDT.: --- RDT
TEST OPERATOR: -- J BANACH
OTHER TEST
CONDITIONS: ----- LIFE CYCLE TESTING AT AMBIENT (RDT)

ORIGINAL PAGE IS
OF POOR QUALITY

F1781


MONITOR

T3

TEST PROGRAM NO. 3 - - - - > MACRO DISCRETE CMD. TEST - CH #1
SENDS ALTERNATING BIT PATTERN TO
BOARD AND VERIFIES PROPER OPERATION

ENTER OPERATOR DATA, YES OR NO : Y

ASSY. NO.: ----- 51795
CARD NAME: ----- MACRO DISCRETE CMD GEN #1
SERIAL NO.: ----- 102
DATE & TIME: ----- 13 NOV '81 10:07
PRI. OR RDT.: --- PRI
TEST OPERATOR: -- J GUYTON
OTHER TEST
CONDITIONS: ----- LIFE CYCLE TESTING AT AMBIENT (PRI)

TO START TEST EXECUTION
PRESS "G" KEY.

(TO TERMINATE TEST, PRESS "ESC" KEY.)
G

PRINT VERIFICATION ERRORS, YES OR NO : Y

CURRENT CYCLE COUNT IS : 0001007910

CURRENT ERROR COUNT IS : 0000000000

- - TESTING COMPLETED - -

DATE & TIME: ----- 15 NOV '81 8:56
PRI. OR RDT.: --- PRI
TEST OPERATOR: -- J BANACH
OTHER TEST
CONDITIONS: ----- LIFE CYCLE TESTING AT AMBIENT (PRI)

F1781

Memo to L. O'Connell
12-8-81
Page 2

ORIGINAL PAGE IS
OF POOR QUALITY

The maximum short-circuit output current of a 54L04 is 15 ma. For two outputs short-circuited to signal ground the total current is 30 ma. It is believed that 30 ma (plus an additional 4.32 ma of loads from gates connected to the three outputs) is beyond the sink current capability of U35E, which has a guaranteed capability of at least 2.0 ma. However, if U35E is capable of this current, the resulting stress would not be excessive. For example, the maximum additional power increase with two outputs short-circuited (neglecting the 4.32 ma of external loads) is 150 mW ($5V \times 30 ma$). For an assumed thermal resistance of $150^{\circ} C/W$, junction-to-ambient, the maximum increase in junction temperatures would be $+22.5^{\circ}C$, resulting in junction temperatures of $+45.5^{\circ}C$ ($+22.5^{\circ}C$ temperature rise above a $+23^{\circ}C$ ambient). Since the part is capable of operation at $+125^{\circ}C$, the resulting stress would not have been excessive.

Andrew E. Huber
A. Huber

Distribution: Altman, L.
Banach, J.
Barnett, G. C.
Day, J. G.
Evans, D.

12-8-81 11:30 AM



ORIGINAL PAGE IS
OF POOR QUALITY
SPACE AND COMMUNICATION GROUP
FAILURE REPORT

F 1783

1. PROGRAM NAME AND NUMBER <i>HS 236 T.M.</i>		2. GLA		3. MODEL <i>AT</i>		4. TIME OBSERVED <i>8:30A</i>		5. DATE OBSERVED MO <i>5</i> DA <i>9</i> YR <i>88</i>	
6. HARDWARE LEVEL WHEN FAILURE WAS OBSERVED		<input type="checkbox"/> SPACECRAFT		<input type="checkbox"/> SUBSYSTEM		<input type="checkbox"/> ASSEMBLY		<input type="checkbox"/> MODULE	
		<input type="checkbox"/> SYSTEM		<input type="checkbox"/> UNIT		<input type="checkbox"/> SUBASSEMBLY		<input type="checkbox"/> MICAM	
7. EQUIPMENT IDENTIFICATION:		NAME		PART NUMBER		SN		MANUFACTURER	
8. SUBSYSTEM									
9. UNIT									
10. <input type="checkbox"/> ASSEMBLY <input type="checkbox"/> SUBASSEMBLY									
10. <input type="checkbox"/> MODULE <input type="checkbox"/> MICAM		<i>CARD MARK DESCRIPTION NO. 1</i>		<i>51795</i>		<i>102</i>		<i>HAC</i>	
11. OTHER									
12. TEST WHEN FAILURE WAS OBSERVED		<input type="checkbox"/> DEVELOPMENT		<input type="checkbox"/> QUALIFICATION		<input type="checkbox"/> INTEGRATION		<input type="checkbox"/> LAUNCH OPERATIONS	
		<input type="checkbox"/> INFACRES		<input checked="" type="checkbox"/> ACCEPTANCE		<input type="checkbox"/> SYSTEM			
13. ENVIRONMENT WHEN FAILURE WAS OBSERVED		<input checked="" type="checkbox"/> AMBIENT		<input type="checkbox"/> RADIATION		<input type="checkbox"/> TEMPERATURE		<input type="checkbox"/> THERMAL VAC	
		<input type="checkbox"/> EMC/RFI		<input type="checkbox"/> VIBRATION		AXIS FOR		TYPE	
14. DESCRIPTION OF FAILURE									
15. TEST PROCEDURE		<i>10423</i>		PARA <i>5.3.3</i>		16. ORIGINATOR <i>W. H. H. H.</i>		ORG <i>122-13</i> DATE <i>5-9-88</i>	
18. VERIFICATION AND FAILURE ANALYSIS								17. CONTINUATION SHEET USED	
19. FOLLOWING REWORK/RETEST REQUIRED								19. FAILED ITEM NAME AND PART NUMBER	
<input checked="" type="checkbox"/>									
20. REWORK/RETEST ACTION TAKEN								21. AUTHORIZATION	
22. LIST ALL PARTS REPLACED								23. CONTINUATION SHEET USED	
24. CAUSE AND CORRECTIVE ACTION								25. FAILURE CLASSIFICATION	
26. BASIC CAUSE OF VERIFIED FAILURE		<input type="checkbox"/> DESIGN		<input type="checkbox"/> TEST EQUIP		<input type="checkbox"/> MFG. PROCEDURE		<input type="checkbox"/> WIRING ERROR	
		<input type="checkbox"/> ENVIRONMENTAL		<input type="checkbox"/> TEST PROC.		<input type="checkbox"/> ASSY/FAB ERROR		<input type="checkbox"/> ROUGH HANDLING	
		<input type="checkbox"/> DEFECTIVE PARTS		<input type="checkbox"/> TEST SET UP		<input type="checkbox"/> WORKMANSHIP		<input type="checkbox"/> SNEEDOUT	
27. FAILURE TYPE		<input type="checkbox"/> PRIMARY		<input type="checkbox"/> UNKNOWN		<input type="checkbox"/> CRITICAL		<input type="checkbox"/> MINOR	
		<input type="checkbox"/> INDUCED		<input type="checkbox"/> NO FAILURE		<input type="checkbox"/> MAJOR		<input type="checkbox"/> SAFETY	
28. RESPONSIBLE ENGINEER		<i>P. J. Hooley</i>		DATE <i>8-13-88</i>		29. SPACECRAFT SYSTEM ENGR		DATE <i>22/6/88</i>	
29. APPROVED BY		<i>W. H. H. H.</i>		DATE <i>5-17-88</i>		30. CUSTOMER OR SUPPLIER		DATE <i>4/17/81</i>	

ORIGINAL PAGE IS
OF POOR QUALITY


1733

ENGINEERING ORDER / REVISION NOTICE NO. 7707
SHEET 1 OF 1

DRAWING TITLE <u>FIVE ASSY WARD DISCRETE COMMAND NO. 1 (A128 212)</u>		DRAWING NUMBER <u>51795 (A)</u>	
PROJECT NUMBER <u>2-1162</u>	ITEM DISPOSITION REWORK <input checked="" type="checkbox"/> ITEMS CONFORM <input type="checkbox"/> NO ITEMS MADE <input type="checkbox"/> REJECT <input type="checkbox"/> USE <input type="checkbox"/> NOT APPLICABLE <input type="checkbox"/>	CLASS CHANGE <input type="checkbox"/> I <input checked="" type="checkbox"/> II <input type="checkbox"/> III	DRAWING TYPE <input type="checkbox"/> A <input checked="" type="checkbox"/> B <input type="checkbox"/> C
EFFECTIVITY <u>51065</u> <u>SERVO CO2 & SUEQ</u>		AUTHORIZING ECR NUMBER <u>TM166-3/c1</u>	

DESCRIPTION OF CHANGE

- 1) ADDED ITEM TO LM
IS: FE J-W-1177/15 WIRE, INSUL, AWG 30, CL 220, TYPE M (J-W-1177)-:
- 2) ADDED NOTE 21
IS: INSTALL WIRE ITEM * BETWEEN PADS OF UT-1 AND UT-7.
- 3) ADDED NOTE CALLOUT TO SHT 2 ZONE 3D AND WIRE DEPICTION.
IS:

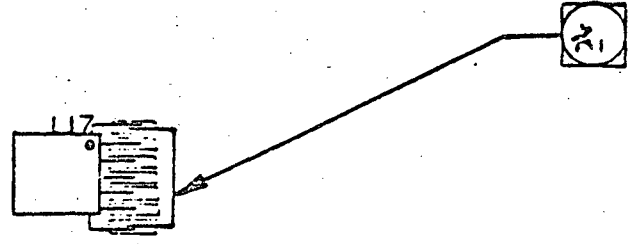

RECEIVED AND PRINTED
 20-5-8
 20-5-8
 20-5-8

* NOTE AND/OR ITEM NUMBER TO BE ASSIGNED AT TIME OF INCORPORATION.

PREPARED BY <u>T. J. ...</u>	DATE <u>20-5-8</u>	QUALITY APPROVAL <u>[Signature]</u>	DATE <u>20-5-8</u>	RELEASED BY <u>[Signature]</u>	DATE <u>20-5-8</u>
CHECKED BY <u>[Signature]</u>	DATE <u>20-5-8</u>	MANUFACTURING APPROVAL	DATE	INCORPORATED BY	DATE
SEA/PSA APPROVAL <u>[Signature]</u>	DATE <u>20-5-8</u>	PROJECT APPROVAL <u>[Signature]</u>	DATE <u>20-5-8</u>	DRAWING REV LETTER	

1783

1. ORIGINATOR NAME AND ADDRESS HUGHES AIRCRAFT COMPANY (SBRC)				2. <input checked="" type="checkbox"/> DEVIATION <input type="checkbox"/> WAIVER	
4. DESIGNATION FOR DEVIATION/WAIVER				3. <input checked="" type="checkbox"/> MINOR <input type="checkbox"/> MAJOR <input type="checkbox"/> CRITICAL	
6. MODEL/TYPE PF5F	7. MFR. CODE 11323	8. SYS. DESIG. TM	9. DEV./WAIVER NO. D065	5. BASE LINE AFFECTED	
7. SPECIFICATIONS AFFECTED-TEST PLAN				6. OTHER SYSTEMS/CONFIGURATION ITEMS AFFECTED	
11. CONFIGURATION ITEM NOMENCLATURE ELECTRONICS MODULE ASSEMBLY				14. DEFECT CLASSIFICATION <input checked="" type="checkbox"/> MINOR <input type="checkbox"/> MAJOR <input type="checkbox"/> CRITICAL	
13. NAME OF PART OR LATEST ASSEMBLY AFFECTED MACRO DISCRETE COMMAND NO. 1.		16. PART NO. OR TYPE DESIGNATION 51795		17. LOT NO.	
23. DESCRIPTION OF DEVIATION/WAIVER Alternate wiring (artwork error - trace omitted on A/W) incorporated on assembly drawing to accommodate circuit design changes. See 51795 assembly drawing and referenced SP80165 alternate wiring process. specification attached. See also EO 9902.				21. EFFECT ON DELIVERY SCHEDULE 5 Months schedule impact if disapproved.	

ORIGINAL PAGE IS
 OF POOR QUALITY

24. NEED FOR DEVIATION/WAIVER Redesign and re-procurement of electronic circuit boards would be required in order to eliminate alternate wiring. Minimum 5 months schedule slip and considerable cost would be involved. Redesign is not considered cost effective at this time.	
25. PRODUCTION EFFECTIVITY BY SERIAL NUMBER S/Ns 101, 102, 201, 202	
26. SUBMITTING ACTIVITY AUTHORIZING SIGNATURE J. L. Craig 3/19/80	
27. APPROVAL/DISAPPROVAL	
<input type="checkbox"/> APPROVAL RECOMMENDED	<input checked="" type="checkbox"/> APPROVED <input type="checkbox"/> DISAPPROVED
6. GOVERNMENT ACTIVITY NASA GSFC	SIGNATURE George B. Pitt DATE 3/19/80

ORIGINAL PAGE IS
OF POOR QUALITY



SPACE AND COMMUNICATION GROUP
FAILURE REPORT

F 2722

1. PROGRAM NAME AND NUMBER <i>TM PL116L</i>		2. CLA <i>V411</i>	3. MODEL <i>PLT</i>	4. TIME OBSERVED <i>8:10</i>	5. DATE OBSERVED MO <i>12</i> DA <i>23</i> YR <i>81</i>
6. HARDWARE LEVEL WHEN FAILURE WAS OBSERVED <input type="checkbox"/> AIRCRAFT <input type="checkbox"/> SUBSYSTEM <input type="checkbox"/> ASSEMBLY <input type="checkbox"/> MODULE <input checked="" type="checkbox"/> CARD <input type="checkbox"/> SYSTEM <input type="checkbox"/> UNIT <input type="checkbox"/> SUBASSEMBLY <input type="checkbox"/> MICAM <input type="checkbox"/> PART					
EQUIPMENT IDENTIFICATION:					
7. SUBSYSTEM		NAME		PART NUMBER	SYN MANUFACTURER
8. UNIT					
9. <input type="checkbox"/> ASSEMBLY <input type="checkbox"/> SUBASSEMBLY					
10. <input type="checkbox"/> MODULE <input type="checkbox"/> MICAM <input checked="" type="checkbox"/> CARD		<i>Calibration Shuttle Main</i>		<i>50916</i>	<i>201 SBRC</i>
11. OTHER					
12. TEST WHEN FAILURE WAS OBSERVED <input type="checkbox"/> DEVELOPMENT <input type="checkbox"/> QUALIFICATION <input type="checkbox"/> INTEGRATION <input type="checkbox"/> LAUNCH OPERATIONS <input type="checkbox"/> PROCEED <input checked="" type="checkbox"/> ACCEPTANCE <input type="checkbox"/> SYSTEM					
13. ENVIRONMENT WHEN FAILURE WAS OBSERVED <input checked="" type="checkbox"/> ASSEMBY <input type="checkbox"/> RADIATION <input type="checkbox"/> TEMPERATURE <input type="checkbox"/> THERMAL VAC <input type="checkbox"/> HRS AT <input type="checkbox"/> ESCRPH <input type="checkbox"/> VIBRATION <input type="checkbox"/> AXIS FOR <input type="checkbox"/> USE TYPE <input type="checkbox"/> OTHER					
14. DESCRIPTION OF FAILURE		<i>Observed improper waveform during test 16238 per 3.3.4 Upon visual inspection found trace cut between AR4-3 and R48</i>			
15. TEST PROCEDURE <i>16238</i>		PARA <i>3.3.4</i>	16. ORIGINATOR <i>Floyd Evans</i>	ORG <i>2213</i>	DATE <i>12/23/81</i>
18. VERIFICATION AND FAILURE ANALYSIS		<i>Repair CUT Trace, Trace cut in error during manufacturing. No overstress, signal is input</i>			
19. FAILED ITEM NAME AND PART NUMBER					
20. <input checked="" type="checkbox"/> FOLLOWING REWORK/RETEST REQUIRED <input type="checkbox"/> REWORK/RETEST NOT REQUIRED BECAUSE		<i>Repair CUT Trace. Retest per 16238 3.3.4.</i>			
21. AUTHORIZATION		ORG <i>2213</i>	DATE <i>12/23/81</i>	22. CONTINUATION SHEET USED	
23. REWORK/RETEST ACTION TAKEN		<i>Installed Jumper Wire on CUT Trace Retested per TP 16238 Para. 3.3.4</i>			
24. CAUSE AND CORRECTIVE ACTION		<i>OPERATOR ERROR CAUSED CUT AT WRONG TRACE DURING REWORK PER EQ9425. OPERATOR AND SUPERVISOR CAUTIONED. RPN 1000000 1/18/82</i>			
25. DOCUMENT IMPLEMENTING CORRECTIVE ACTION					
26. BASIC CAUSE OF VERIFIED FAILURE <input type="checkbox"/> DESIGN <input type="checkbox"/> TEST EQUIP <input type="checkbox"/> MFG. PROCEDURE <input type="checkbox"/> WIRING ERROR <input type="checkbox"/> UNKNOWN <input type="checkbox"/> ENVIRONMENTAL <input type="checkbox"/> TEST PROC. <input type="checkbox"/> ASBY/PAB ERROR <input type="checkbox"/> ROUGH HANDLING <input type="checkbox"/> DEFECT CODE <input type="checkbox"/> DEFECTIVE PARTS <input type="checkbox"/> TEST SET-UP <input checked="" type="checkbox"/> WORKMANSHIP <input type="checkbox"/> WEAR-OUT					
27. FAILURE TYPE <input checked="" type="checkbox"/> PRIMARY <input type="checkbox"/> UNKNOWN <input type="checkbox"/> INDUCED <input type="checkbox"/> NO FAILURE		28. FAILURE CLASSIFICATION <input type="checkbox"/> CRITICAL <input checked="" type="checkbox"/> MINOR <input type="checkbox"/> MAJOR <input type="checkbox"/> SAFETY			
29. RESPONSIBLE ENGINEER <i>John Brown</i>		ORG <i>22-13</i>	DATE <i>1/27/82</i>	30. SPACECRAFT SYSTEM ENGR <i>J. Brown</i>	
31. RELIABILITY		ORG	DATE	40. CUSTOMER OR SUPPLIER	

ORIGINAL PAGE IS
OF POOR QUALITY

HUGHES
HUGHES AIRCRAFT COMPANY

SPACE AND COMMUNICATION GROUP
FAILURE REPORT

F 2723

1. PROGRAM NAME AND NUMBER TM PL1162		2. GLA V411		3. MODEL FL7		4. TIME OBSERVED 8:30		5. DATE OBSERVED 12/23/81	
6. HARDWARE LEVEL WHEN FAILURE WAS OBSERVED <input type="checkbox"/> SPACECRAFT <input type="checkbox"/> SYSTEM <input type="checkbox"/> SUBSYSTEM <input type="checkbox"/> UNIT <input type="checkbox"/> ASSEMBLY <input type="checkbox"/> SUBASSEMBLY <input type="checkbox"/> MODULE <input type="checkbox"/> INCAM <input checked="" type="checkbox"/> CARD <input type="checkbox"/> PART									
EQUIPMENT IDENTIFICATION:									
7. SUBSYSTEM		NAME		PART NUMBER		SN		MANUFACTURER	
8. UNIT									
9. <input type="checkbox"/> ASSEMBLY <input type="checkbox"/> SUBASSEMBLY									
10. <input type="checkbox"/> MODULE <input type="checkbox"/> INCAM <input checked="" type="checkbox"/> CARD		Calibration Shutter		50916		201		SBRC	
11. OTHER									
12. TEST WHEN FAILURE WAS OBSERVED <input type="checkbox"/> DEVELOPMENT <input type="checkbox"/> IN PROGRESS <input checked="" type="checkbox"/> ACCEPTANCE		<input type="checkbox"/> QUALIFICATION		<input type="checkbox"/> INTEGRATION		<input type="checkbox"/> LAUNCH OPERATIONS			
13. ENVIRONMENT WHEN FAILURE WAS OBSERVED <input checked="" type="checkbox"/> AMBIENT <input type="checkbox"/> EMC/RFI <input type="checkbox"/> RADIATION <input type="checkbox"/> VIBRATION		<input type="checkbox"/> TEMPERATURE		<input type="checkbox"/> THERMAL VAC		<input type="checkbox"/> HRS. AT			
14. DESCRIPTION OF FAILURE		Observed improper current peak amplitude.							
15. TEST PROCEDURE 16238		PARA 3.3.8		16. ORIGINATOR John Evans		ORG 2213		DATE 12/23/81	
17. VERIFICATION AND FAILURE ANALYSIS		Incorrect Values For Resistors R119 & R109 are 5.1KΩ should be 5.1KΩ							
18. FOLLOWING REWORK/RETEST REQUIRED (REWORK/RETEST NOT REQUIRED BECAUSE)		19. FAILED ITEM NAME AND PART NUMBER							
<input checked="" type="checkbox"/> Rework/Retest Required		Remove & Replace R119 & R109 Per Assembly drawing 50916							
<input checked="" type="checkbox"/> Rework/Retest Not Required		Replace due to overstress Q12 & Q14, Replace due to possible overstress Q13, Q15, Q18, Q21, Q11							
20. AUTHORIZATION Evans		ORG 2213		DATE 12/23/81		21. CONTINUATION SHEET USED			
22. REWORK/RETEST ACTION TAKEN		23. CA REVISIONS							
Remove & Replace R119, R109, Q12, Q14, Q13, Q15, Q18, Q21, Q11 Retest Per TP 16238 3.3.8		107							
24. LIST ALL PARTS REPLACED									
PART NUMBER		CXT SYM		PART LOT NO.		DATE CODE		ANALYSIS NO.	
908006-3		Q11,13,15,18							
708909-1		Q21,13,14							
25. REWORK BY H. Sander		ORG 2213		DATE 11-26-82		26. RETESTED BY Evans		ORG 2213	
27. CAUSE AND CORRECTIVE ACTION		28. CONTINUATION SHEET USED							
REFER TO IDC # PE 15:82 FROM L. O'CONNELL TO O.I. NARANDA. (COPY ATTACHED)		<input type="checkbox"/>							
29. FAILURE TYPE <input checked="" type="checkbox"/> PRIMARY <input type="checkbox"/> INDUCED <input type="checkbox"/> UNKNOWN <input type="checkbox"/> NO FAILURE		30. FAILURE CLASSIFICATION <input type="checkbox"/> CRITICAL <input type="checkbox"/> MAJOR <input checked="" type="checkbox"/> MINOR <input type="checkbox"/> SAFETY		31. FAILURE CLOSURE					
EO 1327A WAS NOT INCORPORATED INTO AHR		2/2/82 CLOSER REVIEW OF AHR. RECD.							
32. DOCUMENT IMPLEMENTING CORRECTIVE ACTION		33. CONTINUATION SHEET USED							
IDC # PE 15:82 (COPY ATTACHED)		<input type="checkbox"/>							
34. BASIC CAUSE OF FAILURE VERIFIED <input type="checkbox"/> DESIGN <input type="checkbox"/> ENVIRONMENTAL <input type="checkbox"/> DEFECTIVE PARTS <input type="checkbox"/> TEST EQUIP. <input type="checkbox"/> TEST PROC. <input type="checkbox"/> TEST SET-UP <input checked="" type="checkbox"/> MFG. PROCEDURE <input type="checkbox"/> ASSEMBLY ERROR <input checked="" type="checkbox"/> WORKMANSHIP <input type="checkbox"/> WIRING ERROR <input type="checkbox"/> ROUGH HANDLING <input type="checkbox"/> WEAR-OUT <input type="checkbox"/> UNKNOWN <input type="checkbox"/> DEFECT CODE									
35. RESPONSIBLE ENGINEER John Evans		ORG 22-13		DATE 11/27/82		36. SPACECRAFT SYSTEM ENG John Evans		ORG SBRC	
37. RELIABILITY Evans		ORG 157-41		DATE 2/1/82		38. CUSTOMER OR SUPPLIER SBRC		DATE 2/2/82	

ORIGINAL PAGE IS
OF POOR QUALITY

SANTA BARBARA RESEARCH CENTER
A Subsidiary of Hughes Aircraft Company
INTERNAL MEMORANDUM

TO: O.I. Nakano

CC: D. Adams
L. Altman

DATE: 1 February 1982

REF: PE 15:82

SUBJECT: Failure Reports F2723,
F2724 and S8051


FROM: L. O'Connell
51-41

BLDG. B-11 MAIL STA. 39
EXT. 6357

This is to confirm our Tel-Con of February 1, 1982 regarding subject Failure Reports.

As I stated to you all three Failure Reports were written against the same printed wiring board (P/N 50916, S/N 201). The cause of the test failures in each case was the installation of an incorrect resistor.

Contract quantities of subject boards have been completed. However, to help you preclude reoccurrence of this type of discrepancy on future orders or current production, copies of subject Failure Reports are attached so you can discuss the problem with Responsible Manufacturing Supervision.

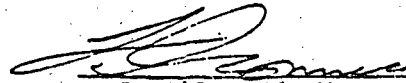

L. O'Connell, Manager
Administration and Reliability
Thematic Mapper Program

LO:jc

ORIGINAL PAGE IS
OF POOR QUALITY

HUGHES

HUGHES AIRCRAFT COMPANY

SPACE AND COMMUNICATION GROUP
FAILURE REPORT

F 2724

1. PROGRAM NAME AND NUMBER TM PL1162		2. GLA V411		3. MODEL FLT		4. TIME OBSERVED 2:30		5. DATE OBSERVED 1 MO/13 ON 82							
6. HARDWARE LEVEL WHEN FAILURE WAS OBSERVED		<input type="checkbox"/> SPACECRAFT <input type="checkbox"/> SYSTEM		<input type="checkbox"/> SUBSYSTEM <input type="checkbox"/> UNIT		<input type="checkbox"/> ASSEMBLY <input type="checkbox"/> SUBASSEMBLY		<input type="checkbox"/> MODULE <input type="checkbox"/> MICAM <input checked="" type="checkbox"/> CARD <input type="checkbox"/> PART							
EQUIPMENT IDENTIFICATION:															
7. SUBSYSTEM		NAME			PART NUMBER		SPN		MANUFACTURER						
8. UNIT															
9. <input type="checkbox"/> ASSEMBLY <input type="checkbox"/> SUBASSEMBLY															
10. <input type="checkbox"/> MODULE <input type="checkbox"/> MICAM <input checked="" type="checkbox"/> CARD		Cal. Shutter Main			50916		201		SBRC						
11. OTHER															
12. TEST WHEN FAILURE WAS OBSERVED		<input type="checkbox"/> DEVELOPMENT <input type="checkbox"/> IN-PROCESS		<input type="checkbox"/> QUALIFICATION <input type="checkbox"/> ACCEPTANCE		<input type="checkbox"/> INTEGRATION <input type="checkbox"/> SYSTEM		<input type="checkbox"/> LAUNCH OPERATIONS							
13. ENVIRONMENT WHEN FAILURE WAS OBSERVED		<input checked="" type="checkbox"/> AMBIENT <input type="checkbox"/> EMC/RFI		<input type="checkbox"/> RADIATION <input type="checkbox"/> VIBRATION		<input type="checkbox"/> TEMPERATURE AXIS FOR _____ MIN TYPE _____		<input type="checkbox"/> THERMAL VAC _____ HRS. AT _____		<input type="checkbox"/> OTHER					
14. DESCRIPTION OF FAILURE		Phase offset unable to Adj. properly. Visual inspection showed R24 to be wrong value is 30KΩ should be 10KΩ													
15. TEST PROCEDURES		16238		PARA 3.4.2.2		16. ORIGINATOR L Crane		ORG 2213 DATE 1/13/82		<input checked="" type="checkbox"/> CONTINUATION SHEET USED					
18. VERIFICATION AND FAILURE ANALYSIS		No stress to components. Rework to print. Install 10KΩ for R24													
19. FAILED ITEM NAME AND PART NUMBER															
20. <input checked="" type="checkbox"/> FOLLOWING REWORK/RETEST REQUIRED <input type="checkbox"/> REWORK/RETEST NOT REQUIRED BECAUSE		Remove and replace R24 per Assembly drawing-50916 Retest per TP16238 PARA 3.4.2.2													
21. AUTHORIZATION		L Crane		ORG 2213 DATE 1/13/82		22. CA REVIEWED 1/13/82		23. CA RETESTED 1/13/82		<input checked="" type="checkbox"/> CONTINUATION SHEET USED					
22. REWORK/RETEST ACTION TAKEN		R24 removed and replaced replaced with proper R24 Retested per TP16238 Para 3.4.2.2.													
24. LIST ALL PARTS REPLACED		PART NUMBER		CKT SYM		PART LOT NO.		DATE CODE		MFR		PROBABLE DEFECT		ANALYSIS NO.	
		R24													
27. REWORK BY		M. Davis		ORG 22-741 DATE 1-13-82		28. RETESTED BY L Crane		ORG 2213 DATE 1/13/82		<input checked="" type="checkbox"/> CONTINUATION SHEET USED					
29. CAUSE AND CORRECTIVE ACTION		REFER TO ITC # PE 15122 FROM LUDWIG & C - TO OTC. MONTANA (COPY ATTACHED) - 1/4-61 3-16-52													
30. OPERATOR AND QA ERROR		R24 SHOULD HAVE BEEN CHANGED PER ATR SUP'L NO 4. MONTANA													
32. DOCUMENT IMPLEMENTING CORRECTIVE ACTION		ITC # PE 15122 (COPY ATTACHED)													
34. BASIC CAUSE OF VERIFIED FAILURE		<input type="checkbox"/> DESIGN <input type="checkbox"/> ENVIRONMENTAL <input type="checkbox"/> DEFECTIVE PARTS		<input type="checkbox"/> TEST EQUIP <input type="checkbox"/> TEST PROC. <input type="checkbox"/> TEST SET-UP		<input type="checkbox"/> MFG. PROCEDURE <input type="checkbox"/> ASY/PAB ERROR <input checked="" type="checkbox"/> WORKMANSHIP		<input type="checkbox"/> WIRING ERROR <input type="checkbox"/> ROUGH HANDLING <input type="checkbox"/> WEAR-OUT		<input type="checkbox"/> UNKNOWN <input type="checkbox"/> DEFECT CODE					
36. FAILURE TYPE		<input checked="" type="checkbox"/> PRIMARY <input type="checkbox"/> INDUCED		<input type="checkbox"/> UNKNOWN <input type="checkbox"/> NO FAILURE		38. FAILURE CLASSIFICATION		<input type="checkbox"/> CRITICAL <input type="checkbox"/> MAJOR		<input checked="" type="checkbox"/> MINOR <input type="checkbox"/> SAFETY					
37. RESPONSIBLE ENGINEER		L Crane		ORG 22-13 DATE 1/12/82		39. SPACECRAFT SYSTEM ENGR L Crane		ORG 2213 DATE 1/12/82		40. CUSTOMER OR SUPPLIER SBRC					
38. RELIABILITY		51-41		DATE 2/1/82		40. CUSTOMER OR SUPPLIER SBRC		DATE 2/2/82							

SANTA BARBARA RESEARCH CENTER
A Subsidiary of Hughes Aircraft Company
INTERNAL MEMORANDUM

TO: O.I. Nakano

CC: D. Adams
L. Altman

DATE: 1 February 1982

REF: PE 15:82

SUBJECT: Failure Reports F2723,
F2724 and S8051

FROM: L. O'Connell
51-41

BLDG. B-11 MAIL STA.
EXT. 6357

This is to confirm our Tel-Con of February 1, 1982 regarding subject Failure Reports.

As I stated to you all three Failure Reports were written against the same printed wiring board (P/N 50916, S/N 201). The cause of the test failures in each case was the installation of an incorrect resistor.

Contract quantities of subject boards have been completed. However, to help you preclude reoccurrence of this type of discrepancy on future orders or current production, copies of subject Failure Reports are attached so you can discuss the problem with Responsible Manufacturing Supervision.



L. O'Connell, Manager
Administration and Reliability
Thematic Mapper Program

LO:jc

ORIGINAL PAGE IS
OF POOR QUALITY

HUGHES

SPACE AND COMMUNICATIONS GROUP
FAILURE REPORT

ORIGINAL PAGE IS
OF POOR QUALITY

HUGHES AIRCRAFT COMPANY
SPACE AND COMMUNICATIONS GROUP
EL SEGUNDO, CALIFORNIA

S 8049

1. PROGRAM NAME AND NUMBER TM PL 1162		2. GLA V411	3. MODEL F1	4. TIME OBSERVED 7:37	5. DATE OBSERVED MO 11 DA 6 YR 81	
6. HARDWARE LEVEL WHEN FAILURE WAS OBSERVED <input type="checkbox"/> SPACECRAFT <input type="checkbox"/> SYSTEM		<input type="checkbox"/> SUBSYSTEM <input type="checkbox"/> UNIT	<input type="checkbox"/> ASSEMBLY <input type="checkbox"/> SUBASSEMBLY	<input type="checkbox"/> MODULE <input type="checkbox"/> MICAM	<input checked="" type="checkbox"/> CARD <input type="checkbox"/> PART	
EQUIPMENT IDENTIFICATION: NAME PART NUMBER S/N MANUFACTURER						
7. SUBSYSTEM						
8. UNIT						
9. <input type="checkbox"/> ASSEMBLY <input type="checkbox"/> SUBASSEMBLY						
10. <input type="checkbox"/> MODULE <input type="checkbox"/> MICAM <input checked="" type="checkbox"/> CARD SLC PWB ASSY 52250-1 201 SBC						
11. OTHER						
12. TEST WHEN FAILURE WAS OBSERVED <input type="checkbox"/> DEVELOPMENT <input type="checkbox"/> QUALIFICATION <input checked="" type="checkbox"/> INTEGRATION <input type="checkbox"/> LAUNCH OPERATIONS <input checked="" type="checkbox"/> IN-PROCESS <input type="checkbox"/> ACCEPTANCE <input type="checkbox"/> SYSTEM						
13. ENVIRONMENT WHEN FAILURE WAS OBSERVED <input checked="" type="checkbox"/> AMBIENT <input type="checkbox"/> RADIATION <input type="checkbox"/> VIBRATION <input type="checkbox"/> TEMP. <input type="checkbox"/> THERMAL VAC. <input type="checkbox"/> HRS AT <input type="checkbox"/> OTHER <input type="checkbox"/> EMC/RR <input type="checkbox"/> VIBRATION AXIS FOR MIN TYPE						
14. DESCRIPTION OF FAILURE Observed improper waveform during test. Upon examination of test set up found scope ground shorting to K3 pin 4						
15. TEST PROCEDURE 16520		16. PARA 4.2.2.6	18. ORIGINATOR L. Evans	19. ORG 22-13	17. DATE 11/6/81	
17. CONTINUATION SHEET USED <input type="checkbox"/>						
18. VERIFICATION AND FAILURE ANALYSIS K3 Should Be Replaced, REMOVED AND REPLACED Crad metered ok (mm) U2 To be replaced due to possible overstress R14 (6.49m, 2w, 1.9a, ^{5.4018} 6.49m RD) TO BE REPLACED DUE TO POSSIBLE OVERSTRESS REF: HS236-7718 STRESS ANALYSIS (ATTACHED)						
19. FAILED ITEM NAME AND PART NUMBER U1, U2, K3, R14 4021080843 (0104465024/190819/81)						
20. FOLLOWING REWORK/RETEST REQUIRED <input type="checkbox"/> REWORK/RETEST NOT REQUIRED BECAUSE Remove and replace U1, U2, K3, R14 NO COMPONENTS FAILED						
21. AUTHORIZATION L. Evans 22-13 11/6/81						
22. CONTINUATION SHEET USED <input type="checkbox"/>						
23. Rework/Retest Action Taken Removed and replaced U1, U2, K3, R14 Retested to Test Procedure 16520 Para 4.5.1 (SEE ATTACHED DATA)						
24. QA REQUEST 110						
25. QA RETEST 110						
26. LIST ALL PARTS REPLACED						
PART NUMBER	CKT SYM	PART LOT NUMBER	DATE CODE	MANUFACTURER	PROBABLE DEFECT	ANALYSIS NUMBER
K3, 908311-5		7326K 33	752303	AME Pittsboro	POSSIBLE overstress. To contacts	
U2, 909 955-1					POSSIBLE overstress	
R14					POSSIBLE OVERSTRESS	
27. REWORK BY M. Guerra		28. ORG 22-74	29. DATE 11/17/81	30. RETESTED BY L. Evans		31. ORG 22-13
						32. DATE 11/17/81
33. CAUSE AND CORRECTIVE ACTION Incorrect test setup. Carefully insure test set up prior to initiation of test. TECHNICIAN'S WERE CAUTIONED TO CHECK TEST-SET UP PRIOR TO TEST. NO OTHER COMPONENTS OTHER THAN THE FOUR WERE FOUND TO BE OVERSTRESSED.						
34. FRB CLOSURE						
35. CONTINUATION SHEET USED <input type="checkbox"/>						
36. DOCUMENT IMPLEMENTING CORRECTIVE ACTION HS236-7718 (COPY ATTACHED)						
37. BASIC CAUSE OF VERIFIED FAILURE <input type="checkbox"/> DESIGN ENVIRONMENTAL DEFECTIVE PARTS		<input type="checkbox"/> TEST EQUIPMENT <input type="checkbox"/> TEST PROCEDURE <input checked="" type="checkbox"/> TEST SET-UP	<input type="checkbox"/> MFG. PROCEDURE <input type="checkbox"/> ASSY/FAB ERROR <input type="checkbox"/> WORKMANSHIP	<input type="checkbox"/> WIRING ERROR <input type="checkbox"/> ROUGH HANDLING <input type="checkbox"/> WEAR-OUT	<input type="checkbox"/> UNKNOWN	DEFECT CODE
38. FAILURE TYPE <input checked="" type="checkbox"/> PRIMARY <input type="checkbox"/> INDUCED		<input type="checkbox"/> UNKNOWN <input type="checkbox"/> NO FAILURE	39. FAILURE CLASSIFICATION <input type="checkbox"/> CRITICAL <input checked="" type="checkbox"/> MAJOR		<input type="checkbox"/> MINOR <input type="checkbox"/> SAFETY	
37. RESPONSIBLE ENGINEER L. Evans		38. ORG 22-13	39. DATE 11/17/81	40. SPACECRAFT SYSTEM ENGINEER L. Evans		41. ORG 22-41
						42. DATE 11/17/81
39. FACILITY 1000		40. ORG 51-41	41. DATE 11/18/81	42. SUPPLIER OR SUPPLIER R.E.		43. DATE

ORIGINAL PAGE IS
OF POOR QUALITY

SANTA BARBARA RESEARCH CENTER
A Subsidiary of Hughes Aircraft Company
INTERNAL MEMORANDUM

5 8049

TO: L. O'Connell

CC: Altman, L.
Banach, J.A.
Barnett, G.C.
Day, J.G.
Evans, L.B.
Wolthausen, L.H.
Data Bank

DATE: 12 November 1981

REF: HS236-7718
REAH 81/59

FROM: A. Huber

BLDG. B-11 MAIL STA. 102
EXT. 6246

FR: S8049, dated November 6, 1981

The failure occurred when performing optical/electrical calibration of the scan line corrector subassembly, with the scan line corrector board (assy. no. 52250-1, S/N 201) mounted in the SLC test box and receiving +19V power (actually +21V) from a power supply within the test box. At the time of the failure two (2) oscilloscope probes were attached to test points at the top of the board and signals were being monitored on the oscilloscope display. The SLC motor and mirrors were in operation. With the occurrence of the failure the display went blank and SLC motor/mirror operation ceased. It was estimated that test equipment power was turned OFF within 15 seconds of the occurrence of the failure.

Investigation of the scan line corrector board found the ground lead of an oscilloscope probe in contact with the +19V on the SLC board, shorting the test equipment +19V power supply to signal ground and causing the +19V fuse (3 amp) to open. Figure 1 illustrates the point at which the short occurred (pin 4 of relay K3). Measurement of the resistances from (through) the SLC connector pins, to the input of relay K3, indicated nearly identical resistances for the '+19V' and '-19V' lines (0.061 ohms, connector pin 22 to relay pin 3; 0.058 ohms, connector pin 23 to relay pin 2). Measurement of the contact resistances of K3 indicated 0.013 ohms (pin 3 to pin 4) versus 0.010 ohms (pin 2 to pin 5). Subsequent testing of the board after the fuse was replaced (and before any components were replaced) revealed no change in board performance as a result of the failure.

Four components were eventually replaced: (1), relay K3; (2), voltage regulator U2; (3), voltage regulator U1; and (4), resistor R14 (6.49 ohms, 2w, 1%), appearing on motor driver assembly 54018, part of SLC board assembly 52250.

Relay K3 was replaced because of the possibility that the short circuit surge current from the 27,000 μ f power supply capacitor caused some degradation of the relay contacts.

Voltage regulator U2 (LM125) was replaced because of a possible overstress of Q12 within U2. This component, Q12, has a capability of approximately 30ma to 40ma (National Semiconductor, Tim Reagan, 408-737-5000 x 3887) and may have experienced a surge of 450 ma, depending upon the position of the SLC motor at the time of the failure. A second reason for replacement of this part was the possibility of excessive input voltage (greater than 30V) due to an inductive transient from the short circuit surge current. This latter possibility was also the reason for replacing the other LM125 voltage regulator, U1.

The resistor R14 (6.49 ohm, 1%) was replaced because in the presence of a short circuited +19V, the SLC motor driver produces a steady-state output as shown

FR: S8094
A. Huber, to L. O'Connell

HS 236-7718
Page 2

58049

in Figure 2, resulting in a power dissipation of 2.5w for R14. This component has a manufacturer's rating of 2w.

All other components of the SLC board were analyzed for possible overstress. No other components (other than the four that were replaced) were found to have been possibly overstressed.

Andrew E. Huber
A. Huber

AH:jc

ORIGINAL PAGE IS
OF POOR QUALITY

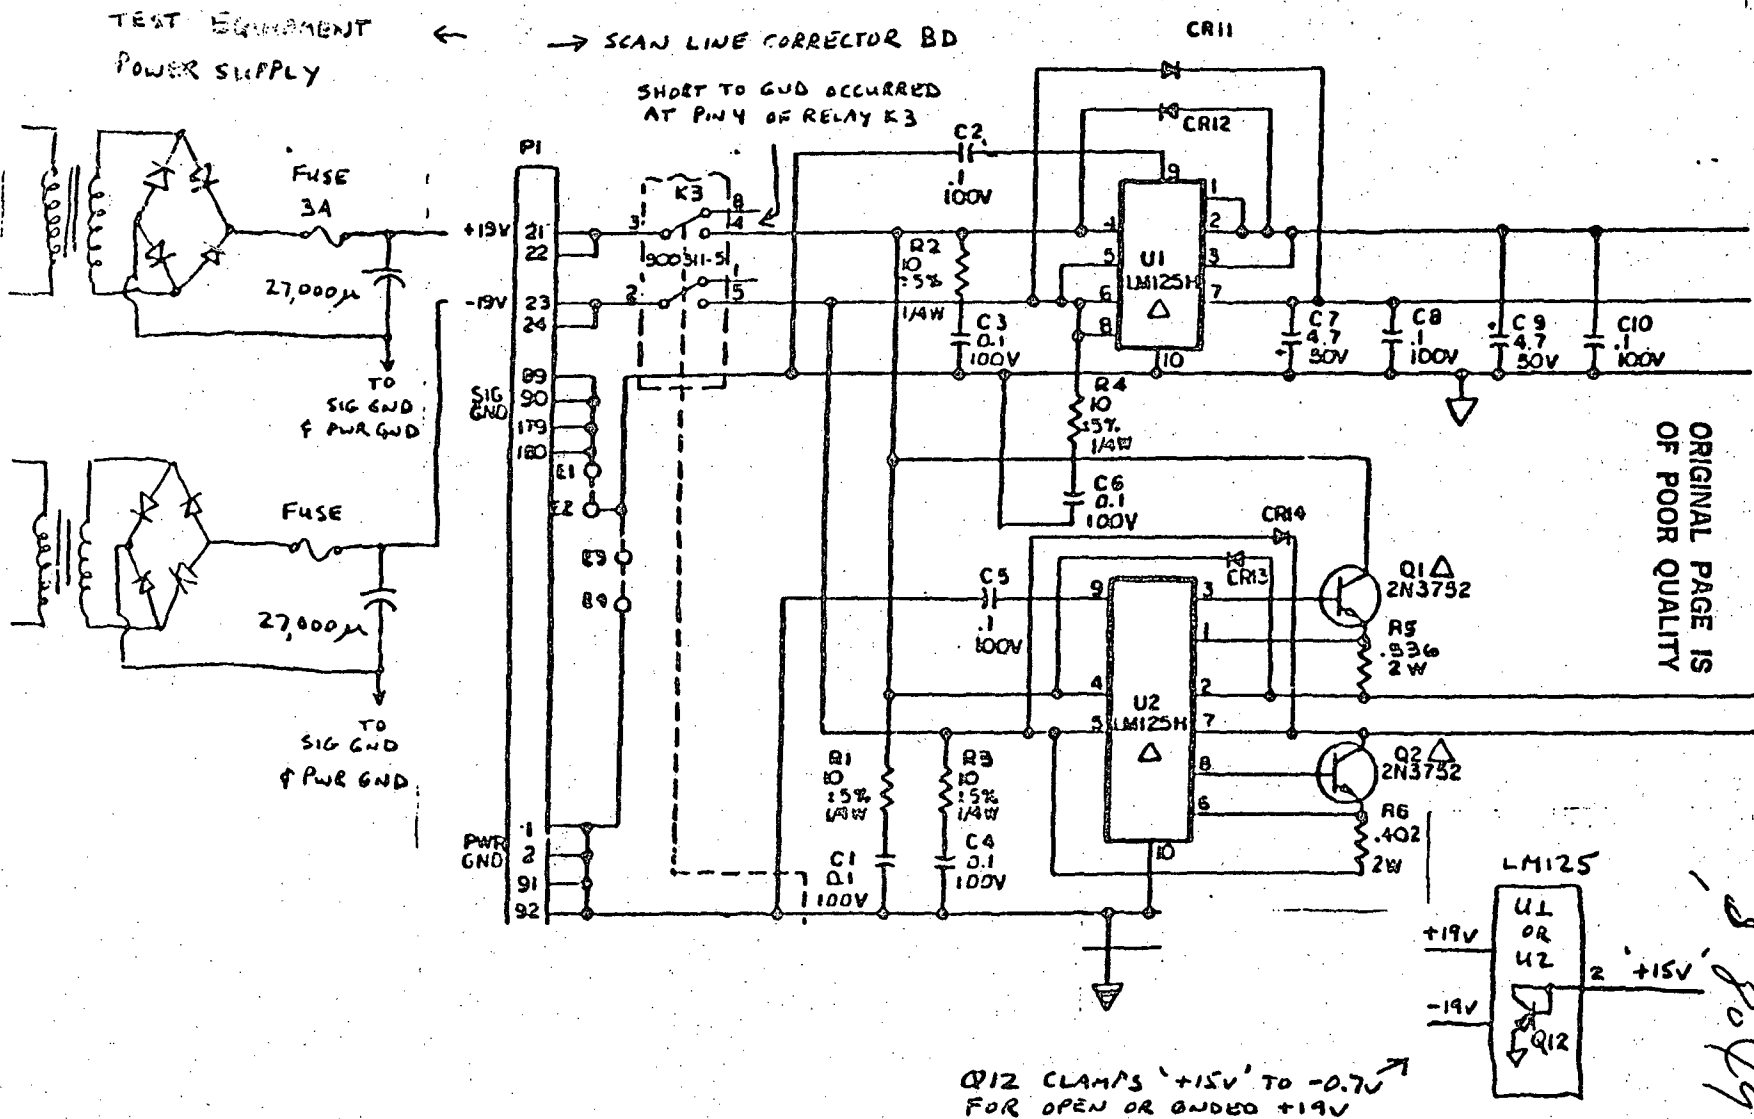


FIGURE 1. SLIC ±19V POWER INPUT CIRCUITRY, ILLUSTRATING POINT AT WHICH FAILURE OCCURRED

5 8049

ORIGINAL PAGE IS
OF POOR QUALITY

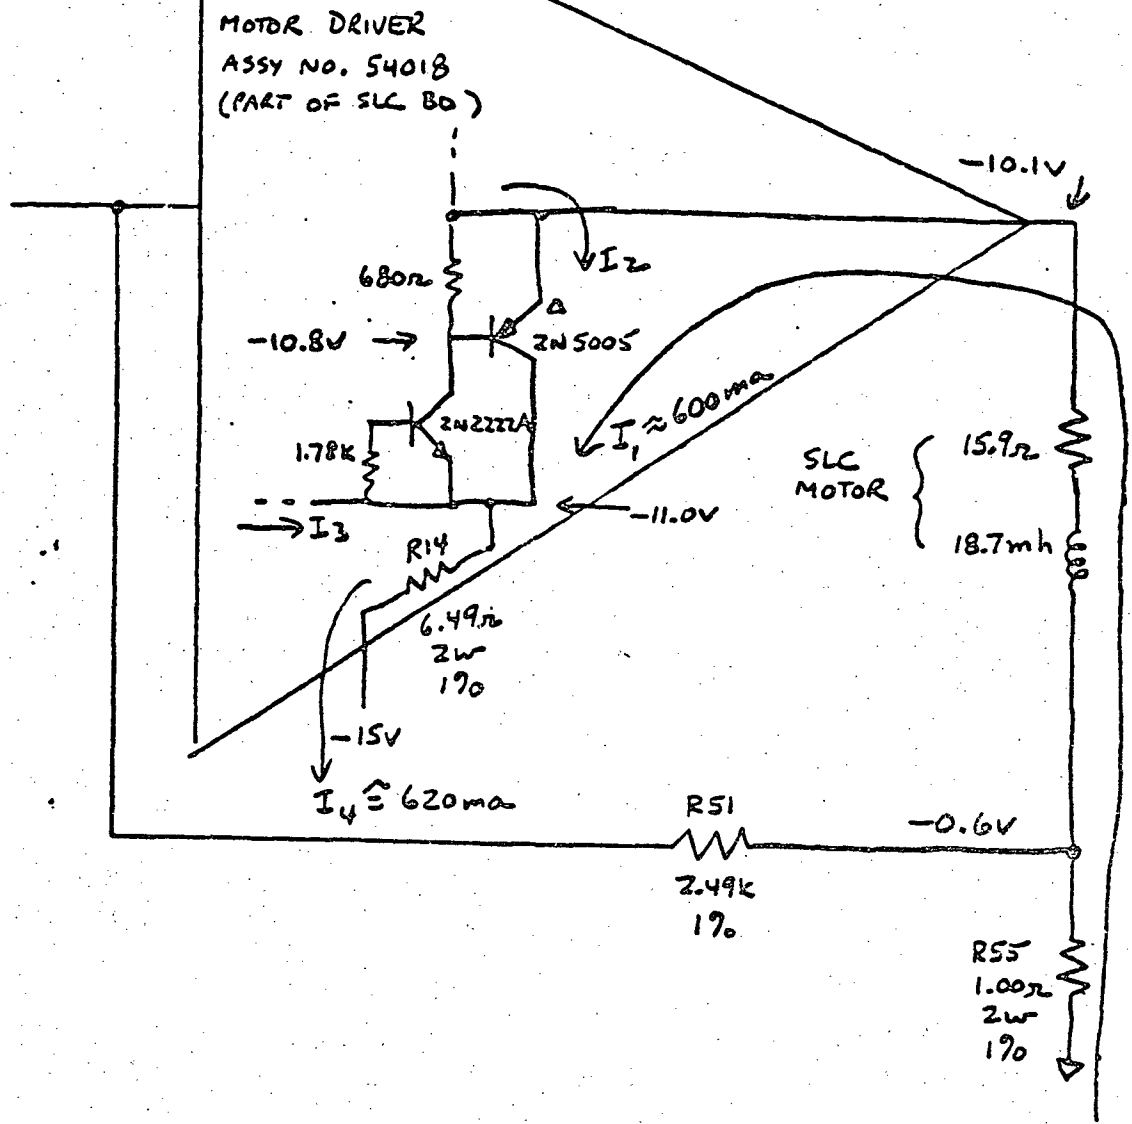


FIGURE 2. MOTOR DRIVER STEADY-STATE OUTPUT FOR
+14V SHORT TO GND

C-2

4.5.1 Track Rate, Linearity, and Overlap/Underlap

5' 8049
11/17/81
45

FINAL LINEARITY DATA

ORIGINAL PAGE IS
OF POOR QUALITY

J. CYCLES	200					
ET. NO.	1	ERROR FRACT. +	5.41			
QUNT MEAN	1128.92	COUNT MAX	1130	COUNT MIN	1128	CNT STD DEV .2
ET. NO.	2	ERROR FRACT. +	5.93			
QUNT MEAN	1764.96	COUNT MAX	1765	COUNT MIN	1764	CNT STD DEV .1
ET. NO.	3	ERROR FRACT. +	5.16			
QUNT MEAN	2485.04	COUNT MAX	2486	COUNT MIN	2485	CNT STD DEV .1
ET. NO.	4	ERROR FRACT. +	4.78			
QUNT MEAN	3054.19	COUNT MAX	3055	COUNT MIN	3054	CNT STD DEV 3.9
ET. NO.	5	ERROR FRACT. +	4.38			
QUNT MEAN	3700.84	COUNT MAX	3701	COUNT MIN	3700	CNT STD DEV .3
ET. NO.	6	ERROR FRACT. +	4.19			
QUNT MEAN	4257.99	COUNT MAX	4258	COUNT MIN	4257	CNT STD DEV 4.6
ET. NO.	7	ERROR FRACT. +	3.92			
QUNT MEAN	4882.04	COUNT MAX	4883	COUNT MIN	4882	CNT STD DEV 4.9
ET. NO.	8	ERROR FRACT. +	4.23			
QUNT MEAN	5570.99	COUNT MAX	5571	COUNT MIN	5570	CNT STD DEV .
ET. NO.	9	ERROR FRACT. +	4.51			
QUNT MEAN	6120.06	COUNT MAX	6121	COUNT MIN	6120	CNT STD DEV .2
ET. NO.	10	ERROR FRACT. +	5.15			
QUNT MEAN	6759.24	COUNT MAX	6760	COUNT MIN	6759	CNT STD DEV .4

SIZE A	CODE IDENT NO 11323	NUMBER 11615
SCALE	REV A	SHEET 8



4.5.1 Track Rate, Linearity, and Overlap/Underlap

51
8049

FINAL LINEARITY DATA

ORIGINAL PAGE IS
OF POOR QUALITY

D. CYCLES		200					
ET. NO.	1	ERROR FRACT. +	5.33				
JUNT MEAN	1128.03	COUNT MAX	1129	COUNT MIN	1128	CNT STD DEV	2
ET. NO.	2	ERROR FRACT. +	5.93				
JUNT MEAN	1765.00	COUNT MAX	1765	COUNT MIN	1765	CNT STD DEV	
ET. NO.	3	ERROR FRACT. +	5.17				
JUNT MEAN	2485.09	COUNT MAX	2486	COUNT MIN	2485	CNT STD DEV	3
ET. NO.	4	ERROR FRACT. +	4.77				
JUNT MEAN	3054.03	COUNT MAX	3055	COUNT MIN	3054	CNT STD DEV	
ET. NO.	5	ERROR FRACT. +	4.38				
JUNT MEAN	3700.84	COUNT MAX	3701	COUNT MIN	3700	CNT STD DEV	
ET. NO.	6	ERROR FRACT. +	4.29				
JUNT MEAN	4258.95	COUNT MAX	4259	COUNT MIN	4258	CNT STD DEV	
ET. NO.	7	ERROR FRACT. +	3.92				
JUNT MEAN	4882.04	COUNT MAX	4883	COUNT MIN	4882	CNT STD DEV	
ET. NO.	8	ERROR FRACT. +	4.15				
JUNT MEAN	5570.04	COUNT MAX	5571	COUNT MIN	5570	CNT STD DEV	5.
ET. NO.	9	ERROR FRACT. +	4.59				
JUNT MEAN	6120.98	COUNT MAX	6121	COUNT MIN	6120	CNT STD DEV	5.
ET. NO.	10	ERROR FRACT. +	5.22				
JUNT MEAN	6759.97	COUNT MAX	6760	COUNT MIN	6759	CNT STD DEV	

SIZE	CODE IDENT NO	NUMBER
A	11323	11615
SCALE	REV A	SHEET 8



HUGHES

ORIGINAL PAGE IS OF POOR QUALITY
SPACE AND COMMUNICATIONS GROUP
FAILURE REPORT

ORIGINAL PAGE IS OF POOR QUALITY
S 8050

HUGHES AIRCRAFT COMPANY
SPACE AND COMMUNICATIONS GROUP
EL SEGUNDO, CALIFORNIA

1. PROGRAM NAME AND NUMBER TM PL1162		2. GLA V411		3. MODEL P1		4. TIME OBSERVED 3:30		5. DATE OBSERVED MO 11 DA 20 YR 81		
6. HARDWARE LEVEL WHEN FAILURE WAS OBSERVED <input type="checkbox"/> SPACECRAFT <input type="checkbox"/> SYSTEM		<input type="checkbox"/> SUBSYSTEM <input type="checkbox"/> UNIT		<input type="checkbox"/> ASSEMBLY <input type="checkbox"/> SUBASSEMBLY		<input type="checkbox"/> MODULE <input type="checkbox"/> MICAM		<input type="checkbox"/> CARD <input type="checkbox"/> PART		
EQUIPMENT IDENTIFICATION:										
7. SUBSYSTEM		NAME			PART NUMBER		S/N		MANUFACTURER	
8. UNIT										
9. <input type="checkbox"/> ASSEMBLY <input type="checkbox"/> SUBASSEMBLY										
10. <input type="checkbox"/> MODULE <input type="checkbox"/> MICAM <input checked="" type="checkbox"/> CARD SLC PWB Assy										
11. OTHER		52250-2			201		SORC			
12. TEST WHEN FAILURE WAS OBSERVED <input type="checkbox"/> DEVELOPMENT <input checked="" type="checkbox"/> IN-PROCESS		<input type="checkbox"/> QUALIFICATION <input type="checkbox"/> ACCEPTANCE		<input checked="" type="checkbox"/> INTEGRATION <input type="checkbox"/> SYSTEM		<input type="checkbox"/> LAUNCH OPERATIONS				
13. ENVIRONMENT WHEN FAILURE WAS OBSERVED <input type="checkbox"/> AMBIENT <input type="checkbox"/> EMC/RFI		<input type="checkbox"/> RADIATION <input type="checkbox"/> VIBRATION		<input checked="" type="checkbox"/> TEMP 50 °C AXIS FOR _____ MIN TYPE _____		<input type="checkbox"/> THERMAL VAC _____ HRS AT _____		<input type="checkbox"/> OTHER		
14. DESCRIPTION OF FAILURE Observed improper linearity data over temperature per spec. 16123 as per Test Procedure 16520. Para 4.3										
15. TEST PROCEDURE 16520		PARA 4.3		16. ORIGINATOR Alfred Crane		ORG 2213		DATE 11/24/81		17. CONTINUATION SHEET USED <input type="checkbox"/>
18. VERIFICATION AND FAILURE ANALYSIS Excessive leakage current (500 @ +20°C, 1000 @ +50°C through DR18CAL (U13) switch contacts -2V to +13.6V. FAILURE CONFIRMED (FAR 9274)										
19. FAILED ITEM NAME AND PART NUMBER U13 JFET SWITCH 912922				20. <input checked="" type="checkbox"/> FOLLOWING REWORK/RETEST REQUIRED <input type="checkbox"/> REWORK/RETEST NOT REQUIRED BECAUSE Remove and replace U13 (912922-1) Retest per TP 16520 Para 4.3						
21. AUTHORIZATION Alfred Crane / J. A. Bonach				ORG 2213		DATE 11/25/81		22. CONTINUATION SHEET USED <input type="checkbox"/>		
23. REWORK/RETEST ACTION TAKEN REPLACED U13 PER AHR 52250-2, SUPPL 6 & TP 16520.4.3 REPLACED (RESELECTED) R32 TO 2.2K, 1% PER AHR 52250-2 OP. 7.150 ON QA COMMENT SHEET & TP 16520, 4.2.3										
24. <input checked="" type="checkbox"/> REWORK <input checked="" type="checkbox"/> RETEST										
25. MANUFACTURING AND TEST										
26. LIST ALL PARTS REPLACED		CXT SYM		PART LOT NUMBER		DATE CODE		MANUFACTURER		PROBABLE DEFECT
912922-1		U13		902495026		7913		SILICONIX		
SN 63347										
27. REWORK BY M. GUERRA		ORG 22-74		DATE 11-30-81		28. RETESTED BY L. EVANS		ORG 22-13		DATE 12-7-81
29. CAUSE AND CORRECTIVE ACTION CAUSED BY FAILURE OF P/N 912922 FET SWITCH, CONFIRMED BY FAR 9274. THIS IS CONSIDERED A RANDOM FAILURE THAT COULD HAVE BEEN CAUSED IN ASSEMBLY OF THE FET SWITCH. NO CORRECTIVE ACTION IS DEEMED NECESSARY UNLESS A REPEAT OF THIS FAILURE MECHANISM IS SEEN, AND THE RANDOM HYPOTHESIS IS DISCARDED. THIS		30. FRB CLOSURE		31. CONTINUATION SHEET USED <input type="checkbox"/>		32. DOCUMENT IMPLEMENTING CORRECTIVE ACTION				
33. BASIC CAUSE OF VERIFIED FAILURE <input type="checkbox"/> DESIGN <input type="checkbox"/> ENVIRONMENTAL <input checked="" type="checkbox"/> DEFECTIVE PARTS		34. TEST EQUIPMENT <input type="checkbox"/> TEST PROCEDURE <input type="checkbox"/> TEST SET-UP		35. MFG. PROCEDURE <input type="checkbox"/> ASSY/FAB ERROR <input type="checkbox"/> WORKMANSHIP		36. WIRING ERROR <input type="checkbox"/> ROUGH HANDLING <input type="checkbox"/> WEAR-OUT		37. UNKNOWN		DEFECT CODE
38. FAILURE TYPE <input checked="" type="checkbox"/> PRIMARY <input type="checkbox"/> INDUCED		39. UNKNOWN <input type="checkbox"/> NO FAILURE		40. FAILURE CLASSIFICATION <input type="checkbox"/> CRITICAL <input checked="" type="checkbox"/> MAJOR		41. MINOR <input type="checkbox"/> SAFETY				
42. RESPONSIBLE ENGINEER M. J. Sawicki		ORG 22-17		DATE 12-8-81		43. SPACECRAFT SYSTEM ENGINEER J. A. Bonach		ORG 2241		DATE 3/9/82
44. RELIABILITY C. Perlin		ORG 5141		DATE 03-08-82		45. TEST CENTER OR SUPPLIER AA				

HUGHES

HUGHES AIRCRAFT COMPANY
SPACE AND COMMUNICATIONS GROUP
EL SEGUNDO, CALIFORNIA

SPACE AND COMMUNICATIONS GROUP

**FAILURE REPORT
CONTINUATION SHEET**

FR SERIAL NO.

2050

CONTINUATION SHEET LETTER

*LABEL FIRST CONTINUATION SHEET USED 'A', SECOND 'B', AND SO ON

IDENTIFY ENTRIES BY REFERENCING FR BLOCK NUMBER IN COLUMN. DATE EACH ENTRY.

ADDITIONAL FR
CONTINUATION
SHEET(S) USED

30 WAS A VENDOR'S PROBLEM. HS 236-7891 ADVISOR
THE PART BOARD OF THIS PROBLEM.

ORIGINAL PAGE IS
OF POOR QUALITY

PART NO.	52250-2	PART NAME	ASSY/LOT SERIAL NO.	201	QTY	1
OPER NO.	DATE	OPERATOR	COMMENTS, TEST DATA, ETC	DISPOSITION	APPROVAL	
2106	11/18/81	[Signature]	U.S. hand washers that are bent.	P.R. removed to B/R & re-torque with G.A. meters	[Signature]	
	11/18/81	[Signature]				
	11/18/81	[Signature]	replaced washers			
2100	11/18/81	[Signature]	Clip lead left on back of small board.	P.R. Tester removed & return to Dept.	[Signature]	
	11/18/81	[Signature]	removed clip-lead			
3150	11/25/81	[Signature]	F/R 8050			
B	11-30-81		AS A RESULT OF REPLACING U13 PER FR 8050 SELECT RESISTORS R31 & R32 WILL REQUIRE RESELECTING AS FOLLOWS:		[Signature]	
3101	11-30-81	22-74	1. UNSOLDER R31, TACK SOLDER 28 AWG STANDOFF WIRES TO PADS & R31 TO WIRES.			
	11-30-81	M. Quinn	2. UNSOLDER R32, TACK SOLDER 28 AWG STANDOFF WIRES TO PADS & R32 TO WIRES.			
3102	11/30/81	22-13	TEST PER 16520 REV. A PARA 4.2.2 TO RESELECT R31 & R32 ENTER ON TEST DATA SHEET			
3103	12-1-81	m. monty 22-72	KIT AND ENTER NEW SELECTS ON ABCTR FROM TEST DATA RECORDS			

ORIGINAL PAGE IS OF POOR QUALITY

8050

SBRC

ASSEMBLY HISTORY RECORD SUPPLEMENT

SHEET 1 OF 4

PART NUMBER 52250-2	SERIAL OR LOT NUMBER 201	DRAWING NO. 52250	DRAWING REVISION C	REA SOURCE CODE 22-71	PREPARED BY G.W. CANNON	SUPPLEMENT NO. 6 TO AHR DATED 23 June 80
ASSEMBLY NAME PWB ASSEMBLY SCAN LINE CORRECTOR			APPROVED BY [Signature]	RESP. ENGR. APPROVAL [Signature]	QUALITY APPROVAL [Signature]	SUPPLEMENT RELEASE DATE 25 Nov. 81
PURPOSE OF SUPPLEMENT - INCORPORATES NEW ASSY DWG (REVISION 1) OR COST; REWORK 1; OTHER 0. EXPLAIN. FR S 8050				PRODUCTION APPROVAL [Signature]	PRODUCTION APPROVAL	NOTE TO PRODUCTION - UPON RECEIPT, ENTER SUPPLEMENT NO. AND RECEIPT DATE ON FRONT SHEET OF AHR. INITIAL THE ENTRY.
				OTHER [Signature]	OTHER	

NOTES: SAME AS ORIGINAL

OPER NO.	S/C NO.	INSTRUCTIONS	PERFORMED BY:			REMARKS
			OPER	INSP	DATE	
		REASON; Improper linearity data over temperature test.				
		PURPOSE: Perform test at 0°C and 50°C for voltage verification.				
		NOTIFY QA AND AF PRIOR TO TEST				
3105	22-13	1) Perform and record the following at 50°C with 108KHZ out and TP14 at +13V measure and record the following voltages;	[Signature]		11/25/81	[Signature]
			↓		↓	

ORIGINAL PAGE IS
OF POOR QUALITY

58050

SRRC

ASSEMBLY HISTORY RECORD CONTINUATION SHEET

SHEET 2 OF 4

PART NUMBER 52250-2	SERIAL OR LOT NUMBER 201	ASSEMBLY NAME PWB ASSEMBLY SCAN LINE CORRECTOR	CONTINUATION OF: AHR DATED AHR SUPPLEMENT NO. 6
------------------------	-----------------------------	--	---

OPER NO.	S/C NO.	INSTRUCTIONS	PERFORMED BY			REMARKS
			OPER	IIISP	DATE	
3105	Cor.	Junction of R31 and R32 <u>2.7430</u> V			11/23/61	
		Junction of R32 and R33 <u>2.0276</u> V				
		2) Repeat with 108KHZ out and TP14 at -2V--Record.				
		Junction of R31 and R32 <u>2.657</u> V				
		Junction of R32 and R33 <u>2.0065</u> V				
		3) Test at 0°C with 108KHZ out and TP14 at +13V-- Record.				
		Junction of R31 and R32 <u>2.6375</u> V				
		Junction of R32 and R33 <u>2.0272</u> V				
		4) Repeat with 108KHZ out and TP14 at -2V--Record.				
		Junction of R31 and R32 <u>2.6520</u> V				
		Junction of R32 and R33 <u>2.0075</u> V				
		Record change of parts as determined by above test.				
		REPLACE: <u>U13</u>				

ORIGINAL PAGE IS
OF POOR QUALITY

5
2050

SRRC

ASSEMBLY HISTORY RECORD CONTINUATION SHEET

SHEET 3 OF 4

PART NUMBER		SERIAL OR IOI NUMBER	ASSEMBLY NAME	CONTINUATION OF:		
52250-2		201	PWB ASSEMBLY SCAN LINE CORRECTOR	AIR DATED AIR SUPPLEMENT NO. 6		
OPER NO.	S/C NO.	INSTRUCTIONS	PERFORMED BY			REMARKS
			OPER	INSP	DATE	
3110	22-72	Kit and enter on ABC/TR the following: 1 EA 912922-1 IC U13 ITEM 25	Monty		11-2-81	
3115	51-11	Kit inspect.		(1) 117	11/2/81	
3120	22-74	Carefully remove the following part U13, bag, EAG and forward to Q.A.			11/2/81	
		U13 per B/P.			11/2/81	

ORIGINAL PAGE IS
OF POOR QUALITY

518050

ORIGINAL PAGE IS
OF POOR QUALITY

SBRC

REQUEST FOR SHIPMENT

58050
9249

THIS REQUEST MUST BE FILLED OUT COMPLETELY IN ACCORDANCE WITH THE INSTRUCTIONS ON THE REVERSE SIDE HEREOF
SHIPPING CANNOT PROCESS INCOMPLETE REQUESTS

DATE: 12-21-81

TO:
Hughes
El Segundo
Space Communication Div
Bldg S-41 Rm 1103C
1650 E Imperial Hwy
El Segundo, CA 90245

SHIPMENT REQUIRED AT DESTINATION BY: 12-23-81
THIS SHIPMENT IS AGAINST REQUIREMENTS OF:
W.A. NO. ACCT. NO.: ~~54011~~ V410-64-03
GOV'T CONT NO.: NAS 5-24300
CUSTOMER P.O.: 54011
SBRC P.O./P.A.: 54011
SHIPMENT TO BE: PREPAID COLLECT

SHIPMENT CLASSIFICATION

CONTRACT OR P.O. SHIPMENT IS: PARTIAL <input type="checkbox"/> FINAL <input checked="" type="checkbox"/> HAZARDOUS MAT'L <input type="checkbox"/> NON-HAZARDOUS <input checked="" type="checkbox"/>	SECURITY CLASSIFICATION: UNCLASSIFIED <input checked="" type="checkbox"/> CONFIDENTIAL <input type="checkbox"/> SECRET <input type="checkbox"/> REF SEC'Y PRACTICES NOS 11-2-1, 11-2-14	PROPERTY OWNERSHIP: COMPANY <input checked="" type="checkbox"/> IDENTIFIED <input type="checkbox"/> GOVERNMENT <input type="checkbox"/> DD 1149 <input type="checkbox"/> CUSTOMER OR SUPPLIER <input type="checkbox"/>	TYPE OF SHIPMENT: RTV <input type="checkbox"/> OUTSIDE PROCE <input type="checkbox"/> SALE <input type="checkbox"/> MISCELLANEOUS <input type="checkbox"/>
---	--	---	--

Q. PA CONTR SER NO.	QUANTITY				SBRC PIN	ITEM(S) DESCRIPTION	DC V.
	THIS SHIPMT	UNIT	ON ORD	BACK ORD'S			
	1	EA			90994-1	Shift Register	50
	1	EA			912922-1	I.C.	


To be shipped for Failure Analysis

SPECIAL SHIPPING, MARKING INSTRUCTIONS: Please place on SBRC Shuttle

SHIPMENT REQUESTED BY: Yender Bidge via m/czu DATE: 12/21/81 APPROVED BY: _____

5 2050

FAILURE ANALYSIS
REPORT

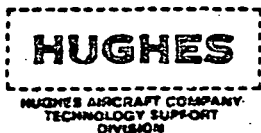

FAR No. 9274
Program: Thematic Map
Page 1 of 7

DATE OF RECEIPT <u>1-11-82</u>	TSD PROJECT ENGINEER <u>W. Gettys</u>
REQUESTER <u>H. Persh/F. Carle</u>	PHONE <u>6458194</u> BLDG./MS <u>STD/C340</u>
ORG <u>44-07</u> PHONE <u>6488388</u> BLDG./MS <u>S41/B355</u>	GLA/CMR <u>40930 (F263A2151)</u>
REA <u>Lionel Altman</u> PHONE _____	
COMPONENT <u>I.C. (1)</u>	FAILURE REFERENCE <u>FR S8050/FA82-006</u>
FUNCTION/TYPE <u>FET Switch</u>	DATE OF FAILURE <u>11-20-81</u>
GENERIC P/N <u>DG185AL</u>	FAILURE LEVEL <u>Card</u>
HUGHES P/N <u>912922</u>	LOT NUMBER <u>9C249-5026</u>
MFG. <u>Siliconix</u> P/N <u>S08531</u>	CIRCUIT SYMBOL <u>U13</u>
DATE C. JOE <u>7913</u> S/N <u>G3347</u>	MODULE <u>52250-2</u> S/N <u>201</u>

ABSTRACT

The reported failure, high "off" state leakage, was confirmed. Internal examination revealed a crack across the die which contained the driving circuitry for the defective output switch. It is believed that the leakage was due to this crack. This failure is judged to have been primary.

TECHNICAL COMMENTARY	<u>C. A. Edelman</u>	<u>L1153-121</u>	<u>E. G. Backes</u>	<u>2/15/82</u>
<input type="checkbox"/> NOT REQUIRED	C. A. Edelman	JOURNAL	APPROVAL	DATE
<input checked="" type="checkbox"/> APPENDED	FAILURE ANALYST			

52050

Reported Failure:

High "off" state leakage of 5uA @ 20°C, increasing to 10uA @ 50°C on pins 1 and 2 only.

Background Information:

The above failure was observed while testing per procedure 16520 para. 4.3. The subject device, which was U13 on the SLC PHB, assembly 52250-2 S/N 201, was replaced. No additional testing of the device was performed prior to its submittal for failure analysis.

Outline of Analysis:

1. External Visual Examination
2. Electrical Tests
3. Hermeticity Testing
4. Particle Impact Noise Detection (PIND) Testing
5. Internal Examination
6. Electrical Probing

Results of Analysis:

1. External Visual Examination.

- a) Markings: G5347 (on attached label)
SDG8531
(Siliconix logo) 7913

b) Case Examination:

The leads were crimped, slightly bent and solder coated. There was adhesive tape on the bottom surface. No other obvious visual physical anomalies were noted.

2. Electrical Testing.

a) Curve Tracer Measurements:

Current-voltage characteristics were obtained for each pin to V+ (pin 6) and to V- (pin 9), in both polarities. Pins 1 and 2 were degraded to both V+ and V- as compared to other JFET output pins. No other obvious defects were indicated. See Figures 1 and 2 for pin connection and schematic diagrams.

b) Functional and Parametric Tests:

The device was functionally tested with V+ = 15V, V- = -15V, VL = 5V, VR = 0V, VIL = 0.8V and VIH = 2.0V. With no current flow across the JFET, source and drain voltages were measured. All outputs remained at 0V regardless of the input state except pins 1 and 2 (S4 and D4), which floated at -14.72V to -14.77V for input states 0 and 1, respectively.

The device was tested per 912922 for rDS(on), IS(off), IIN, I+, I-, IL and IR. All data were within the specified limits except IS(off) of pin 1 (gate 4), which was 33.4uA but should be 1.0nA maximum. The data are summarized as follows:

(continued)

5-8050

Results of Analysis: (continued)

2. Electrical Testing. (continued)

b) Functional and Parametric Tests: (continued)

PARAMETER	GATE 1	GATE 2	GATE 3	GATE 4	LIMIT
$r_{DS(on)}$	34.5 Ω	34.0 Ω	30.9 Ω	30.6 Ω	75 Ω max.
IS(off)1	0.109nA	0.133nA	0.079nA	*33.4 μ A	1.0nA max
ID(off)1	0.051nA	0.070nA	0.035nA	0.030nA	1.0nA max
IINL	-13.3 μ A				-250 μ A max
IINH	0.152nA				10nA max
I ⁺ 1	8.0nA				0.1mA max
I ⁻ 1	1.68mA				-4.0mA max
IL1	2.57mA				4.5mA max
IR1	-0.88mA				-2.0mA max
I ⁺ 2	0.86mA				3.0mA max
I ⁻ 2	-2.54mA				-5.5mA max
IL2	2.54mA				4.5mA max
IR2	-0.85mA				-2.0mA max

* Out of tolerance.

c) Baking and Additional Testing.

The device was baked for 2 hours at +150°C and retested for IS(off)1. IS(off)1 of gate 4 was 38.1 μ A compared to 33.4 μ A before baking. The other gates did not change significantly in IS(off)1.

3. Hermeticity Testing.

The device passed the fine leak test and the gross leak characterization.

4. Particle Impact Noise Detection (PIND) Testing.

No indications of loose internal particles were noted during PIND testing.

5. Internal Examination.

Internal examination revealed a crack in the die containing the driver circuitry. The crack extended across the source and channel regions of MOSFET Q5 and terminated at the scribe surface. The crack also passed under the metallization leading from the source of Q5 to the output JFET, Q6. The above mentioned defects pertain only to gate 4. (See Figures 3 through 5.)

6. Electrical Probing.

The JFET between pins 1 and 2 was isolated from the driver chip by lifting the source and gate leads. The JFET was then tested for source-gate and drain-gate characteristics and was not found to be degraded.

ORIGINAL PAGE IS
OF POOR QUALITY

FAR. NO. 9274
PAGE 4 of 7

5' 2050

Conclusions:

The reported failure, high "off" state leakage, was confirmed. Excessive leakage current ($I_{S(off)}$) was observed through pins 1 and 2 at ambient temperature. Pins 1 and 2 were also observed to float near V_{-} while the other switch outputs were at ground. No other electrical defects were indicated. Baking did not elicit significant change in $I_{S(off)}$ of pins 1 and 2. Internal examination revealed a crack across the die containing the driving circuitry. This crack passed through the MOSFET leading to the source and gate of the JFET switch across pins 1 and 2. It is believed that the high leakage was due to the crack since the JFET switch was not found to be defective. This failure is judged to have been primary.

58050

Pin Number	Designation
1	S4
2	D4
3	D2
4	S2
5	IN 2
6	V ⁺
7	V _L
8	V _R
9	V ⁻
10	IN 1
11	S1
12	D1
13	D3
14	S3

ORIGINAL PAGE IS
 OF POOR QUALITY

Figure No. 1

Pin connection table for the
 912922.


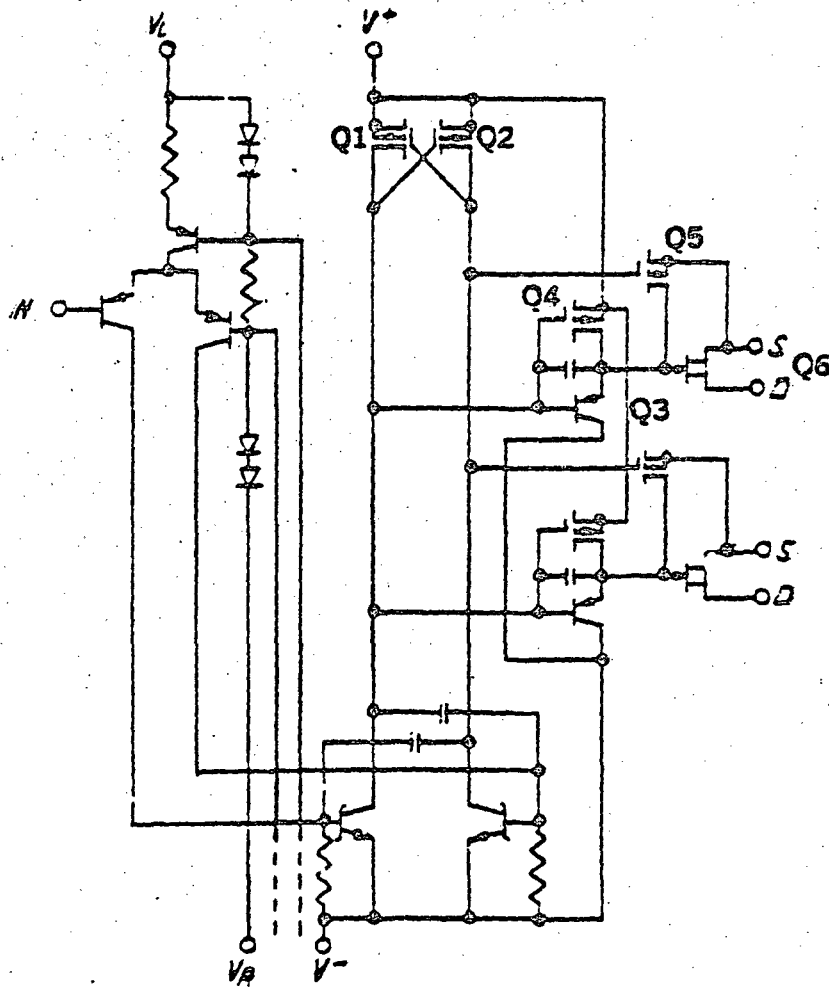


Figure No. 2

Schematic diagram
 for a typical input
 channel with two
 DPST JFET switches

ORIGINAL PAGE IS
OF POOR QUALITY

58050

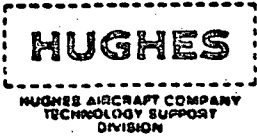

ENGINEERING TECHNICAL COMMENTARY

Approved to FAR 9274
Page 1 of 1

COMMENTARY

The device was tested and found to have failed the reported failed parameter, IS(off). The spec limit was 1.0nA max. and the device measured 33.4 A. This high leakage was probably due to the crack discovered in the die during the internal visual examination. The crack was probably caused by poor handling techniques during assembly.

RECOMMENDATIONS:

Device is considered a random failure. If other devices from this lot are available, a few devices should be temperature cycled to determine if other devices may have this same sort of defect.

John Variette
ENGINEER

[Signature]
ENGINEERING APPROVAL

2/20/92
DATE

ORIGINAL PAGE IS
OF POOR QUALITY

FAR. NO. 9274
PAGE 6 of 7

58050

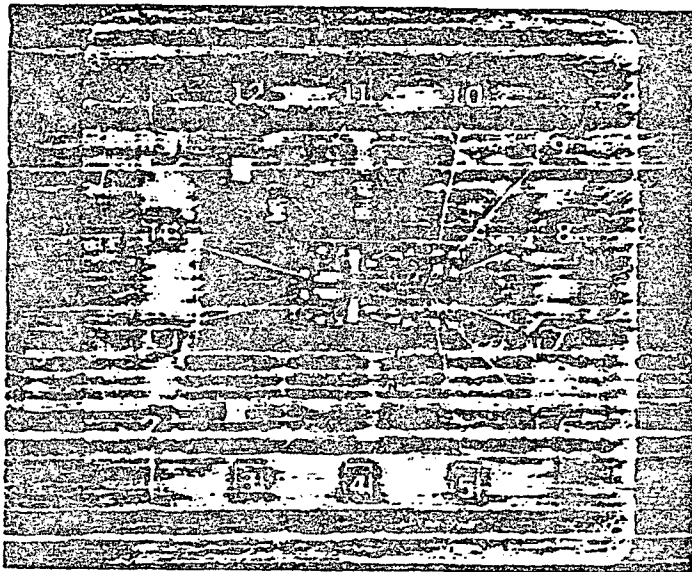


Figure No. 3

Photomicrograph of the cavity
showing the driver circuitry
(center die) and the four
JFET switches on separate
substrates.

(13.7X)

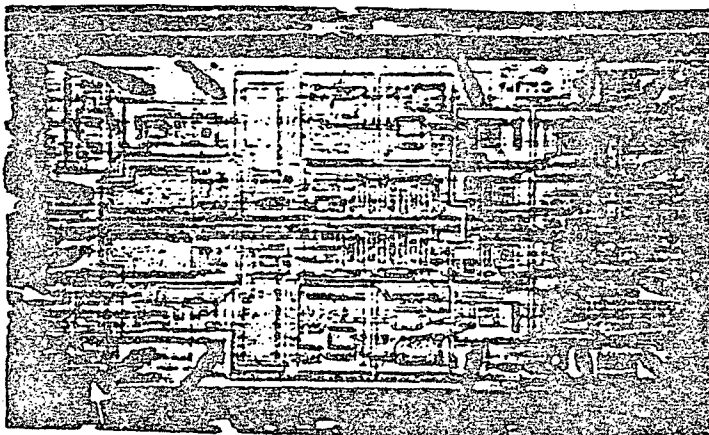


Figure No. 4

Overall view of the center die
showing the location of the
crack shown in Figure 5 (be-
tween arrows).

(46.2X)

5'2050

ORIGINAL PAGE IS
OF POOR QUALITY

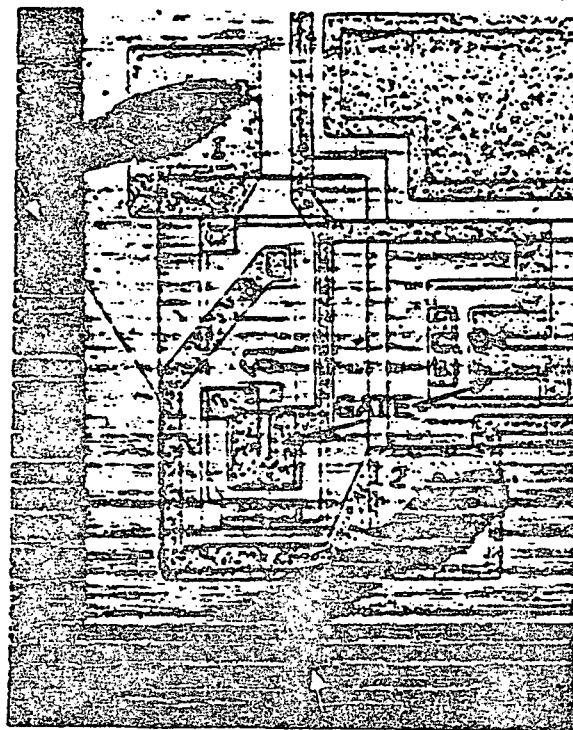


Figure No. 5. Detailed view of the crack across MOSFET Q5 of the driver circuitry. Note that the crack extends to the scribe surface at the edge of the die (between arrows). (182X)

ORIGINAL PAGE IS
OF POOR QUALITY

SANTA BARBARA RESEARCH CENTER

A Subsidiary of Hughes Aircraft Company

INTERNAL MEMORANDUM

5' 2050

TO: Frank Carle
Parts Board

CC: See Distribution List

DATE: 15 March 1982

REF: RS 236-7891

PE 55:82

FROM: L. O'Connell

SUBJECT: Failure of P/N 912922

BLDG. B-11 MAIL STA. 39
EXT. 6357

1. On 20 November 1981 a failure was observed in the TM Scan Line Corrector. This failure was repaired by the replacement of P/N 912922.
2. TSD FAR 9274 declares that the failure may be due to possible mishandling during the manufacturing process.
3. This unit was procured from Siliconix. Please take any necessary action to advise the manufacturer and to preclude the repetition of this type of failure.



L. O'Connell, Manager
Administration and Reliability
Thematic Mapper Program

LOC:jc

HUGHES

**SPACE AND COMMUNICATIONS GROUP
FAILURE REPORT**

ORIGINAL PAGE IS
OF POOR QUALITY

HUGHES AIRCRAFT COMPANY
SPACE AND COMMUNICATIONS GROUP
EL SEGUNDO, CALIFORNIA

S 8051

1. PROGRAM NAME AND NUMBER <i>TM PL 1162</i>		2. GLA <i>V411</i>	3. MODEL <i>FLT</i>	4. TIME OBSERVED <i>4:22</i>	5. DATE OBSERVED MO / DA / YR <i>52</i>
6. HARDWARE LEVEL WHEN FAILURE WAS OBSERVED <input type="checkbox"/> SPACECRAFT <input type="checkbox"/> SUBSYSTEM <input type="checkbox"/> ASSEMBLY <input type="checkbox"/> MODULE <input checked="" type="checkbox"/> CARD <input type="checkbox"/> SYSTEM <input type="checkbox"/> UNIT <input type="checkbox"/> SUBASSEMBLY <input type="checkbox"/> MICAM <input type="checkbox"/> PART					
EQUIPMENT IDENTIFICATION:					
7. SUBSYSTEM		NAME		PART NUMBER	S/N
8. UNIT					
9. <input type="checkbox"/> ASSEMBLY <input type="checkbox"/> SUBASSEMBLY					
10. <input type="checkbox"/> MODULE <input type="checkbox"/> MICAM <input checked="" type="checkbox"/> CARD		<i>Cal Shutter Main</i>		<i>50916</i>	<i>201</i>
11. OTHER					<i>SPRC</i>
12. TEST WHEN FAILURE WAS OBSERVED <input type="checkbox"/> DEVELOPMENT <input type="checkbox"/> QUALIFICATION <input type="checkbox"/> INTEGRATION <input type="checkbox"/> LAUNCH OPERATIONS <input type="checkbox"/> IN-PROCESS <input type="checkbox"/> ACCEPTANCE <input type="checkbox"/> SYSTEM <input type="checkbox"/>					
13. ENVIRONMENT WHEN FAILURE WAS OBSERVED <input checked="" type="checkbox"/> AMBIENT <input type="checkbox"/> RADIATION <input type="checkbox"/> TEMP _____ <input type="checkbox"/> THERMAL VAC _____ HRS AT _____ <input type="checkbox"/> EMC/RFI <input type="checkbox"/> VIBRATION _____ AXIS FOR _____ MIN TYPE _____ <input type="checkbox"/> OTHER _____					
14. DESCRIPTION OF FAILURE <i>Phase Ramp unable to Adjust correctly. Found R87 incorrect Value. Should be 169KΩ is 442KΩ.</i>					
15. TEST PROCEDURE <i>16238</i>		16. ORIGINATOR <i>3.3.7</i>	17. CONTINUATION SHEET USED <i>2213</i>	18. FAILED ITEM NAME AND PART NUMBER	
19. VERIFICATION AND FAILURE ANALYSIS <i>R87 incorrect Value Should be 169KΩ is 442KΩ No Stress To Components</i>					
20. FOLLOWING REWORK/RETEST REQUIRED <input type="checkbox"/> REWORK/RETEST NOT REQUIRED BECAUSE <i>Replace R87 per Assembly drawing 50916 Retest per T.P. 16238 3.3.7</i>					
21. AUTHORIZATION <i>R. Crana</i>		22. CONTINUATION SHEET USED <i>2213</i>	23. CONTINUATION SHEET USED <i>1/11/82</i>		
24. REWORK/RETEST ACTION TAKEN <i>R87 Removed and Replaced</i>					
25. LIST ALL PARTS REPLACED		26. CONTINUATION SHEET USED <i>107</i>	27. CONTINUATION SHEET USED <i>107</i>		
PART NUMBER	CKT SYM	PART LOT NUMBER	DATE CODE	MANUFACTURER	PROBABLE DEFECT
	<i>R87</i>				
27. REWORK BY <i>P. Draher</i>		28. TESTED BY <i>R. Crana</i>	29. CONTINUATION SHEET USED <i>2213</i>	30. CONTINUATION SHEET USED <i>1/12/82</i>	
31. CAUSE AND CORRECTIVE ACTION <i>REFER TO IDC #PE 15:82 FROM L. DONNELL TO O.I. NAKARA. (COPY ATTACHED)</i>					
32. FRB CLOSURE <i>ED1557A WAS INCORPORATED FULLY INTO ATR. CLOSER REVIEW OF ATR REQ'D. R. Mannon 2/9/82</i>					
33. DOCUMENT IMPLEMENTING CORRECTIVE ACTION <i>IDC #PE 15:82 (COPY ATTACHED)</i>					
34. BASIC CAUSE OF VERIFIED FAILURE <input type="checkbox"/> DESIGN <input type="checkbox"/> ENVIRONMENTAL <input type="checkbox"/> DEFECTIVE PARTS <input checked="" type="checkbox"/> TEST EQUIPMENT <input type="checkbox"/> TEST PROCEDURE <input type="checkbox"/> TEST SET-UP <input type="checkbox"/> MFG. PROCEDURE <input type="checkbox"/> ASSY/FAB ERROR <input type="checkbox"/> WORKMANSHIP <input type="checkbox"/> WIRING ERROR <input type="checkbox"/> ROUGH HANDLING <input type="checkbox"/> WEAR-OUT		35. FAILURE CLASSIFICATION <input type="checkbox"/> UNKNOWN <input type="checkbox"/> CRITICAL <input checked="" type="checkbox"/> MAJOR <input type="checkbox"/> MINOR <input type="checkbox"/> SAFETY		36. DEFECT CODE	
37. RESPONSIBLE ENGINEER <i>P. Draher</i>		38. SPACECRAFT SYSTEM ENGINEER <i>W. Engert</i>	39. CUSTOMER OR SUPPLIER <i>SPRC</i>	DATE <i>2/2/82</i>	
40. DATE <i>5-1-82</i>		41. DATE <i>2/1/82</i>			

ORIGINAL PAGE IS
OF POOR QUALITY

SANTA BARBARA RESEARCH CENTER
A Subsidiary of Hughes Aircraft Company
INTERNAL MEMORANDUM

TO: O.I. Nakano
CC: D. Adams
L. Altman
DATE: 1 February 1982
REF: PE 15:82
FROM: L. O'Connell
51-41
BLDG. B-11 MAIL STA. 39
EXT. 6357

This is to confirm our Tel-Con of February 1, 1982 regarding subject Failure Reports.

As I stated to you all three Failure Reports were written against the same printed wiring board (P/N 50916, S/N 201). The cause of the test failures in each case was the installation of an incorrect resistor.

Contract quantities of subject boards have been completed. However, to help you preclude reoccurrence of this type of discrepancy on future orders or current production, copies of subject Failure Reports are attached so you can discuss the problem with Responsible Manufacturing Supervision.



L. O'Connell, Manager
Administration and Reliability
Thematic Mapper Program

LO:jc

HUGHES

SPACE AND COMMUNICATIONS GROUP
FAILURE REPORT

HUGHES AIRCRAFT COMPANY
SPACE AND COMMUNICATIONS GROUP
EL SEGUNDO, CALIFORNIA

S 8107

1. PROGRAM NAME AND NUMBER TM PL-1162		2. GLA	3. MODEL FLT	4. TIME OBSERVED 0845	5. DATE OBSERVED MO 3 DA 30 YR 82
6. HARDWARE LEVEL WHEN FAILURE WAS OBSERVED <input type="checkbox"/> SPACECRAFT <input checked="" type="checkbox"/> SUBSYSTEM <input type="checkbox"/> ASSEMBLY <input type="checkbox"/> MODULE <input type="checkbox"/> CARD <input type="checkbox"/> SYSTEM <input checked="" type="checkbox"/> UNIT <input type="checkbox"/> SUBASSEMBLY <input type="checkbox"/> MICAM <input type="checkbox"/> PART					
EQUIPMENT IDENTIFICATION:					
7. SUBSYSTEM Electronic Module		PART NUMBER 52347		S/N 003	
8. UNIT 51402		51402			
9. <input type="checkbox"/> ASSEMBLY <input type="checkbox"/> SUBASSEMBLY					
10. <input type="checkbox"/> MODULE <input type="checkbox"/> MICAM <input type="checkbox"/> CARD					
11. OTHER					
12. TEST WHEN FAILURE WAS OBSERVED <input type="checkbox"/> DEVELOPMENT <input type="checkbox"/> QUALIFICATION <input checked="" type="checkbox"/> INTEGRATION <input type="checkbox"/> LAUNCH OPERATIONS <input type="checkbox"/> IN-PROCESS <input type="checkbox"/> ACCEPTANCE <input type="checkbox"/> SYSTEM					
13. ENVIRONMENT WHEN FAILURE WAS OBSERVED <input checked="" type="checkbox"/> AMBIENT <input type="checkbox"/> RADIATION <input type="checkbox"/> TEMP _____ ° <input type="checkbox"/> THERMAL VAC _____ HRS AT _____ ° <input type="checkbox"/> EMC/RFI <input type="checkbox"/> VIBRATION _____ AXIS FOR _____ MIN TYPE _____ OTHER _____					
14. DESCRIPTION OF FAILURE J24 Pin 5 and 6 +/- 20V return reads 166 ohms to chassis ground. It should be 10 meg ohm min. J24 pin 11 reads 0.12 224 thru 32 read too low (approx. 26k should be 10 M ohm min) to chassis					
15. TEST PROCEDURE TP 33011-531		16. ORIGINATOR P.C. Buckley	17. CONTINUATION SHEET USED <input type="checkbox"/>	19. FAILED ITEM NAME AND PART NUMBER None	
18. VERIFICATION AND FAILURE ANALYSIS U3 mounting screw was shorting heat sink to board ground. Above hole w/ (AB) board in. Reads (Pin 11) 124 k w/ AB out. (Meter + to chassis) and 1.07 MΩ (Meter + to Pin 11)					
20. <input checked="" type="checkbox"/> FOLLOWING REWORK/RETEST REQUIRED <input type="checkbox"/> REWORK/RETEST NOT REQUIRED BECAUSE Correct fault by re-mounting U3 and assuring that sleeving correctly insulates the screw from contact with anything but the U3 case.					
21. AUTHORIZATION Current		22. CONTINUATION SHEET USED <input type="checkbox"/>	23. REWORK/RETEST ACTION TAKEN Re-positioned and U3 and reinstalled hardware in new sleeving on screws.		
24. QA Rework					
25. QA Retest					
26. LIST ALL PARTS REPLACED					
27. REWORK BY AD/ma					
28. CAUSE AND CORRECTIVE ACTION MOUNTING OF TO-3 DEVICES WAS NOT STANDARDIZED. THIS LED TO MOUNTING WITH SLEEVING OF WRONG LENGTH AND SCREWS OF DIFFERENT DIAMETERS. THIS FAILURE WAS APPARENTLY A SLEEVING PROBLEM. ECA 2722/01 WRITTEN AT END OF CONTRACT SHOULD PREVENT SIMILAR PROBLEMS IN ANY FUTURE FABRICATION.					
29. CONTINUATION SHEET USED					
30. BASIC CAUSE OF VERIFIED FAILURE <input checked="" type="checkbox"/> DESIGN <input type="checkbox"/> TEST EQUIPMENT <input type="checkbox"/> MFG. PROCEDURE <input type="checkbox"/> WIRING ERROR <input type="checkbox"/> UNKNOWN <input type="checkbox"/> DEFECT CODE <input type="checkbox"/> ENVIRONMENTAL <input type="checkbox"/> TEST PROCEDURE <input type="checkbox"/> ASSY/FAB ERROR <input type="checkbox"/> ROUTING/HANDLING <input type="checkbox"/> DEFECTIVE PARTS <input type="checkbox"/> TEST SET-UP <input type="checkbox"/> WORKMANSHIP <input type="checkbox"/> WEAR/OUT					
31. FAILURE TYPE <input checked="" type="checkbox"/> PRIMARY <input type="checkbox"/> UNKNOWN <input type="checkbox"/> NO FAILURE <input type="checkbox"/> CRITICAL <input type="checkbox"/> MINOR <input type="checkbox"/> INDUCED					
32. DOCUMENT IMPLEMENTING CORRECTIVE ACTION ECA 2722 EDC					
33. RESPONSIBLE ENGINEER Current					
34. DATE 22-17 5/11/82					
35. DATE 5/11/82					
36. DATE 22-41 5/11/82					
37. DATE 5/11/82					

FR 8112

ORIGINATOR

ENGINEERING EVALUATION

MANUFACTURING AND TEST

ENGINEERING/RELIABILITY

HUGHES

ORIGINAL PAGE IS OF POOR QUALITY

SPACE AND COMMUNICATIONS GROUP
FAILURE REPORT

S 810

HUGHES AIRCRAFT COMPANY
SPACE AND COMMUNICATIONS GROUP
EL SEGUNDO, CALIFORNIA

1. PROGRAM NAME AND NUMBER <i>TM PL 1162</i>		2. GLA		3. MODEL <i>FLT</i>		4. TIME OBSERVED <i>1000</i>		5. DATE OBSERVED <i>MO 3 DA 30 YR 8</i>		
6. HARDWARE LEVEL WHEN FAILURE WAS OBSERVED <input type="checkbox"/> SPACECRAFT <input checked="" type="checkbox"/> SYSTEM		<input type="checkbox"/> SUBSYSTEM <input type="checkbox"/> UNIT		<input type="checkbox"/> ASSEMBLY <input type="checkbox"/> SUBASSEMBLY		<input type="checkbox"/> MODULE <input type="checkbox"/> MICAM		<input type="checkbox"/> CARD <input type="checkbox"/> PART		
EQUIPMENT IDENTIFICATION:										
7. SUBSYSTEM <i>Electronic Module</i>		NAME			PART NUMBER <i>52347</i>		S/N <i>003</i>		MANUFACTURER	
8. UNIT										
9. <input type="checkbox"/> ASSEMBLY <input type="checkbox"/> SUBASSEMBLY										
10. <input type="checkbox"/> MODULE <input type="checkbox"/> MICAM <input type="checkbox"/> CARD										
11. OTHER										
12. TEST WHEN FAILURE WAS OBSERVED <input type="checkbox"/> DEVELOPMENT <input type="checkbox"/> IN-PROCESS <input type="checkbox"/> QUALIFICATION <input type="checkbox"/> ACCEPTANCE <input checked="" type="checkbox"/> INTEGRATION <input type="checkbox"/> SYSTEM <input type="checkbox"/> LAUNCH OPERATIONS										
13. ENVIRONMENT WHEN FAILURE WAS OBSERVED <input checked="" type="checkbox"/> AMBIENT <input type="checkbox"/> EMC/RFI <input type="checkbox"/> RADIATION <input type="checkbox"/> VIBRATION <input type="checkbox"/> TEMP <input type="checkbox"/> THERMAL VAC <input type="checkbox"/> OTHER										
14. DESCRIPTION OF FAILURE <i>22 pins, pins 11, 12, 29, 30, 31, and 32 were connected to pins 11, 12, 29, 30, 31, and 32. These pins should read 10 meg ohm min. They all on J24 and seem to be related to the A/R board failure on PR 8107</i>										
15. TEST PROCEDURE <i>TP 32015-531</i>		16. ORIGINATOR <i>RS Buckley</i>		17. CONTINUATION SHEET USED <input type="checkbox"/>		18. VERIFICATION AND FAILURE ANALYSIS <i>N/A -</i>		19. FILED ITEM NAME AND PART NUMBER <i>ITEM 14 IDENTIFIED WRONG PINS - TO BE RE-WRITTEN (INCORRECT PIN #'S IN 14a)</i>		
20. <input type="checkbox"/> FOLLOWING REWORK/RETEST REQUIRED <input checked="" type="checkbox"/> REWORK/RETEST NOT REQUIRED BECAUSE <i>SEE 18</i>										
21. AUTHORIZATION										
22. CONTINUATION SHEET USED <input type="checkbox"/>										
23. REWORK/RETEST ACTION TAKEN <i>N/A</i>										
24. QA REWORK										
25. QA RETEST										
26. LIST ALL PARTS REPLACED										
27. REWORK BY										
28. RETESTED BY										
29. CONTINUATION SHEET USED <input type="checkbox"/>										
30. CAUSE AND CORRECTIVE ACTION <i>THIS DISCREPANCY WAS TRANSFERRED TO S 811 BECAUSE OF ERROR NOTED IN ITEM 18 -</i>										
31. FRP CLOSURE										
32. DOCUMENT IMPLEMENTING CORRECTIVE ACTION										
33. FAILURE CLASSIFICATION										
34. BASIC CAUSE OF VERIFIED FAILURE										
35. FAILURE TYPE										
36. RESPONSIBLE ENGINEER <i>W. K. ...</i>										
37. DATE <i>4-6-82</i>										
38. DATE <i>4-9-82</i>										
39. DATE <i>4-12-82</i>										

HUGHES

HUGHES AIRCRAFT COMPANY
SPACE AND COMMUNICATIONS GROUP
EL SEGUNDO, CALIFORNIA

**SPACE AND COMMUNICATIONS GROUP
FAILURE REPORT**

S 8112

1 PROGRAM NAME AND NUMBER TAI PL1162		2 GLA		3 MODEL FLT		4 TIME OBSERVED 1000		5 DATE OBSERVED MO 3 DA 30 YR 82		
6 HARDWARE LEVEL WHEN FAILURE WAS OBSERVED <input type="checkbox"/> SPACECRAFT <input type="checkbox"/> SUBSYSTEM <input type="checkbox"/> ASSEMBLY <input type="checkbox"/> MODULE <input type="checkbox"/> CARD <input checked="" type="checkbox"/> SYSTEM <input type="checkbox"/> UNIT <input type="checkbox"/> SUBASSEMBLY <input type="checkbox"/> MICAM <input type="checkbox"/> PART										
EQUIPMENT IDENTIFICATION:										
7 SUBSYSTEM Electronics Module		NAME T.M.		PART NUMBER 52347		S/N W3		MANUFACTURER		
8 UNIT NOTE: Cancels & supersedes FR 8108 which has wrong 124 pin nos.										
9 <input type="checkbox"/> ASSEMBLY <input type="checkbox"/> SUBASSEMBLY										
10 <input type="checkbox"/> MODULE <input type="checkbox"/> MICAM <input type="checkbox"/> CARD										
11 OTHER										
12 TEST WHEN FAILURE WAS OBSERVED <input type="checkbox"/> DEVELOPMENT <input type="checkbox"/> QUALIFICATION <input checked="" type="checkbox"/> INTEGRATION <input type="checkbox"/> LAUNCH OPERATIONS <input type="checkbox"/> IN-PROCESS <input type="checkbox"/> ACCEPTANCE <input type="checkbox"/> SYSTEM										
13 ENVIRONMENT WHEN FAILURE WAS OBSERVED <input checked="" type="checkbox"/> AMBIENT <input type="checkbox"/> RADIATION <input type="checkbox"/> TEMP. _____ ° _____ THERMAL VAC. _____ HRS AT _____ <input type="checkbox"/> EMC/RFI <input type="checkbox"/> VIBRATION _____ AXIS FOR _____ MIN TYPE _____ OTHER _____										
14 DESCRIPTION OF FAILURE 124 Pins 1, 12, 29, 30, 31, 32 read 86.25K above to chassis ground and should read > 10meg above. Seemed related to (A8) board fault in FR 8107. A8 board was in place for above readings.										
15 TEST PROCEDURE 77 32015-531		16 P/RA 5:1:1.3		18 ORIGINATOR Roy C. Buckley		17 ORG 2242		DATE 3-31-82		17 CONTINUATION SHEET USED
18 VERIFICATION AND FAILURE ANALYSIS When the A8 and A7 board shorts were repaired these readings returned to normal. A8, 5140Ω; A7, 5139Ω										
19 FAILED ITEM NAME AND PART NUMBER										
20 <input type="checkbox"/> FOLLOWING REWORK/RETEST REQUIRED <input checked="" type="checkbox"/> REWORK/RETEST NOT REQUIRED BECAUSE Already done on FR's 8107 & 8368-										
21 AUTHORIZATION										
22 CONTINUATION SHEET USED										
23 REWORK, RETEST ACTION TAKEN N/A										
24 QA REWORK										
25 QA RETEST										
26 JUST ALL PARTS REPLACED		PART NUMBER		DATE CODE		MANUFACTURER		PROBABLE DEFECT		ANALYSIS NUMBER
N/A										
27 REWORK BY N/A		ORG		DATE		28 RETESTED BY		ORG		DATE
29 CONTINUATION SHEET USED										
30 CAUSE AND CORRECTIVE ACTION CASE UNKNOWN - ^{second} TORN TAPE WITH GROUND. See 20 - For S 8368 A KAPTON TAPE INSULATOR WAS INSTALLED BETWEEN U28 AND PWB. THERE WAS NO DETERMINATION OF CAUSE OF TEAR IN INSULATION. (POSSIBLE DEFECTIVE MATERIAL) FOR S 8107 A MISALIGNMENT BETWEEN U3 AND PWB CAUSED THE										
31 FRB CLOSURE Will... 5-1-82										
32 DOCUMENT IMPLEMENTING CORRECTIVE ACTION ECA 2777 EOC										
34 BASIC CAUSE OF FAILURE		DESIGN		TEST EQUIPMENT		MFG. PROCEDURE		WORKING ERROR		DEFECT CODE
ENVIRONMENTAL FAILURE		ENVIRONMENTAL DEFECTIVE PARTS		TEST PROCEDURE		ASSY/FAB ERROR		ROUGH HANDLING		UNKNOWN
FAILURE MODE		PRIMARY INDUCED		UNKNOWN NO FAILURE		WORKMANSHIP		WEAR-CUT		
RESPONSIBLE ENGINEER Ch... 3-17		ORG		DATE 4/6/82		35 FAILURE CLASSIFICATION		CRITICAL MAJOR		MINOR SAFETY
36 REWORK BY Ch... 5/4/82		ORG		DATE 4-26-82		38 SPACECRAFT SYSTEMS ENGINEER Ch... 2241		ORG		DATE 3/11/82
39 REWORK BY		ORG		DATE		39 FAILURE CLASSIFICATION		CRITICAL MAJOR		MINOR SAFETY

5817

[SBRC] ENGINEERING CHANGE REQUEST NOTM2722/01
 SHEET 1 OF 1

DRAWING TITLE **PWB ASSY, TELEMETRY SCALING-FUSELINK-LAMP SEQUENCER** DRAWING NUMBER **51402** REV **D**

CLASS CHANGE I A DRAWING TYPE A R PRIORITY OF CHANGE EMERGENCY URGENT ROUTINE PL NO. **1162** WORK AUTHORIZATION NO. **V415-67-30**

OTHER AFFECTED ENGINEERING DOCUMENTS
SEE ECA

REASON CHANGE NEEDED (EXPLAIN IN FULL)
U3 MOUNTING SCREW WAS SHORTING HEATSINK TO PWB GROUND (REF: FR 58107)

NATURE OF PROBLEM AND/OR REQUIRED CHANGE
STANDARDIZE MOUNTING OF TO-3 CONFIGURED DEVICES & ICs.

ORIGINAL PAGE IS OF POOR QUALITY

REQUESTED BY <i>R. Throckmorton</i>	DATE <i>8/5/80</i>	APPROVAL <i>Current</i>	DATE <i>5/10/82</i>	VERSION ISSUE APPROVED BY
CHIEF DESIGNER <i>R. Throckmorton</i>	DATE <i>8/5/80</i>	APPROVAL <i>[Signature]</i>	DATE <i>5-11-82</i>	ACTION TAKEN
EFFECTIVITY EOC 51065 SN CC- & S45G		APPROVAL <i>[Signature]</i>	DATE <i>5-11-82</i>	E.O. _____ DWG. REV. _____
ITEM DISPOSITION REWORK <input type="checkbox"/> ITEMS CONFORM <input type="checkbox"/> NO ITEMS MADE <input type="checkbox"/> REJECT <input type="checkbox"/> USE <input checked="" type="checkbox"/> NOT APPLICABLE <input type="checkbox"/>		APPROVAL <i>[Signature]</i>	DATE <i>5/11/82</i>	RECEIVED BY _____ DATE _____ HAS EOC
		APPROVAL <i>[Signature]</i>	DATE <i>5/11/82</i>	CHECKED BY _____ DATE _____ HAS EOC
		APPROVAL <i>[Signature]</i>	DATE <i>5/27/82</i>	

HUGHES

HUGHES AIRCRAFT COMPANY
SPACE AND COMMUNICATIONS GROUP
EL SEGUNDO, CALIFORNIA

ORIGINAL PAGE IS
OF POOR QUALITY
SPACE AND COMMUNICATIONS GROUP
FAILURE REPORT

S 8125

1. PROGRAM NAME AND NUMBER <i>TM PL 1162</i>		2. GLA	3. MODEL <i>FLT</i>	4. TIME OBSERVED <i>1700</i>	5. DATE OBSERVED <i>MO 4 DA 6 YR 82</i>
6. HARDWARE LEVEL WHEN FAILURE WAS OBSERVED <input type="checkbox"/> SPACECRAFT <input type="checkbox"/> SYSTEM		<input checked="" type="checkbox"/> SUBSYSTEM <input type="checkbox"/> UNIT	<input type="checkbox"/> ASSEMBLY <input type="checkbox"/> SUBASSEMBLY	<input type="checkbox"/> MODULE <input type="checkbox"/> MICAM	<input type="checkbox"/> CARD <input type="checkbox"/> PART
EQUIPMENT IDENTIFICATION:					
7. SUBSYSTEM <i>Electronic Module</i>		NAME <i>52347</i>		S/N <i>003</i>	MANUFACTURER
8. UNIT					
9. <input type="checkbox"/> ASSEMBLY <input type="checkbox"/> SUBASSEMBLY					
10. <input type="checkbox"/> MODULE <input type="checkbox"/> MICAM <input type="checkbox"/> CARD					
11. OTHER					
12. TEST WHEN FAILURE WAS OBSERVED <input type="checkbox"/> DEVELOPMENT <input type="checkbox"/> IN-PROCESS		<input type="checkbox"/> QUALIFICATION <input type="checkbox"/> ACCEPTANCE	<input checked="" type="checkbox"/> INTEGRATION <input type="checkbox"/> SYSTEMS	<input type="checkbox"/> LAUNCH OPERATIONS	
13. ENVIRONMENT WHEN FAILURE WAS OBSERVED <input checked="" type="checkbox"/> AMBIENT <input type="checkbox"/> EMC/RF		<input type="checkbox"/> RADIATION <input type="checkbox"/> VIBRATION	<input type="checkbox"/> TEMP AXIS FOR	<input type="checkbox"/> THERMAL VAC	HRS AT WIND TYPE
14. DESCRIPTION OF FAILURE <i>J35 P10 29 (Signal ground Band 1 ch 10) open</i>					
18. TEST PROCEDURE <i>TP 32015-531</i>		PARA <i>53.2.5</i>	19. ORIGINATOR <i>Roy G Buckley</i>	ORG <i>2242</i>	DATE <i>4/6/82</i>
16. VERIFICATION AND FAILURE ANALYSIS <i>Traced fault to loosely mounted wear saver. Tightened wear saver and problem was solved.</i>					
17. CONTINUATION SHEET USED <input type="checkbox"/>					
15. FAILED ITEM NAME AND PART NUMBER <i>N/A</i>					
20. <input type="checkbox"/> FOLLOWING REWORK/RETEST REQUIRED <input checked="" type="checkbox"/> REWORK/RETEST NOT REQUIRED BECAUSE <i>See 18</i>					
21. AUTHORIZATION		ORG	DATE	22. CONTINUATION SHEET USED <input type="checkbox"/>	
23. REWORK/RETEST ACTION TAKEN <i>N/A</i>					
24. QA REWORK					
25. QA RETEST					
26. LIST ALL PARTS REPLACED		CKT SYM	PART LOT NUMBER	DATE CODE	MANUFACTURER
PART NUMBER					PROBABLE DEFECT
<i>N/A</i>					ANALYSIS NUMBER
27. REWORK BY		ORG	DATE	28. RETESTED BY	ORG
					DATE
29. CONTINUATION SHEET USED <input type="checkbox"/>					
30. CAUSE AND CORRECTIVE ACTION <i>TEST SETUP WAS NOT PROPERLY MATED THROUGH WEAR Saver In future, torque wear saver screws better. TEST TECHNICIANS HAVE BEEN ALERTED TO CHECK MATINGS OF CONNECTOR MOLE THOROUGHLY - Q</i>					
31. FRD CLOSURE <i>[Signature]</i> <i>4-9-82</i>					
31. CONTINUATION SHEET USED <input type="checkbox"/>					
32. DOCUMENT IMPLEMENTING CORRECTIVE ACTION					
34. BASIC CAUSE OF VERIFIED FAILURE		<input type="checkbox"/> DESIGN ENVIRONMENTAL DEFECTIVE PARTS	<input type="checkbox"/> TEST EQUIPMENT TEST PROCEDURE TEST SET-UP	<input type="checkbox"/> MFG. PROCEDURE ASSY/FAB ERROR WORKMANSHIP	<input type="checkbox"/> WIRING/ERROR ROUGH HANDLING WEAR-OUT
35. FAILURE TYPE		<input type="checkbox"/> PRIMARY <input checked="" type="checkbox"/> INDUCED	<input type="checkbox"/> UNKNOWN <input type="checkbox"/> NO FAILURE	30. FAILURE CLASSIFICATION	<input type="checkbox"/> UNKNOWN <input type="checkbox"/> CRITICAL MAJOR
37. RESPONSIBLE ENGINEER <i>Current</i>		ORG <i>2217</i>	DATE <i>4/3/82</i>	33. SPACECRAFT SYSTEM ENGINEER <i>[Signature]</i>	ORG <i>2241</i>
39. RELIABILITY <i>[Signature]</i>		ORG <i>51-41</i>	DATE <i>4-9-82</i>	40. CURT SWENSON SUPPLIER <i>[Signature]</i>	DATE <i>4/9/82</i>

HUGHES

ORIGINAL PAGE IS OF POOR QUALITY

SPACE AND COMMUNICATIONS GROUP FAILURE REPORT

S 8126

HUGHES AIRCRAFT COMPANY SPACE AND COMMUNICATIONS GROUP EL SEGUNDO, CALIFORNIA

1. PROGRAM NAME AND NUMBER <i>TN PL 1162</i>		2. GLA	3. MODEL <i>FLT</i>	4. TIME OBSERVED <i>1730</i>	5. DATE OBSERVED <i>MO 40 CA6 YR 82</i>
6. HARDWARE LEVEL WHEN FAILURE WAS OBSERVED <input type="checkbox"/> SPACECRAFT <input checked="" type="checkbox"/> SUBSYSTEM <input type="checkbox"/> ASSEMBLY <input type="checkbox"/> MODULE <input type="checkbox"/> CARD		<input type="checkbox"/> SYSTEM <input checked="" type="checkbox"/> UNIT	<input type="checkbox"/> SUBASSEMBLY	<input type="checkbox"/> MICAM	<input type="checkbox"/> PART
EQUIPMENT IDENTIFICATION: NAME <i>Electronics Module</i>		PART NUMBER <i>57347</i>		S/N <i>003</i>	MANUFACTURER
7. SUBSYSTEM		8. UNIT			
9. <input type="checkbox"/> ASSEMBLY <input type="checkbox"/> SUBASSEMBLY		10. <input type="checkbox"/> MODULE <input type="checkbox"/> MICAM <input type="checkbox"/> CARD		11. OTHER	
12. TEST WHEN FAILURE WAS OBSERVED <input type="checkbox"/> DEVELOPMENT <input type="checkbox"/> IN-PROCESS <input type="checkbox"/> QUALIFICATION <input type="checkbox"/> ACCEPTANCE <input checked="" type="checkbox"/> INTEGRATION <input type="checkbox"/> SYSTEM <input type="checkbox"/> LAUNCH OPERATIONS		13. ENVIRONMENT WHEN FAILURE WAS OBSERVED <input checked="" type="checkbox"/> AMBIENT <input type="checkbox"/> EMC/RFI <input type="checkbox"/> RADIATION <input type="checkbox"/> VIBRATION		TEMP _____ ° F THERMAL VAC _____ HRS AT _____ MIN TYPE _____ OTHER _____	
14. DESCRIPTION OF FAILURE <i>J30 PIN 49 A (Signal ground Band 1 Ch 15) open</i>					
15. TEST PROCEDURE <i>TP 32015-531</i>		16. PARA <i>6.3.2.3</i>	18. ORIGINATOR <i>Roger C Buckley</i>	19. ORG <i>2242</i>	17. DATE <i>4/19/82</i>
18. VERIFICATION AND FAILURE ANALYSIS <i>Traced fault to loosely mounted wear saves. Tightened wear saves and problem was solved.</i>		19. FAILED ITEM NAME AND PART NUMBER <i>N/A</i>		17. CONTINUATION SHEET USED <input type="checkbox"/>	
20. <input type="checkbox"/> FOLLOWING REWORK/RETEST REQUIRED <input checked="" type="checkbox"/> REWORK/RETEST NOT REQUIRED BECAUSE <i>See 1B</i>		21. AUTHORIZATION		ORG	DATE
22. REWORK/RETEST ACTION TAKEN <i>N/A</i>		24. QA REWORK		23. QA RETEST	
25. LIST ALL PARTS REPLACED PART NUMBER		CXT SYM	PART LOT NUMBER	DATE CODE	MANUFACTURER
<i>N/A</i>					PROBABLE DEFECT
27. REWORK BY		ORG	DATE	28. RETESTED BY	ORG
29. CAUSE AND CORRECTIVE ACTION <i>TEST SETUP WAS POORLY MATED THROUGH WEAR SAVED. In future to have wear saves screens better. TEST TECHNICIANS HAVE BEEN ALERTED TO CHECK MATING OF CONNECTORS MORE THOROUGHLY.</i>		30. CONTINUATION SHEET USED <input type="checkbox"/>		31. FRB CLOSURE <i>R. Allman 4-9-82</i>	
32. DOCUMENT IMPLEMENTING CORRECTIVE ACTION		33. CONTINUATION SHEET USED <input type="checkbox"/>		34. BASIC CAUSE OF VERIFIED FAILURE <input type="checkbox"/> DESIGN ENVIRONMENTAL DEFECTIVE PARTS <input type="checkbox"/> TEST EQUIPMENT TEST PROCEDURE TEST SET-UP <input type="checkbox"/> MFG. PROCEDURE ASSY/FAB ERROR WORKMANSHIP <input type="checkbox"/> WIRING ERROR ROUGH HANDLING WEAR-OUT <input type="checkbox"/> UNKNOWN	
35. FAILURE TYPE <input type="checkbox"/> PRIMARY <input checked="" type="checkbox"/> INDUCED		36. FAILURE CLASSIFICATION <input type="checkbox"/> UNKNOWN <input type="checkbox"/> NO FAILURE <input type="checkbox"/> CRITICAL <input type="checkbox"/> MAJOR <input checked="" type="checkbox"/> MINOR <input type="checkbox"/> SAFETY		37. RESPONSIBLE ENGINEER <i>URGENT</i>	
38. RECIPIENT <i>Curber</i>		ORG <i>22-17</i>	DATE <i>4/8/82</i>	39. SPACECRAFT SYSTEM ENGINEER <i>Blumel</i>	ORG <i>22 91</i>
39. RELIABILITY <i>Curber</i>		ORG <i>51-41</i>	DATE <i>4-8-82</i>	40. CUSTOMER OR SUPPLIER <i>N/A</i>	DATE <i>4/9/82</i>



HUGHES AIRCRAFT COMPANY
SPACE AND COMMUNICATIONS GROUP
EL SEGUNDO, CALIFORNIA

SPACE AND COMMUNICATIONS GROUP

FAILURE REPORT

ORIGINAL PAGE IS
OF POOR QUALITY

S 8139

ORIGINATOR	1. PROGRAM NAME AND NUMBER TM A-1162		2. GLA		3. MODEL FLT		4. TIME OBSERVED 10P		5. DATE OBSERVED MO 5 DA 8 YR 82		
	6. HARDWARE LEVEL WHEN FAILURE WAS OBSERVED		<input type="checkbox"/> SPACECRAFT <input type="checkbox"/> SYSTEM		<input type="checkbox"/> SUBSYSTEM <input type="checkbox"/> UNIT		<input type="checkbox"/> ASSEMBLY <input type="checkbox"/> SUBASSEMBLY		<input type="checkbox"/> MODULE <input type="checkbox"/> MICAM <input checked="" type="checkbox"/> CARD <input type="checkbox"/> PART		
	EQUIPMENT IDENTIFICATION: NAME PART NUMBER S/N MANUFACTURER										
	7. SUBSYSTEM										
	8. UNIT										
	9. <input type="checkbox"/> ASSEMBLY <input checked="" type="checkbox"/> SUBASSEMBLY										
	10. <input type="checkbox"/> MODULE <input type="checkbox"/> MICAM <input checked="" type="checkbox"/> CARD 50942 (A4) 202										
	11. OTHER										
	12. TEST WHEN FAILURE WAS OBSERVED										
	<input type="checkbox"/> DEVELOPMENT <input type="checkbox"/> QUALIFICATION <input type="checkbox"/> INTEGRATION <input type="checkbox"/> LAUNCH OPERATIONS <input checked="" type="checkbox"/> IN-PROCESS <input type="checkbox"/> ACCEPTANCE <input type="checkbox"/> SYSTEM <input type="checkbox"/>										
	13. ENVIRONMENT WHEN FAILURE WAS OBSERVED										
	<input checked="" type="checkbox"/> AMBIENT <input type="checkbox"/> RADIATION <input type="checkbox"/> TEMP _____ ° <input type="checkbox"/> THERMAL VAC _____ HRS AT _____ ° <input type="checkbox"/> EMC/RF <input type="checkbox"/> VIBRATION _____ AXIS FOR _____ MIN TYPE <input type="checkbox"/> OTHER										
14. DESCRIPTION OF FAILURE CONTROL TEMP VOLTAGE OUT OF SPEC. IN P44.6, READING WAS +3.885, S/B 3.0 ± 0.1 IN P44.7, READING WAS +3.876, S/B 4.0 ± 0.1											
15. TEST PROCEDURE 16235 4.4.6, 4.4.7											
16. ORIGINATOR SLOWAKIA											
17. CONTINUATION SHEET USED											
18. VERIFICATION AND FAILURE ANALYSIS											
19. FAILED ITEM NAME AND PART NUMBER TEMP CONTROL RD 50942											
20. <input type="checkbox"/> FOLLOWING REWORK/RETEST REQUIRED <input type="checkbox"/> REWORK/RETEST NOT REQUIRED BECAUSE SPEC WILL BE CHANGED PER EO 4366A TO EXTEND ACCEPTABLE RANGE											
21. AUTHORIZATION Shawles											
22. REWORK/RETEST ACTION TAKEN EO 4366A ISSUED											
23. CONTINUATION SHEET USED											
24. QA Rework											
25. QA RETEST											
26. LIST ALL PARTS REPLACED											
27. REWORK BY											
28. RETESTED BY											
29. CONTINUATION SHEET USED											
30. CAUSE AND CORRECTIVE ACTION VOLTAGE TOLERANCES IN SPEC. WERE TOO TIGHT. EO 4366A CHANGES TOLERANCES SO THAT PREVIOUS CHANGE READINGS ARE NOW WITHIN SPEC.											
31. FRB CLOSURE											
32. DOCUMENT IMPLEMENTING CORRECTIVE ACTION EO 4366A EFFECTIVITY 5/23/82											
33. CONTINUATION SHEET USED											
34. BASIC CAUSE OF VERIFIED FAILURE											
<input checked="" type="checkbox"/> DESIGN ENVIRONMENTAL DEFECTIVE PARTS <input type="checkbox"/> TEST EQUIPMENT <input type="checkbox"/> MFG. PROCEDURE ASSY/FAB ERROR <input type="checkbox"/> WORKMANSHIP <input type="checkbox"/> WIRING ERROR <input type="checkbox"/> ROUGH HANDLING <input type="checkbox"/> WEAR/CRACK											
35. FAILURE TYPE											
<input type="checkbox"/> PRIMARY <input type="checkbox"/> INDUCED <input checked="" type="checkbox"/> UNKNOWN <input type="checkbox"/> NO FAILURE											
36. FAILURE CLASSIFICATION											
<input type="checkbox"/> CRITICAL <input type="checkbox"/> MINOR <input type="checkbox"/> MAJOR <input type="checkbox"/> SAFETY											
37. RESPONSIBLE ENGINEER Current											
38. RELIABILITY											
5/21/82											

5/21/82

HUGHES

HUGHES AIRCRAFT COMPANY
SPACE AND COMMUNICATIONS GROUP
EL SEGUNDO, CALIFORNIA

MAIN AHR-OP#600-STEP 2
REF NCMR 393234
SPACE AND COMMUNICATIONS GROUP
FAILURE REPORT

ORIGINAL PAGE IS
OF POOR QUALITY
S 8283

1. PROGRAM NAME AND NUMBER TM VOII PL1162		2. GLA		3. MODEL FLIGHT		4. TIME OBSERVED DAY SHIFT		5. DATE OBSERVED MO 8 DA 20 YR 81	
6. HARDWARE LEVEL WHEN FAILURE WAS OBSERVED <input type="checkbox"/> SPACECRAFT <input type="checkbox"/> SYSTEM		<input type="checkbox"/> SUBSYSTEM <input type="checkbox"/> UNIT		<input checked="" type="checkbox"/> ASSEMBLY <input type="checkbox"/> SUBASSEMBLY		<input type="checkbox"/> MODULE <input type="checkbox"/> MICAM		<input type="checkbox"/> CARD <input type="checkbox"/> PART	
EQUIPMENT IDENTIFICATION:									
7. SUBSYSTEM		NAME		PART NUMBER		S/N		MANUFACTURER	
8. UNIT									
9. <input checked="" type="checkbox"/> ASSEMBLY <input type="checkbox"/> SUBASSEMBLY BAND 2 POST AMP SD904-2 201 SBRC									
10. <input type="checkbox"/> MODULE <input type="checkbox"/> MICAM <input type="checkbox"/> CARD									
11. OTHER									
12. TEST WHEN FAILURE WAS OBSERVED <input type="checkbox"/> DEVELOPMENT <input type="checkbox"/> QUALIFICATION <input type="checkbox"/> INTEGRATION <input type="checkbox"/> LAUNCH OPERATIONS <input checked="" type="checkbox"/> IN-PROCESS <input type="checkbox"/> ACCEPTANCE <input type="checkbox"/> SYSTEM									
13. ENVIRONMENT WHEN FAILURE WAS OBSERVED <input type="checkbox"/> AMBIENT <input type="checkbox"/> RADIATION <input checked="" type="checkbox"/> TEMP 15.0 <input type="checkbox"/> THERMAL VAC HRS AT <input type="checkbox"/> ELEC/R/R <input type="checkbox"/> VIBRATION AXIS FOR MIN TYPE <input type="checkbox"/> OTHER									
14. DESCRIPTION OF FAILURE CHANNEL 13 FAILED TO MEET PRE-GAIN RESISTOR (R87) SELECTION REQUIREMENTS WITHOUT USING AN OUT-OF-RANGE COMPONENT. LIMITS: 4.12K TO 11.8K; VALUE: 3.83K									
15. TEST PROCEDURE 16597		PARA 45		16. ORIGINATOR A.C. DAVISON		ORG 2213		DATE 8-25-81	
17. CONTINUATION SHEET USED <input type="checkbox"/>									
18. VERIFICATION AND FAILURE ANALYSIS SITUATION VERIFIED AT TEST! SELECTION STEP. NO PARTS OVERSTRESSED THROUGH THE USE OF THIS PART VALUE.									
19. FAILED ITEM NAME AND PART NUMBER PREGAIN RESISTOR (R87)									
20. <input type="checkbox"/> FOLLOWING REWORK/RETEST REQUIRED <input checked="" type="checkbox"/> REWORK/RETEST NOT REQUIRED BECAUSE OBVIOUSLY AN OUT-OF-RANGE VALUE IS REQUIRED TO MEET GAIN SPECIFICATIONS.									
21. IDENTIFICATION A.C. Davison									
22. REWORK/RETEST ACTION TAKEN NONE		ORG 2213		DATE 8/26/81		23. CONTINUATION SHEET USED <input type="checkbox"/>		24. QA REWORK	
25. QA RETEST									
26. LIST ALL PARTS REPLACED									
PART NUMBER		CKT SYM	PART LOT NUMBER	DATE CODE	MANUFACTURER	PROBABLE DEFECT		ANALYSIS NUMBER	
N/A									
27. REWORK BY N/A									
ORG		DATE		28. RETESTED BY N/A		ORG		DATE	
29. CONTINUATION SHEET USED <input type="checkbox"/>									
30. CAUSE AND CORRECTIVE ACTION RANGE SPECIFIED IN 16597 NOT BROAD ENOUGH TO PROVIDE ADJUSTMENT. E.O. TO SPEC REQUIRED. RANGE WAS: 4.12K TO 11.8K CHANGE TO: 3.01K TO 11.8K									
31. FAB CLOSURE A.C. Davison 10/22/81									
31. CONTINUATION SHEET USED <input type="checkbox"/>									
32. DOCUMENT IMPLEMENTING CORRECTIVE ACTION E.O. 3442A-EFFECTIVITY IN 203 & SUBG.									
34. BASIC CAUSE OF VERIFIED FAILURE		<input type="checkbox"/> DESIGN ENVIRONMENTAL DEFECTIVE PARTS		<input checked="" type="checkbox"/> TEST EQUIPMENT TEST PROCEDURE TEST SET-UP		<input type="checkbox"/> MFG. PROCEDURE ASSY/FAB ERROR WORKMANSHIP		<input type="checkbox"/> WIRING ERROR ROUGH HANDLING WEAR/OUT	
35. FAILURE TYPE		<input type="checkbox"/> PRIMARY <input type="checkbox"/> INDUCED		<input type="checkbox"/> UNKNOWN <input checked="" type="checkbox"/> NO FAILURE		36. FAILURE CLASSIFICATION <input type="checkbox"/> CRITICAL <input type="checkbox"/> MAJOR		<input checked="" type="checkbox"/> MINOR <input type="checkbox"/> SAFETY	
37. RESPONSIBLE ENGINEER A.C. Davison		ORG 2213		DATE 8/26/81		38. SPECIALIST SYSTEM ENGINEER A.C. Davison		ORG 2213	
39. RESPONSIBILITY A.C. Davison		ORG 5141		DATE 10/20/81		40. POSS NUMBER OR SUPPLIER A.C. Davison		DATE 8/10/82	

HUGHES

HUGHES AIRCRAFT COMPANY
SPACE AND COMMUNICATIONS GROUP
EL SEGUNDO, CALIFORNIA

SPACE AND COMMUNICATIONS GROUP
FAILURE REPORT

S 8309

ORIGINAL PAGE IS
OF POOR QUALITY

1. PROGRAM NAME AND NUMBER THEMATIC MAPPER		2. GLA HS 236		3. MODEL FLT		4. TIME OBSERVED 11AM		5. DATE OBSERVED MO 10 DA 28 YR 81					
8. HARDWARE LEVEL WHEN FAILURE WAS OBSERVED		<input type="checkbox"/> SPACECRAFT <input type="checkbox"/> SYSTEM		<input type="checkbox"/> SUBSYSTEM <input type="checkbox"/> UNIT		<input checked="" type="checkbox"/> ASSEMBLY <input type="checkbox"/> SUBASSEMBLY		<input type="checkbox"/> MODULE <input type="checkbox"/> MICAM <input type="checkbox"/> CARD <input type="checkbox"/> PART					
EQUIPMENT IDENTIFICATION:													
7. SUBSYSTEM			NAME			PART NUMBER		S/N		MANUFACTURER			
8. UNIT													
9. <input checked="" type="checkbox"/> ASSEMBLY <input type="checkbox"/> SUBASSEMBLY VERIFICATION REGISTER UNIT													
10. <input type="checkbox"/> MODULE <input type="checkbox"/> MICAM <input type="checkbox"/> CARD													
11. OTHER													
12. TEST WHEN FAILURE WAS OBSERVED													
<input type="checkbox"/> DEVELOPMENT <input type="checkbox"/> IN-PROCESS		<input type="checkbox"/> QUALIFICATION <input checked="" type="checkbox"/> ACCEPTANCE		<input type="checkbox"/> INTEGRATION <input type="checkbox"/> SYSTEM		<input type="checkbox"/> LAUNCH OPERATIONS							
13. ENVIRONMENT WHEN FAILURE WAS OBSERVED													
<input checked="" type="checkbox"/> AMBIENT <input type="checkbox"/> EMC/RF		<input type="checkbox"/> RADIATION <input type="checkbox"/> VIBRATION		<input type="checkbox"/> TEMP _____ ° AXIS FOR _____ MIN TYPE _____		<input type="checkbox"/> THERMAL VAC _____ HRS AT _____		<input type="checkbox"/> OTHER					
14. DESCRIPTION OF FAILURE SOLDER BRIDGE BETWEEN TRACES TO U31 PIN 7 AND U31 PIN 8													
15. TEST PROCEDURE 16422													
16. VERIFICATION AND FAILURE ANALYSIS		17. CONTINUATION SHEET USED		18. ORIGINATOR J. GUYTON		19. ORG 22-13		20. DATE 10-28-81					
19. VERIFICATION AND FAILURE ANALYSIS U31 PIN 7 SHORT TO GND CAUSED NO WORD G PRIMARY OUTPUT. SHORT OBSERVED AND SHOULD BE REMOVED. NO FAILURE TO U31 PIN 7 OUTPUT AS RESULT OF WORKMANSHIP ERROR REFER TO HS 236-7701 ERR STRESS ANALYSIS (COPY ATTACHED)													
20. <input checked="" type="checkbox"/> FOLLOWING REWORK/RETEST REQUIRED <input type="checkbox"/> REWORK/RETEST NOT REQUIRED BECAUSE REMOVE SOLDER BRIDGE BETWEEN U31 PIN 7 AND U31 PIN 8. RETEST PER 16422 PARA 5.1													
21. AUTHORIZATION J. GUYTON													
22. CONTINUATION SHEET USED													
23. REWORK/RETEST ACTION TAKEN REMOVED SOLDER BRIDGE BETWEEN TRACES TO U31 PIN 7 AND U31 PIN 8. RETESTED PER 16422 PARA 5.1													
24. WORD G PRIMARY OUTPUT IS CORRECT.													
25. LIST ALL PARTS REPLACED													
PART NUMBER		CKT SYM		PART LOT NUMBER		DATE CODE		MANUFACTURER		PROBABLE DEFECT		ANALYSIS NUMBER	
27. REWORK BY L. TORRES													
ORG 22-74		DATE 10-28-81		28. RETESTED BY J. GUYTON		ORG 22-13		DATE 10-30-81		29. CONTINUATION SHEET USED			
30. CAUSE AND CORRECTIVE ACTION POOR WORKMANSHIP CAUSED SOLDER SPLASH.													
31. FBG CLOSURE													
32. DOCUMENT IMPLEMENTING CORRECTIVE ACTION													
33. CLOSER SUBSEQUENT VISUAL INSPECTIONS CAN OBSERVE PROBLEM. A MEET WAS HELD WITH MPL AND QA INSPECTOR AND REVIEWED THE ABOVE PROBLEM, AND THIS SIMILAR EVENT FUTURE OCCURRENCE													
34. BASIC CAUSE OF VERIFIED FAILURE													
<input type="checkbox"/> DESIGN <input type="checkbox"/> ENVIRONMENTAL <input type="checkbox"/> DEFECTIVE PARTS		<input type="checkbox"/> TEST EQUIPMENT <input type="checkbox"/> TEST PROCEDURE <input type="checkbox"/> TEST SET-UP		<input type="checkbox"/> MFG. PROCEDURE <input type="checkbox"/> ASSY/FAB ERROR <input checked="" type="checkbox"/> WORKMANSHIP		<input type="checkbox"/> WIRING ERROR <input type="checkbox"/> ROUGH HANDLING <input type="checkbox"/> WEAR-OUT		<input type="checkbox"/> UNKNOWN		DEFECT CODE			
35. FAILURE TYPE													
<input checked="" type="checkbox"/> PRIMARY <input type="checkbox"/> INDUCED		<input type="checkbox"/> UNKNOWN <input type="checkbox"/> NO FAILURE		36. FAILURE CLASSIFICATION		<input type="checkbox"/> CRITICAL <input type="checkbox"/> MAJOR		<input checked="" type="checkbox"/> MINOR <input type="checkbox"/> SAFETY					
37. RESPONSIBLE ENGINEER J. Bonach													
ORG 22-13		DATE 10-30-81		38. SPACECRAFT SYSTEM ENGINEER J. Guyton		ORG 22-61		DATE 11/10/81					
39. RELIABILITY 51-4													
ORG 51-4		DATE 11-3-81		40. CUSTOMER OR SUPPLIER		DATE							



HUGHES AIRCRAFT COMPANY
SPACE AND COMMUNICATIONS GROUP
EL SEGUNDO, CALIFORNIA

ORIGINAL PAGE IS
OF POOR QUALITY
SPACE AND COMMUNICATIONS GROUP
FAILURE REPORT 1430

S 8310

1. PROGRAM NAME AND NUMBER THEMATIC MAPPER HS 236		2. GLA		3. MODEL FLT		4. TIME OBSERVED 2:30 PM		5. DATE OBSERVED MO 10 DA 28 YR 81	
6. HARDWARE LEVEL WHEN FAILURE WAS OBSERVED <input type="checkbox"/> SPACECRAFT <input type="checkbox"/> SYSTEM		<input type="checkbox"/> SUBSYSTEM <input type="checkbox"/> UNIT		<input checked="" type="checkbox"/> ASSEMBLY <input type="checkbox"/> SUBASSEMBLY		<input type="checkbox"/> MODULE <input type="checkbox"/> MICAM		<input type="checkbox"/> CARD <input type="checkbox"/> PART	
EQUIPMENT IDENTIFICATION:									
7. SUBSYSTEM		NAME		PART NUMBER		S/N		MANUFACTURER	
8. UNIT Electronic Module									
9. <input checked="" type="checkbox"/> ASSEMBLY <input type="checkbox"/> SUBASSEMBLY		CAS AMP/T.NCHWORM DRIVER		50926		201		S B K C	
10. <input type="checkbox"/> MODULE <input type="checkbox"/> MICAM <input type="checkbox"/> CARD									
11. OTHER									
12. TEST WHEN FAILURE WAS OBSERVED <input type="checkbox"/> DEVELOPMENT <input type="checkbox"/> IN-PROCESS <input type="checkbox"/> QUALIFICATION <input checked="" type="checkbox"/> ACCEPTANCE <input type="checkbox"/> INTEGRATION <input type="checkbox"/> SYSTEM <input type="checkbox"/> LAUNCH OPERATIONS									
13. ENVIRONMENT WHEN FAILURE WAS OBSERVED <input checked="" type="checkbox"/> AMBIENT <input type="checkbox"/> EMC/RFI <input type="checkbox"/> RADIATION <input type="checkbox"/> VIBRATION									
14. DESCRIPTION OF FAILURE TS 16234 PARA 3.3.2.2 NO -12V OUTPUT									
15. TEST PROCEDURE TS 16234									
16. VERIFICATION AND FAILURE ANALYSIS AR 6 OPERATIONAL AMPLIFIER INSTALLED UPSIDE DOWN (CLOCKED BACKWARD) AR 6 OVERSTRESSED - NO OTHER PARTS OVERSTRESSED @ 29-82 +12V AND -12V POWER TO AR 6 WERE INTERCHANGED. THIS WOULD CAUSE THE OPAMP TO									
17. CONTINUATION SHEET USED									
18. FOLLOWING REWORK/RETEST REQUIRED <input type="checkbox"/> REWORK/RETEST NOT REQUIRED BECAUSE REMOVE AND REPLACE AR 6 RETEST PER PARA 3.3.2.2									
19. AUTHORIZATION J. Bernick									
20. REWORK/RETEST ACTION TAKEN AR 6 REMOVED AND REPLACED.									
21. LIST ALL PARTS REPLACED									
22. REWORK BY M GUERRA									
23. CAUSE AND CORRECTIVE ACTION WORKMANSHIP ERROR. ASSEMBLY TECHNICIAN HAS BEEN CAUTIONED TO REVIEW ORIENTATION OF DEVICE PRIOR TO SOLDERING. @ 2-9-82									
24. BASIC CAUSE OF VERIFIED FAILURE <input checked="" type="checkbox"/> DESIGN ENVIRONMENTAL FAILURE <input type="checkbox"/> TEST EQUIPMENT TEST PROCEDURE TEST SET-UP <input type="checkbox"/> MFG. PROCEDURE ASSY/FAB ERROR WORKMANSHIP <input type="checkbox"/> WIRING ERROR ROUGH HANDLING WEAR-OUT <input type="checkbox"/> UNKNOWN									
25. FAILURE TYPE <input checked="" type="checkbox"/> PRIMARY INDUCED <input type="checkbox"/> UNKNOW/NO FAILURE									
26. RESPONSIBLE ENGINEER J. Bernick									
27. RELIABILITY									

HUGHES

HUGHES AIRCRAFT COMPANY
SPACE AND COMMUNICATIONS GROUP
EL SEGUNDO, CALIFORNIA

SPACE AND COMMUNICATIONS GROUP

FAILURE REPORT
CONTINUATION SHEET

FR SERIAL NO.

58310

CONTINUATION SHEET LETTER*

A


*LABEL FIRST CONTINUATION SHEET USED 'A', SECOND 'B', AND SO ON

IDENTIFY ENTRIES BY REFERENCING FR BLOCK NUMBER IN COLUMN. DATE EACH ENTRY.

ADDITIONAL FR
CONTINUATION
SHEET(S) USED

18 FAIL, HOWEVER NO OUT OF SPEC SIGNAL WAS SENT TO ANY FOLLOW-ON CIRCUITRY AS THE LM 108 IS USED AS A $\pm 13.5V$ TO $-13.5V$ SOURCE. THE MAX SEEN IN THIS INSTANCE COULD HAVE BEEN BETWEEN \pm AND MINUS 12 V. CP-2-15-82

ORIGINAL PAGE IS
OF POOR QUALITY

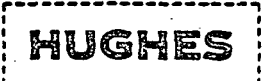

HUGHES AIRCRAFT COMPANY
SPACE AND COMMUNICATIONS GROUP
EL SEGUNDO, CALIFORNIA

SPACE AND COMMUNICATIONS GROUP
FAILURE REPORT

ORIGINAL PAGE IS
OF POOR QUALITY

S 8311

1. PROGRAM NAME AND NUMBER THEMATIC MAPPER H5236		2. GLA		3. MODEL FLT		4. TIME OBSERVED 11:00		5. DATE OBSERVED MO 10 DA 29 YR 81			
6. HARDWARE LEVEL WHEN FAILURE WAS OBSERVED		<input type="checkbox"/> SPACECRAFT <input type="checkbox"/> SYSTEM		<input type="checkbox"/> SUBSYSTEM <input type="checkbox"/> UNIT		<input checked="" type="checkbox"/> ASSEMBLY <input type="checkbox"/> SUBASSEMBLY		<input type="checkbox"/> MODULE <input type="checkbox"/> MICAM <input type="checkbox"/> CARD <input type="checkbox"/> PART			
EQUIPMENT IDENTIFICATION:											
7. SUBSYSTEM					NAME		PART NUMBER		S/N	MANUFACTURER	
8. UNIT											
9. <input checked="" type="checkbox"/> ASSEMBLY <input type="checkbox"/> SUBASSEMBLY STR FOOT AND REC/DEC											
					50900		202				
10. <input type="checkbox"/> MODULE <input type="checkbox"/> MICAM <input type="checkbox"/> CARD											
11. OTHER											
12. TEST WHEN FAILURE WAS OBSERVED											
<input type="checkbox"/> DEVELOPMENT <input type="checkbox"/> IN-PROCESS		<input type="checkbox"/> QUALIFICATION <input checked="" type="checkbox"/> ACCEPTANCE		<input type="checkbox"/> INTEGRATION <input type="checkbox"/> SYSTEM		<input type="checkbox"/> LAUNCH OPERATIONS					
13. ENVIRONMENT WHEN FAILURE WAS OBSERVED											
<input type="checkbox"/> AMBIENT <input type="checkbox"/> EMC/RFI		<input type="checkbox"/> RADIATION		<input checked="" type="checkbox"/> TEMP 50 .C		<input type="checkbox"/> THERMAL VAC		MRS AT		<input type="checkbox"/> OTHER	
14. DESCRIPTION OF FAILURE TEST FOR TIR RECORDS 5 FAILURES IN 2(10⁶) CYCLES AT 50°C											
15. TEST PROCEDURE 16389											
18. VERIFICATION AND FAILURE ANALYSIS		16. ORIGINATOR GOYTON		17. CONTINUATION SHEET USED		19. FAILED ITEM NAME AND PART NUMBER		20. <input checked="" type="checkbox"/> FOLLOWING REWORK/RETEST REQUIRED <input type="checkbox"/> REWORK/RETEST NOT REQUIRED BECAUSE			
SHIFT REGISTER U17		909940-1		(54165) OUTPUT AT HI TEMP (50°C) APPEARS TO SHIFT INCORRECTLY AS DOCUMENTED IN ATTACHED TEST DATA RECORD		SHIFT REGISTER (U17) 909940-1		REMOVE AND REPLACE U17 (909940-1)			
								RERUN 16389 ALSO PERFORM PENALTY TEST STR FOOT COPY ATTACHED			
21. AUTHORIZATION J.A. Sanchez											
23. REWORK/RETEST ACTION TAKEN		24. QUALIFICATION		25. QUALITY CHECK		26. LIST ALL PARTS REPLACED		27. REWORK BY		28. RETESTED BY	
U17 REPLACED STR FOOT SUCCESSFULLY COMPLETE 14055°C		115		115		PART NUMBER CKT SYM PART LOT NUMBER DATE CODE MANUFACTURER PROBABLE DEFECT ANALYSIS NUMBER		H SANCHEZ		J GUYTON	
TEST SPEC 16389 PARA 5.1 RERAN. INITIALLY FAILED AT 50°C						909940-1 U17		22-74		22-73	
AFTER ONE HOUR TESTING (2x10⁶ CYCLES) SUBSEQUENT TESTS AT 50°C								11/2		11/5 11/6	
FOR > ONE HOUR AS SPECIFIED ON 5 NOV AND 6 NOV 1981 PASSED WITHOUT FAILURE.										29. CONTINUATION SHEET USED	
30. CAUSE AND CORRECTIVE ACTION REFER TO H5 236-7714 (COPY ATTACHED)											
31. DEFECTIVE U-17 PROBABLE RARE TEMP FAILURE SHOULD BE CHECKED AT INCOMING SCREENING											
32. DOCUMENT IMPLEMENTING CORRECTIVE ACTION REFER TO H5 236-7714 (COPY ATTACHED)											
34. BASIC CAUSE OF VERIFIED FAILURE		DESIGN ENVIRONMENTAL DEFECTIVE PARTS		TEST EQUIPMENT TEST PROCEDURE TEST SET-UP		MFG. PROCEDURE ASSY/FAB ERROR WORKMANSHIP		WIRING ERROR ROUGH HANDLING WEAR-OUT		33. FRB CLOSURE	

MONITOR

ORIGINAL PAGE IS
OF POOR QUALITY

58311

T12

TEST PROGRAM NO. 12 - - - - - SERIAL MAGNITUDE CMD AUTO DATA TEST -
SENDS ALTERNATING BIT PATTERN TO IMC P.D.
READS TELEMETRY & ACTUAL OUTPUT FOR VERIF.

ENTER OPERATOR DATA, YES OR NO : Y

ASSY. NO.: ----- 50900
CARD NAME: ----- SERIAL MAG CMD REC/DEC
SERIAL NO.: ----- 202
DATE & TIME: ----- 29 OCT '81
PRI. OR RDT.: --- PRI
TEST OPERATOR: -- J GUYTON
OTHER TEST
CONDITIONS: ----- OPERATIONAL TEMPERATURE 50 DEGREES C.

TO START TEST EXECUTION
PRESS "G" KEY.

(TO TERMINATE TEST PRESS "ESC" KEY.)

5

RUN WITH CONSTANT DELAY, YES OR NO : YESS
PRINT VERIFICATION ERRORS, YES OR NO : YES

50 DEGREES C REACHED AT 10:15

*See
FIR 8311*

*0101010101010101
1010101101010101*

DATA SENT WAS 5555 TELEMETRY IS AB55 ACTUAL OUTPUT IS 5555
DATA SENT WAS 5555 TELEMETRY IS AB55 ACTUAL OUTPUT IS 5555
DATA SENT WAS 5555 TELEMETRY IS AB55 ACTUAL OUTPUT IS 5555
DATA SENT WAS 5555 TELEMETRY IS AB55 ACTUAL OUTPUT IS 5555
DATA SENT WAS 5555 TELEMETRY IS AB55 ACTUAL OUTPUT IS 5555

CURRENT CYCLE COUNT IS : 0002079500

CURRENT ERROR COUNT IS : 0000000005

- - TESTING COMPLETED - -

DATE & TIME: ----- 29 OCT '81 11:15
PRI. OR RDT.: --- PRI
TEST OPERATOR: -- J GUYTON
OTHER TEST
CONDITIONS: ----- PRIMARY SIDE DATA CYCLING AT 50 DEGREE C
TERMINATED AT 11:15

MONITOR

*FIR 8311
J Guyton
29 OCT '81*

TEST DATA RECORD SHEET

ORIGINAL PAGE IS
OF POGR QUALITY

Assembly 50900 (PWS A10)

Step	Ref. Spec. Paragraph	Measurement	Observed Value	Requirement
1.	5.1.6.3	U1-emitter voltage	<u>+4.97</u>	+5.0 \pm 0.2 vdc
2.	5.1.7.1	PRI current, nominal line	<u>87.6 mA</u>	\leq 0.30 amperes
3.	5.1.7.2	PRI current, low line	<u>86.0 mA</u>	Nominal Value \pm 10%
4.	5.1.7.3	PRI current, high line	<u>87.7 mA</u>	Nominal Value \pm 10%
5.	5.1.8.2	U21-emitter voltage	<u>+5.10</u>	+5.0 \pm 0.2 vdc
6.	5.1.9.1	RDT, current, nominal line	<u>91.8 mA</u>	\leq 0.30 amperes
7.	5.1.9.2	RDT current, low line	<u>90.0 mA</u>	Nominal Value \pm 10%
8.	5.1.9.3	RDT current, high line	<u>91.9 mA</u>	Nominal Value \pm 10%

9. At the conclusion of testing, verify that all appropriate entries have been made on the terminal printout either from the terminal or in long hand by the test operator.

J. Howard NOV 18 1981

10. Verify that the original of the terminal printout has been reproduced for the purpose of maintaining a permanent record. (The thermal paper used by the terminals deteriorates with time.)

JK

11. Signatures:

Test Engineer *J. Howard* Date 11-6-81

Design Engineer _____ Date _____

Quality Assurance *JH* *Brooks* Date 11-6-81

RETEST FOR F/R 8311 AFTER U17 REPLACEMENT

SIZE A	CODE IDENT NO 11323	NUMBER 16389
SCALE	REV B	SHEET 21

58311

ORIGINAL PAGE IS
OF POOR QUALITY

T12
TEST PROGRAM NO. 12 - - - - - > SERIAL MAGNITUDE CMD AUTO DATA TEST -
SENDS ALTERNATING BIT PATTERN TO SMC R/D, AN
READS TELEMETRY & ACTUAL OUTPUT FOR VERF.

ENTER OPERATOR DATA: YES OR NO : Y

ASSY. NO.: ----- 50900
CARD NAME: ----- SER MAG CMD REC/DEC (A10)
SERIAL NO.: ----- 202
DATE & TIME: ----- 5 NOV '81
PRI. OR RDT.: --- PRI
TEST OPERATOR: -- J GUYTON
OTHER TEST
CONDITIONS: ----- OPERATIONAL TEMP 50 DEGREES C AT 10:44
(PRI)

TO START TEST EXECUTION
PRESS "G" KEY.

(TO TERMINATE TEST PRESS "ESC" KEY.)
G

RUN WITH CONSTANT DELAY: YES OR NO : Y
PRINT VERIFICATION ERRORS: YES OR NO : Y

CURRENT CYCLE COUNT IS : 0001858252
CURRENT ERROR COUNT IS : 0000000000

- - TESTING COMPLETED - -

DATE & TIME: ----- 5 NOV '81 11:44
PRI. OR RDT.: --- PRI
TEST OPERATOR: -- J GUYTON *Delayed 5 Nov '81*
OTHER TEST
CONDITIONS: ----- TERMINATE DATA CYCLING AT 50 DEGREES C (PRI)

*Retest
P/R 58311*

58311

ORIGINAL PAGE IS
OF POOR QUALITY

MONITOR

T12

TEST PROGRAM NO. 12 - - - - > SERIAL MAGNITUDE CMD AUTO DATA TEST -
SENDS ALTERNATING BIT PATTERN TO EMC R/D. AN
READS TELEMETRY & ACTUAL OUTPUT FOR VERF.

ENTER OPERATOR DATA: YES OR NO : YES

ASSY. NO.: ----- 50900
CARD NAME: ----- SER MAG CMD REC / DEC
SERIAL NO.: ----- 202
DATE & TIME: ----- 5 NOV '81 11:55
PRI. OR RDT.: --- RDT
TEST OPERATOR: -- J GUYTON
OTHER TEST
CONDITIONS: ----- OPERATIONAL TEMP (50 DEGREES C) REACHED AT 11:55

TO START TEST EXECUTION
PRESS "G" KEY.

(TO TERMINATE TEST PRESS "ESC" KEY.)
G

RUN WITH CONSTANT DELAY: YES OR NO : Y
PRINT VERIFICATION ERRORS: YES OR NO : Y

CURRENT CYCLE COUNT IS : 0001910341

CURRENT ERROR COUNT IS : 0000000000

- - TESTING COMPLETED - -

DATE & TIME: ----- 5 NOV '81 12:56
PRI. OR RDT.: --- RDT
TEST OPERATOR: -- J GUYTON *J Guyton 5 NOV '81*
OTHER TEST
CONDITIONS: ----- TERMINATE REDUNDANT DATA CYCLING AT 50 DEGREE C.
AT 12:56.

*Reset
FIR 58311*

ORIGINAL PAGE IS
OF POOR QUALITY

58311

MONITOR

T12

TEST PROGRAM NO. 12 - - - - > SERIAL MAGNITUDE CMD AUTO DATA TEST -
SENDS ALTERNATING BIT PATTERN TO SMC R/D. AND
READS TELEMETRY & ACTUAL OUTPUT FOR VEFF.

ENTER OPERATOR DATA, YES OR NO : Y

ASSY. NO.: ----- 50900
CARD NAME: ----- SER MAG CMD REC/DEC (A10)
SERIAL NO.: ----- 202
DATE & TIME: -----
PRI. OP RDT.: --- RDT 5 NOV '81 13:07
TEST OPERATOR: -- J GUYTON
OTHER TEST
CONDITIONS: ----- OPERATIONAL TEMPERATURE 0 DEGREES C.

TO START TEST EXECUTION
PRESS "G" KEY.

(TO TERMINATE TEST PRESS "ESC" KEY.)
G

RUN WITH CONSTANT DELAY, YES OR NO : Y
PRINT VERIFICATION ERRORS, YES OR NO : Y

0 DEGREE C. REACHED AT 13:14.

CURRENT CYCLE COUNT IS : 0002075128

CURRENT ERROR COUNT IS : 0003000000

- - TESTING COMPLETED - -

DATE & TIME: ----- 5 NOV '81 14:14
PRI. OP RDT.: --- RDT
TEST OPERATOR: -- J GUYTON *J Guyton 5 NOV 81*
OTHER TEST
CONDITIONS: ----- RDT SIDE DATA CYCLING AT 0 DEGREE C
TERMINATED AT 14:14

MONITOR

Reset
F/R 8311

58311

ORIGINAL PAGE IS
OF POOR QUALITY

T12
TEST PROGRAM NO. 12 - - - - > SERIAL MAGNITUDE CMD AUTO DATA TEST -
SENDS ALTERNATING BIT PATTERN TO SMC P/D. AND
READS TELEMETRY & ACTUAL OUTPUT FOR VERIF.

ENTER OPERATOR DATA. YES OR NO : Y

ASSY. NO.: ----- 50900
CARD NAME: ----- SER MAG CMD REC/DEC
SERIAL NO.: ----- 202
DATE & TIME: ---- 5 NOV '81 14:19
PRI. OR PDT.: --- PRI
TEST OPERATOR: -- J GUYTON
OTHER TEST
CONDITIONS: ----- PRI SIDE DATA CYCLING AT 0 DEGREES C
BUGUN AT 14:21

TO START TEST EXECUTION
PRESS "G" KEY.

(TO TERMINATE TEST PRESS "ESC" KEY.)
G

RUN WITH CONSTANT DELAY. YES OR NO : Y
PRINT VERIFICATION ERRORS. YES OR NO : Y

CURRENT CYCLE COUNT IS : 0001839075

CURRENT ERROR COUNT IS : 0000000000

- - TESTING COMPLETED - -

DATE & TIME: ---- 5 NOV '81 15:21
PRI. OR PDT.: --- PRI
TEST OPERATOR: -- J GUYTON *J Guyton 5 Nov '81*
OTHER TEST
CONDITIONS: ----- PRIMARY SIDE 0 DEGREE DATA CYCLING
TERMINATED AT 15:21.

MONITOR

*Retest
FKS-10*

S 0311

ORIGINAL PAGE IS
OF POOR QUALITY

MONITOR

T12
TEST PROGRAM NO. 12 - - - > SERIAL MAGNITUDE CMD AUTO DATA TEST -
SENDS ALTERNATING BIT PATTERN TO SMC R/D. /
READS TELEMETRY & ACTUAL OUTPUT FOR VEFF.

ENTER OPERATOR DATA, YES OR NO : YES

ASSY. NO.: ----- 50900
CARD NAME: ----- SER MAG CMD REC/DEC (A10)
SERIAL NO.: ----- 202
DATE & TIME: ----- 5 NOV '81 16:23
PRI. OR RDT.: --- PRI
TEST OPERATOR: -- J GUYTON
OTHER TEST
CONDITIONS: ----- PRI SIDE COLD START UP AT -25 DEGREESC.

TO START TEST EXECUTION
PRESS "G" KEY.

(TO TERMINATE TEST PRESS "ESC" KEY.)
G

RUN WITH CONSTANT DELAY, YES OR NO : Y
PRINT VERIFICATION ERRORS, YES OR NO : Y

CURRENT CYCLE COUNT IS : 0000045438
CURRENT ERROR COUNT IS : 0000000000

- - TESTING COMPLETED - -

DATE & TIME: ----- 5 NOV '81 16:23
PRI. OR RDT.: --- PRI
TEST OPERATOR: -- J GUYTON *J Guyton 5 NOV 81*
OTHER TEST
CONDITIONS: ----- TERMINATE PRI SIDE COLD START UP.

*Retest
FIR 0311*

ORIGINAL PAGE IS
OF POOR QUALITY

58311

T12
TEST PROGRAM NO. 12 - - - - > SERIAL MAGNITUDE CMD AUTO DATA TEST -
SENDS ALTERNATING BIT PATTERN TO SMC P/D. AND
READS TELEMETRY & ACTUAL OUTPUT FOR VERF.

ENTER OPERATOR DATA, YES OR NO : Y

ASSY. NO.: ----- 50900
CARD NAME: ----- SER MAG CMD REC/DEC (R10)
SERIAL NO.: ----- 202
DATE & TIME: ----- 5 NOV '81 17:23
PRI. OR RDT.: --- RDT
TEST OPERATOR: -- J GUYTON
OTHER TEST
CONDITIONS: ----- RDT SIDE COLD STARTUP AT -25 DEGREES C.

TO START TEST EXECUTION
PRESS "G" KEY.

(TO TERMINATE TEST PRESS "ESC" KEY.)
G

RUN WITH CONSTANT DELAY, YES OR NO : Y
PRINT VERIFICATION ERRORS, YES OR NO : Y

CURRENT CYCLE COUNT IS : 0000064979

CURRENT ERROR COUNT IS : 0000000000

- - TESTING COMPLETED - -

DATE & TIME: ----- 5 NOV '81 17:25
PRI. OR RDT.: --- RDT
TEST OPERATOR: -- J GUYTON *J Guyton 5 Nov '81*
OTHER TEST
CONDITIONS: ----- TERMINATE RDT SIDE COLD STARTUP.

MONITOR

*Retest
F/R 8311*

ORIGINAL PAGE IS
OF POOR QUALITY

58311

T12
TEST PROGRAM NO. 12 - - - - > SERIAL MAGNITUDE CMD AUTO DATA TEST -
SENDS ALTERNATING BIT PATTERN TO SMC R/D. A
READS TELEMETRY & ACTUAL OUTPUT FOR VERF.

ENTER OPERATOR DATA. YES OR NO : Y

ASSY. NO.: ----- 50900
CARD NAME: ----- SER MAG CMD REC/DEC (A10)
SERIAL NO.: ----- 202
DATE & TIME: ----- ~~5 NOV '81~~ 09:30 6 NOV '81 (Huyton)
PRI. OR RDT.: --- PRI
TEST OPERATOR: -- J GUYTON
OTHER TEST
CONDITIONS: ----- OPERATIONAL TEMP 50 DEGREES C REACHED AT
09:50

TO START TEST EXECUTION
PRESS "G" KEY.

(TO TERMINATE TEST PRESS "ESC" KEY.)
6

RUN WITH CONSTANT DELAY. YES OR NO : Y
PRINT VERIFICATION ERRORS. YES OR NO : Y

CURRENT CYCLE COUNT IS : 0002151151

CURRENT ERROR COUNT IS : 0000000000

- - TESTING COMPLETED - -

DATE & TIME: ----- 6 NOV '81 10:54
PRI. OR RDT.: --- PRI
TEST OPERATOR: -- J GUYTON
OTHER TEST
CONDITIONS: ----- TERMINATE PRI SIDE DATA CYCLING AT 50 DEGREES C.

MONITOR

Retest
FIRE 311

58311

STR NO F-001

PG 1 OF 1

ORIGINAL PAGE IS
OF POOR QUALITY

SPECIAL TEST REQUEST

TITLE SERIAL MAGNITUDE COMMAND BOARD 55°C PENALTY TEST ORIGINATOR J. BANACH

INSTRUMENT/MODEL TM/FLT 50900/SN 202 MAJOR TEST PHASE ASSEMBLY ACCEPTANCE TEST

APPLICABLE DOC. 16389 APPROX. TEST TIME 2 HRS.

PURPOSE OF TEST: PERFORM ADDITIONAL PENALTY TESTING AT 55°C FOR 50900 SIN 201 BOARD IN RESPONSE TO FAILURE REPORT 58311. PREVIOUS PENALTY TESTING AT 50°C AND DOCUMENTED IN HS236-7714 WAS UNACCEPTABLE TO NASA OFFICER. OAR

TEST CONFIGURATION: BOARD ASSEMBLY TEST CONFIGURATION AS DEFINED IN TEST PROCEDURE 16389 PARA 5.4.1.2

TEST PROCEDURE: PERFORM TEST PROCEDURE 16389 PARA 5.4.1.2, WITH EXCEPTION THAT IT IS DONE AT 55°C INSTEAD OF SPECIFIED 50°C

TEST SUCCESSFULLY COMPLETED. DATA ATTACHED.

Product Effectiveness J. Banach 11/17/81

TEST DIRECTOR J. Banach DATE: 11/17/81

SYST. ENGIN. J. Banach DATE: 11/17/81

(USE CONTINUATION SHEETS IF REQUIRED)

58311

ORIGINAL PAGE IS
OF POOR QUALITY

MONITOR

T12
TEST PROGRAM NO. 12 - - - - > SERIAL MAGNITUDE CMD AUTO DATA TEST -
SENDS ALTERNATING BIT PATTERN TO SMC R/D, AND
READS TELEMETRY & ACTUAL OUTPUT FOR VERF.

ENTER OPERATOR DATA, YES OR NO : Y

ASSY. NO.: ----- 50900
CARD NAME: ----- SER MAG CMD REC/DEC (A10)
SERIAL NO.: ----- 202
DATE & TIME: ----- 17 NOV '81 16:00
PRI. OR RDT.: --- PRI
TEST OPERATOR: -- J GUYTON
OTHER TEST
CONDITIONS: ----- SPECIAL TEST REQUEST F-001, PRI SIDE DATA CYCLING AT
55 DEGREES C. (16389 PAR.5.4.1.2) RETEST.

TO START TEST EXECUTION
PRESS "G" KEY.

(TO TERMINATE TEST PRESS "ESC" KEY.)
G

RUN WITH CONSTANT DELAY, YES OR NO : Y
PRINT VERIFICATION ERRORS, YES OR NO : Y

55 DEGREES C REACHED AT 16:10

CURRENT CYCLE COUNT IS : 0002021729

CURRENT ERROR COUNT IS : 0000000000

- - TESTING COMPLETED - -

DATE & TIME: ----- 17 NOV '81 17:10
PRI. OR RDT.: --- PRI
TEST OPERATOR: -- J GUYTON *J Guyton*
OTHER TEST
CONDITIONS: ----- TERMINATE SPECIAL TEST F-001, PRI SIDE DATA CYCLING AT
55 DEGREES C.

MONITOR

HUGHES

HUGHES AIRCRAFT COMPANY
SPACE AND COMMUNICATIONS GROUP
EL SEGUNDO, CALIFORNIA

SPACE AND COMMUNICATIONS GROUP

FAILURE REPORT

ORIGINAL PAGE IS
OF POOR QUALITY

S 8312

ORIGINATOR	1. PROGRAM NAME AND NUMBER THEMATIC MAPPER	2. GLA	3. MODEL FLT	4. TIME OBSERVED 13:00	5. DATE OBSERVED MO 10 DA 30 YR 81	
	6. HARDWARE LEVEL WHEN FAILURE WAS OBSERVED <input type="checkbox"/> SPACECRAFT <input type="checkbox"/> SUBSYSTEM <input checked="" type="checkbox"/> ASSEMBLY <input type="checkbox"/> MODULE <input type="checkbox"/> CARD <input type="checkbox"/> SYSTEM <input type="checkbox"/> UNIT <input type="checkbox"/> SUBASSEMBLY <input type="checkbox"/> MICAM <input type="checkbox"/> PART					
	EQUIPMENT IDENTIFICATION: 7. SUBSYSTEM	NAME	PART NUMBER	S/N	MANUFACTURER	
	8. UNIT					
ENGINEERING EVALUATION	9. <input checked="" type="checkbox"/> ASSEMBLY <input type="checkbox"/> SUBASSEMBLY <input type="checkbox"/> MODULE <input type="checkbox"/> MICAM <input type="checkbox"/> CARD	NAME VENTILATED REG (AIR)	PART NUMBER 50948	S/N 201		
	10. <input type="checkbox"/> MODULE <input type="checkbox"/> MICAM <input type="checkbox"/> CARD					
	11. OTHER					
	12. TEST WHEN FAILURE WAS OBSERVED <input type="checkbox"/> DEVELOPMENT <input type="checkbox"/> IN-PROCESS <input type="checkbox"/> QUALIFICATION <input checked="" type="checkbox"/> ACCEPTANCE <input type="checkbox"/> INTEGRATION <input type="checkbox"/> SYSTEM <input type="checkbox"/> LAUNCH OPERATIONS					
ENGINEERING AND TEST	13. ENVIRONMENT WHEN FAILURE WAS OBSERVED <input checked="" type="checkbox"/> AMBIENT <input type="checkbox"/> ENC/RR <input type="checkbox"/> RADIATION <input type="checkbox"/> VIBRATION	TEMP	THERMAL VAC	HRS AT		
	14. DESCRIPTION OF FAILURE TEST PER 8 FAILS 'BOARD F OUTPUT - RDT'					
	15. TEST PROCEDURE 16422	PARA 5.1	16. ORIGINATOR GUYTON	17. CONTINUATION SHEET USED <input type="checkbox"/>		
	18. VERIFICATION AND FAILURE ANALYSIS R108 IS SHORT-CIRCUITED BY A BRIDGE AT R108. NO OVERSTRESS OCCURRED.					
MANUFACTURING AND TEST	19. FAILED ITEM NAME AND PART NUMBER DEF HS 236-7745 (COPY ATTACHED)					
	20. <input checked="" type="checkbox"/> FOLLOWING REWORK/RETEST REQUIRED <input type="checkbox"/> REWORK/RETEST NOT REQUIRED BECAUSE REMOVE PWS DEFECT (BRIDGE) AT R108. RETEST PER 16422					
	21. AUTHORIZATION GUYTON	18. ORG 22-13	DATE 10/30/81	22. CONTINUATION SHEET USED <input type="checkbox"/>		
	23. REWORK/RETEST ACTION TAKEN BRIDGE AT R108 REMOVED. RETESTED PER TEST PROCEDURE 16422 PARA 5.1					
ENGINEERING/RELIABILITY	24. LIST ALL PARTS REPLACED PART NUMBER	CXT SYM	PART LOT NUMBER	DATE CODE	MANUFACTURER	PROBABLE DEFECT
	25. REWORK BY L TORRES	ORG 22-74	DATE 30 OCT 1981	26. RETESTED BY J. GUYTON	ORG 22-13	DATE 4 NOV 1981
	27. CAUSE AND CORRECTIVE ACTION BAD PRINTED WIRE BOARD FABRICATION CAUSED PROBLEM. DE 11/23/81					
	28. DOCUMENT IMPLEMENTING CORRECTIVE ACTION UPDATE HS 236-7745 (COPY ATTACHED)					
29. BASIC CAUSE OF VERIFIED FAILURE <input checked="" type="checkbox"/> DESIGN <input type="checkbox"/> ENVIRONMENTAL <input type="checkbox"/> DEFECTIVE PARTS <input type="checkbox"/> TEST EQUIPMENT <input type="checkbox"/> TEST PROCEDURE <input type="checkbox"/> TEST SET-UP <input type="checkbox"/> MFG. PROCEDURE <input type="checkbox"/> ASSY/FAB ERROR <input type="checkbox"/> WORKMANSHIP <input type="checkbox"/> WIRING ERROR <input type="checkbox"/> ROUGH HANDLING <input type="checkbox"/> WEAR-OUT	30. FAILURE TYPE <input checked="" type="checkbox"/> PRIMARY <input type="checkbox"/> INDUCED <input type="checkbox"/> UNKNOWN <input type="checkbox"/> NO FAILURE	31. FAILURE CLASSIFICATION <input type="checkbox"/> CRITICAL <input checked="" type="checkbox"/> MAJOR <input type="checkbox"/> MINOR <input type="checkbox"/> SAFETY	32. APACRAFT SYSTEM ENGINEER J. TORRES	ORG 22-41	DATE 11/17/81	DEFECT CODE
33. FAILURE CLASSIFICATION <input type="checkbox"/> CRITICAL <input checked="" type="checkbox"/> MAJOR <input type="checkbox"/> MINOR <input type="checkbox"/> SAFETY	34. APACRAFT SYSTEM ENGINEER J. TORRES	ORG 22-13	DATE 4 NOV 1981	35. CUSTOMER OR SUPPLIER HS	ORG 22-41	DATE 11/17/81



SPACE AND COMMUNICATION GROUP
EQUIPMENT CHECKOUT
FAILURE REPORT
CONTINUATION SHEET

ORIGINAL PAGE IS
OF POOR QUALITY

58312 CONT. SHEET
FR SERIAL NO. LETTER*

*LABEL FIRST CONTINUATION SHEET USED 'A', SECOND 'B', AND SO ON

ADDITIONAL FR
CONTINUATION
SHEET(S) USED

IDENTIFY ENTRIES BY REFERENCING FR BLOCK NUMBER IN COLUMN, DATE EACH ENTRY.

30 THE QUALITY INSPECTION SUPERVISOR JOYCE A LIPSCAMPE
WAS CONTACTED BY W D ADAMS TM PROGRAM MANAGER AND
INFORMED HER OF THE SHORT PROBLEM ON THE CIRCUIT BOARD
USED ON ASSEMBLY 50940 S/U SOL. SHE HAS CONTACTED
MANUFACTURING AND QUALITY PERSONNEL AND TOLD THEM TO
USE MORE CARE DURING INSPECTION AND MANUFACTURING OF
FUTURE BOARDS TO PREVENT RE-~~PE~~ RECURRENCE
OF THIS PROBLEM.

W D Adams
12-2-81



ORIGINAL PAGE IS OF POOR QUALITY

HUGHES AIRCRAFT COMPANY
SPACE AND COMMUNICATIONS GROUP
EL SEGUNDO, CALIFORNIA

SPACE AND COMMUNICATIONS GROUP
FAILURE REPORT

S 8313

1. PROGRAM NAME AND NUMBER <i>The Metic Mapper HS 236</i>		2. GLA <i>GLA</i>	3. MODEL <i>FLT</i>	4. TIME OBSERVED <i>10:00</i>	5. DATE OBSERVED <i>MG 11 DA 4 YR 81</i>
6. HARDWARE LEVEL WHEN FAILURE WAS OBSERVED <input type="checkbox"/> SPACECRAFT <input type="checkbox"/> SYSTEM		<input type="checkbox"/> SUBSYSTEM <input type="checkbox"/> UNIT	<input type="checkbox"/> ASSEMBLY <input checked="" type="checkbox"/> SUBASSEMBLY	<input type="checkbox"/> MODULE <input type="checkbox"/> MICAM	<input type="checkbox"/> CARD <input type="checkbox"/> PART
EQUIPMENT IDENTIFICATION: NAME PART NUMBER S/N MANUFACTURER					
7. SUBSYSTEM					
8. UNIT					
9. <input type="checkbox"/> ASSEMBLY <input checked="" type="checkbox"/> SUBASSEMBLY <i>50926 201 SBRC</i>					
10. <input type="checkbox"/> MODULE <input type="checkbox"/> MICAM <input type="checkbox"/> CARD					
11. OTHER					
12. TEST WHEN FAILURE WAS OBSERVED <input type="checkbox"/> DEVELOPMENT <input type="checkbox"/> IN-PROCESS <input type="checkbox"/> QUALIFICATION <input type="checkbox"/> ACCEPTANCE <input type="checkbox"/> INTEGRATION <input type="checkbox"/> SYSTEM <input type="checkbox"/> LAUNCH OPERATIONS					
13. ENVIRONMENT WHEN FAILURE WAS OBSERVED <input checked="" type="checkbox"/> AMBIENT <input type="checkbox"/> EMC/RF <input type="checkbox"/> RADIATION <input type="checkbox"/> VIBRATION <input type="checkbox"/> TEMP <input type="checkbox"/> THERMAL VAC <input type="checkbox"/> MRS AT <input type="checkbox"/> OTHER					
14. DESCRIPTION OF FAILURE <i>Failed para 3.3.2.3 SBRC 16234 (AR-2 & AR-5 HAVE EXCESSIVE OFFSET)</i>					
15. TEST PROCEDURE <i>16234</i>		16. ORIGINATOR <i>R. Kloss</i>	17. CONTINUATION SHEET USED <input type="checkbox"/>	18. VERIFICATION AND FAILURE ANALYSIS <i>JUMPERS ACROSS DESIGNATED R35, R59, and R77 pads were missing per blueprint 50926 and stressed AR2, AR5, and AR8. (908961-4). A LATER REVIEW OF THE EFFECTS OF MISWIRING DISCREPANCY SHOW THAT NO STRESSOR</i>	
19. FAILED ITEM NAME AND PART NUMBER <i>AR2, AR5, AR8 (908961-4 QTY 3)</i>					
20. <input checked="" type="checkbox"/> FOLLOWING REWORK/RETEST REQUIRED <i>Inst Fail</i> <input type="checkbox"/> REWORK/RETEST NOT REQUIRED BECAUSE <i>Jumpers per blueprint. Remove and replace AR2, AR5 & AR8. RETEST PER 3.3.2.3</i>					
21. AUTHORIZATION <i>J.A. Bonach</i>			22. CONTINUATION SHEET USED <input type="checkbox"/>	23. QA RETEST	
24. REWORK/RETEST ACTION TAKEN <i>JUMPERS INSTALLED AR2, AR5, AR8 REMOVED AND REPLACED</i>					
25. LIST ALL PARTS REPLACED					
26. PART NUMBER	27. CKT SYM	28. PART LOT NUMBER	29. DATE CODE	30. MANUFACTURER	31. PROBABLE DEFECT
<i>908961-4</i>	<i>AR2</i>				
<i>908961-4</i>	<i>AR5</i>				
<i>908961-4</i>	<i>AR8</i>				
27. REWORK BY <i>H. Sanchez</i>		28. TESTED BY <i>R. Kloss</i>	29. CONTINUATION SHEET USED <input type="checkbox"/>	30. CAUSE AND CORRECTIVE ACTION <i>OPERATOR AND QA ERROR - JUMPERS CLEARLY CALLED OUT ON BIP SHEET 3. SUPERVISORS CAUTIONED. 2/9/82</i>	
31. FRB CLOSURE					
32. DOCUMENT IMPLEMENTING CORRECTIVE ACTION					
33. BASIC CAUSE OF VERIFIED FAILURE <input type="checkbox"/> DESIGN ENVIRONMENTAL DEFECTIVE PARTS <input type="checkbox"/> TEST EQUIPMENT <input type="checkbox"/> TEST PROCEDURE <input type="checkbox"/> TEST SET-UP <input type="checkbox"/> MFG. PROCEDURE <input type="checkbox"/> ASSY/FAB ERROR <input type="checkbox"/> WORKMANSHIP <input type="checkbox"/> WIRING/LEADOR <input type="checkbox"/> ROUGH HANDLING <input type="checkbox"/> WEAR/DELIT <input type="checkbox"/> UNKNOWN					
34. FAILURE TYPE <input checked="" type="checkbox"/> PRIMARY <input type="checkbox"/> INDUCED <input type="checkbox"/> UNKNOWN <input type="checkbox"/> NO FAILURE					
35. RESPONSIBLE ENGINEER <i>J.A. Bonach</i>					
36. DATE <i>2-13-82</i>					
37. REWORK/RETEST ACTION TAKEN <i>Remove and replace AR2, AR5 & AR8. RETEST PER 3.3.2.3</i>					
38. DATE <i>2-10-82</i>					
39. CONTINUATION SHEET USED <input type="checkbox"/>					
40. DATE <i>2/12/82</i>					

HUGHES

SPACE AND COMMUNICATIONS GROUP

HUGHES AIRCRAFT COMPANY
SPACE AND COMMUNICATIONS GROUP
EL SEGUNDO, CALIFORNIA

FAILURE REPORT
CONTINUATION SHEET

FR SERIAL NO. SB313
CONTINUATION SHEET LETTER A

*LABEL FIRST CONTINUATION SHEET USED 'A', SECOND 'B', AND SO ON	ADDITIONAL FR CONTINUATION SHEETS USED <input type="checkbox"/>
<input type="checkbox"/> IDENTIFY ENTRIES BY REFERENCING FR BLOCK NUMBER IN COLUMN. DATE EACH ENTRY.	

18 WERE EXCESSIVE. THE MISSING JUMPER WIRES WERE AT THE LM 10B OUTPUTS AND PROVIDED A NO LOAD CONDITION TO THE DEVICES. A LABORATORY CHECK OF A REMOVED AMPLIFIER (AZB) SHOWED NO VARIATION FROM A LABORATORY SAMPLE WHEN TESTED ON A CURVE TRACER - UP 2-16-82

HUGHES

SPACE AND COMMUNICATIONS GROUP
FAILURE REPORT

ORIGINAL PAGE IS
OF POOR QUALITY

S 8314

HUGHES AIRCRAFT COMPANY
SPACE AND COMMUNICATIONS GROUP
51 DEQUINDO, CALIFORNIA

1. PROGRAM NAME AND NUMBER <i>THEMATIC ANALYSIS H5236</i>		2. GLA		3. MODEL <i>RT</i>		4. TIME OBSERVED <i>09:37:01</i>		5. DATE OBSERVED <i>MO 11 DAY 4 YR 81</i>	
6. HARDWARE LEVEL WHEN FAILURE WAS OBSERVED <input type="checkbox"/> SPACECRAFT <input type="checkbox"/> SUBSYSTEM <input type="checkbox"/> UNIT <input checked="" type="checkbox"/> ASSEMBLY <input type="checkbox"/> SUBASSEMBLY <input type="checkbox"/> MODULE <input type="checkbox"/> MCMAM <input type="checkbox"/> CARD <input type="checkbox"/> PART									
EQUIPMENT IDENTIFICATION:									
7. SUBSYSTEM		NAME		PART NUMBER		S/N		MANUFACTURER	
8. UNIT									
9. <input checked="" type="checkbox"/> ASSEMBLY <input type="checkbox"/> SUBASSEMBLY <i>VERIFICATION RESISTOR 50948</i> <i>201</i>									
10. <input type="checkbox"/> MODULE <input type="checkbox"/> MCMAM <input type="checkbox"/> CARD									
11. OTHER									
12. TEST WHEN FAILURE WAS OBSERVED <input type="checkbox"/> DEVELOPMENT <input type="checkbox"/> IN-PROCESS <input checked="" type="checkbox"/> QUALIFICATION <input checked="" type="checkbox"/> ACCEPTANCE <input type="checkbox"/> INTEGRATION <input type="checkbox"/> SYSTEM <input type="checkbox"/> LAUNCH OPERATIONS									
13. ENVIRONMENT WHEN FAILURE WAS OBSERVED <input checked="" type="checkbox"/> AMBIENT <input type="checkbox"/> EMC/RR <input type="checkbox"/> RADIATION <input type="checkbox"/> VIBRATION <input type="checkbox"/> TEMP <input type="checkbox"/> THERMAL VAC <input type="checkbox"/> HRS AT <input type="checkbox"/> AXIS FOR <input type="checkbox"/> MIN TYPE <input type="checkbox"/> OTHER									
14. DESCRIPTION OF FAILURE <i>FAILS TO DEVELOP PROPER SIGNAL AT U3-6 DUE TO BAD SOLDER CONNECTION AT U3-14.</i>									
15. TEST PROCEDURE <i>16422</i> <i>5.6-4</i> 16. ORIGINATOR <i>GUYTON</i> <i>22-13</i> DATE <i>11/4/81</i> 17. CONTINUATION SHEET USED <input type="checkbox"/>									
18. VERIFICATION AND FAILURE ANALYSIS <i>BAD SOLDER JOINT. NO OVERSTRESS OCCURRED.</i>									
19. FAILED ITEM NAME AND PART NUMBER									
20. <input checked="" type="checkbox"/> FOLLOWING REWORK/RETEST REQUIRED <input type="checkbox"/> REWORK/RETEST NOT REQUIRED BECAUSE <i>RESOLDER U3-14</i>									
21. AUTHORIZATION <i>Chas Floyd</i> <i>22-13</i> DATE <i>11/4/81</i> 22. CONTINUATION SHEET USED <input type="checkbox"/>									
23. REWORK/RETEST ACTION TAKEN <i>U3 PIN 14 RESOLDERED. RETESTED PER TEST PROCEDURE 16422 PARA 5.1 (SEE ATTACHED)</i>									
24. LIST ALL PARTS REPLACED									
PART NUMBER									
CXT SYM									
PART LOT NUMBER									
DATE CODE									
MANUFACTURER									
PROBABLE DEFECT									
ANALYSIS NUMBER									
27. REWORK BY <i>H. SANCHEZ</i> ORG <i>22-74</i> DATE <i>4 NOV 1981</i> 28. RETESTED BY <i>J. GUYTON</i> ORG <i>22-13</i> DATE <i>4 NOV 1981</i> 29. CONTINUATION SHEET USED <input type="checkbox"/>									
30. CAUSE AND CORRECTIVE ACTION <i>BAD WORKMANSHIP, missed inspection point on back of popper inspection. The responsible inspector has been notified of this error and contacted to special quality case. Inspector disp [signature].</i>									
31. CONTINUATION SHEET USED <input type="checkbox"/>									
32. DOCUMENT IMPLEMENTING CORRECTIVE ACTION <i>NONE</i>									
34. BASIC CAUSE OF VERIFIED FAILURE <input type="checkbox"/> DESIGN <input type="checkbox"/> ENVIRONMENTAL <input type="checkbox"/> DEFECTIVE PARTS <input type="checkbox"/> TEST EQUIPMENT <input type="checkbox"/> TEST PROCEDURE <input type="checkbox"/> TEST SET-UP <input type="checkbox"/> MFG. PROCEDURE <input type="checkbox"/> ASSY/FAB ERROR <input checked="" type="checkbox"/> WORKMANSHIP <input type="checkbox"/> WIRING ERROR <input type="checkbox"/> ROUGH HANDLING <input type="checkbox"/> WEAR-OUT <input type="checkbox"/> UNKNOWN <input type="checkbox"/> DEFECT CODE									
35. FAILURE TYPE <input checked="" type="checkbox"/> PRIMARY <input type="checkbox"/> INDUCED <input type="checkbox"/> UNKNOWN <input type="checkbox"/> NO FAILURE									
36. FAILURE CLASSIFICATION <input type="checkbox"/> CRITICAL <input checked="" type="checkbox"/> MAJOR <input type="checkbox"/> MINOR <input type="checkbox"/> SAFETY									
37. RESPONSIBLE ENGINEER <i>Ed Brnach</i> ORG <i>22-13</i> DATE <i>NOV 4 1981</i> 38. PROCECRAFT SYSTEM ENGINEER <i>W. Engle</i> ORG <i>22-41</i> DATE <i>11/18/81</i>									
39. RELIABILITY <i>D. Crow</i> ORG <i>55-41</i> DATE <i>11-18-1981</i> 40. CUSTOMER OR SUPPLIER									

HUGHES

HUGHES AIRCRAFT COMPANY
SPACE AND COMMUNICATIONS GROUP
EL SEGUNDO, CALIFORNIA

SPACE AND COMMUNICATIONS GROUP
FAILURE REPORT

ORIGINAL PAGE IS
OF POOR QUALITY
S 8315

1. PROGRAM NAME AND NUMBER TM		2. GLA	3. MODEL FLT	4. TIME OBSERVED 3:00	5. DATE OBSERVED MO 11 DA 6 YR 81
6. HARDWARE LEVEL WHEN FAILURE WAS OBSERVED	<input type="checkbox"/> SPACECRAFT <input type="checkbox"/> SYSTEM	<input type="checkbox"/> SUBSYSTEM <input type="checkbox"/> UNIT	<input type="checkbox"/> ASSEMBLY <input type="checkbox"/> SUBASSEMBLY	<input type="checkbox"/> MODULE <input type="checkbox"/> MICAM	<input checked="" type="checkbox"/> CARD <input type="checkbox"/> PART
EQUIPMENT IDENTIFICATION:					
7. SUBSYSTEM		NAME	PART NUMBER	S/N	MANUFACTURER
8. UNIT Tel Sealing - Facelid - Lamp Sequence			51402	201	
9. <input checked="" type="checkbox"/> ASSEMBLY <input type="checkbox"/> SUBASSEMBLY		- Buff 1 (IAP)			
10. <input type="checkbox"/> MODULE <input type="checkbox"/> MICAM <input type="checkbox"/> CARD					
11. OTHER					
12. TEST WHEN FAILURE WAS OBSERVED		<input type="checkbox"/> DEVELOPMENT <input type="checkbox"/> IN-PROCESS	<input type="checkbox"/> QUALIFICATION <input checked="" type="checkbox"/> ACCEPTANCE	<input type="checkbox"/> INTEGRATION <input type="checkbox"/> SYSTEM	<input type="checkbox"/> LAUNCH OPERATIONS
13. ENVIRONMENT WHEN FAILURE WAS OBSERVED		<input checked="" type="checkbox"/> AMBIENT <input type="checkbox"/> EMC/RFI	<input type="checkbox"/> RADIATION <input type="checkbox"/> VIBRATION	<input type="checkbox"/> TEMP _____ ° AXIS FOR _____ MIN TYPE _____	<input type="checkbox"/> THERMAL VAC _____ HRS AT _____ ° <input type="checkbox"/> OTHER
14. DESCRIPTION OF FAILURE The All Lamps on LED failed to turn on at the proper time in the call lamp sequence					
15. TEST PROCEDURE 162P2		PARA 4.3.2	10. ORIGINATOR Joe Kleeburg	ORG 22-13	DATE 11/6/81
16. VERIFICATION AND FAILURE ANALYSIS Base lead of Q10 is not making electrical contact with pad on the circuit board.		17. CONTINUATION SHEET USED <input type="checkbox"/>			
18. FAILED ITEM NAME AND PART NUMBER					
19. FOLLOWING REWORK/RETEST REQUIRED <input type="checkbox"/> REWORK/RETEST NOT REQUIRED BECAUSE Resolder Q10 Base pad lead to circuit trace per MRCO 29842R Retest per TP 16282 Para 4.3.2					
20. REWORK/RETEST ACTION TAKEN Jumper lead soldered per MRCO 299142R Retested per TP 16282 Para 4.3.2 - (SEE ATTACHED)		21. AUTHORIZATION J.A. Bonach		ORG 22-13	DATE 11-6-81
22. CONTINUATION SHEET USED <input type="checkbox"/>		23. DATE OF TEST 11-10-81		24. CONTINUATION SHEET USED <input type="checkbox"/>	
25. LIST ALL PARTS REPLACED		CKT SYM	PART LOT NUMBER	DATE CODE	MANUFACTURER
PART NUMBER					PRESUMABLE DEFECT
					ANALYSIS NUMBER
27. REWORK BY H. SANCHEZ		ORG 22-74	DATE 4-9-81	28. RETESTED BY J. KLEEBURG	ORG 22-13
DATE 1-11-81		29. CONTINUATION SHEET USED <input type="checkbox"/>		30. CAUSE AND CORRECTIVE ACTION IN BONDING Q10 Base pad the trace contact was damaged and intermittent. - NO OTHER COMPONENTS STRESSED	
31. Greater care in El Segundo bonding operation is needed. FRB CLOSURE					
32. Mr Otto Noland and Mr Miller the supervisor of the quality assembly have been having trouble up thru discrepancy by vendors. MR Miller will be inspecting more carefully prior to work will be inspected more carefully prior to shipment to SAR.					
33. DOCUMENT IMPLEMENTING CORRECTIVE ACTION WOL 11-18-81		31. CONTINUATION SHEET USED <input type="checkbox"/>			
34. BASIC CAUSE OF VERIFIED FAILURE		<input type="checkbox"/> DESIGN <input type="checkbox"/> ENVIRONMENTAL <input type="checkbox"/> DEFECTIVE PARTS	<input type="checkbox"/> TEST EQUIPMENT <input type="checkbox"/> TEST PROCEDURE <input type="checkbox"/> TEST SET-UP	<input type="checkbox"/> MFG. PROCEDURE <input type="checkbox"/> ASST/FAB ERROR <input type="checkbox"/> WORKMANSHIP	<input type="checkbox"/> WIRING ERROR <input type="checkbox"/> ROUGH HANDLING <input type="checkbox"/> WEAR-OUT
35. FAILURE TYPE <input checked="" type="checkbox"/> PRIMARY <input type="checkbox"/> INDUCED		<input type="checkbox"/> UNKNOWN <input type="checkbox"/> NO FAILURE	36. FAILURE CLASSIFICATION <input type="checkbox"/> CRITICAL <input checked="" type="checkbox"/> MAJOR		<input type="checkbox"/> MINOR <input type="checkbox"/> SAFETY
37. RESPONSIBLE ENGINEER J.A. Bonach		ORG 22-13	DATE 11-17-81	38. AIRCRAFT SYSTEM ENGINEER W. J. ...	
39. RELIABILITY Dr. Grand		ORG 51-41	DATE 11-18-81	40. TEST CENTER OR SUPPLIER ...	

17-191

HUGHES

SPACE AND COMMUNICATIONS GROUP
FAILURE REPORT

ORIGINAL PAGE IS
OF POOR QUALITY

HUGHES AIRCRAFT COMPANY
SPACE AND COMMUNICATIONS GROUP
EL SEGUNDO, CALIFORNIA

S 8316

1 PROGRAM NAME AND NUMBER <i>Thermal Analysis HS236</i>		2 GLA	3 MODEL <i>RT</i>	4 TIME OBSERVED <i>14:10</i>	5 DATE OBSERVED <i>MO 11 DA 9 YR 81</i>
6 HARDWARE LEVEL WHEN FAILURE WAS OBSERVED <input type="checkbox"/> SPACECRAFT <input type="checkbox"/> SUBSYSTEM <input checked="" type="checkbox"/> ASSEMBLY <input type="checkbox"/> MODULE <input type="checkbox"/> CARD <input type="checkbox"/> SYSTEM <input type="checkbox"/> UNIT <input type="checkbox"/> SUBASSEMBLY <input type="checkbox"/> MICAM <input type="checkbox"/> PART					
EQUIPMENT IDENTIFICATION: NAME PART NUMBER S/N MANUFACTURER					
7 SUBSYSTEM					
8 UNIT					
9 <input type="checkbox"/> ASSEMBLY <input type="checkbox"/> SUBASSEMBLY <input checked="" type="checkbox"/> REPAIRS MODULE					
10 <input type="checkbox"/> MODULE <input type="checkbox"/> MICAM <input checked="" type="checkbox"/> CARD <i>AR2-8</i> <i>5175</i> <i>102</i>					
11 OTHER					
12 TEST WHEN FAILURE WAS OBSERVED <input type="checkbox"/> DEVELOPMENT <input type="checkbox"/> QUALIFICATION <input type="checkbox"/> INTEGRATION <input type="checkbox"/> LAUNCH OPERATIONS <input checked="" type="checkbox"/> IN-PROCESS <input checked="" type="checkbox"/> ACCEPTANCE <input type="checkbox"/> SYSTEM					
13 ENVIRONMENT WHEN FAILURE WAS OBSERVED <input checked="" type="checkbox"/> AMBIENT <input type="checkbox"/> RADIATION <input type="checkbox"/> TEMP <input type="checkbox"/> THERMAL VAC <input type="checkbox"/> HRD AT <input type="checkbox"/> EMC/RF <input type="checkbox"/> VIBRATION <input type="checkbox"/> AXIS FOR <input type="checkbox"/> MIN TYPE <input type="checkbox"/> OTHER					
14 DESCRIPTION OF FAILURE <i>'CROSSTALK' AR2-8 TO AR2-10. ON THE AR2 PIN 9 OUTPUT, THE HI LEVEL OF 4V HAS A 0.5VPP WAVEFORM RIDING AT THE CLOCK FREQUENCY. NOTE THIS TTL HI LEVEL SIGNAL STILL PROVIDES A NOISE MARGIN GREATER THAN 1.5V ABOVE THE MINIMUM 2.0V TTL HI REQUIRED BY RECEIVING IC'S.</i>					
15 TEST PROCEDURE <i>16423</i> <i>1 PARA 5.3.5.4</i> <i>J. GUYTON</i> <i>22-13</i> <i>9/19/81</i> 17 CONTINUATION SHEET USED <input type="checkbox"/>					
10. VERIFICATION AND FAILURE ANALYSIS <i>SUSPECT FAULTY CHIP AR-2, DATA LINE REC (AS7820)</i>					
13. FAILED ITEM NAME AND PART NUMBER <i>AR-2 (909992-1)</i>					
20. <input checked="" type="checkbox"/> FOLLOWING REWORK/RETEST REQUIRED <input type="checkbox"/> REWORK/RETEST NOT REQUIRED BECAUSE <i>REMOVE AND REPLACE AR-2</i>					
RETEST PER TP 16423 PARA 5.3.5.4					
21. AUTHORIZATION <i>J.A. Bonach</i> 18 ORG <i>22-13</i> 19 DATE <i>11-9-81</i> 22 CONTINUATION SHEET USED <input type="checkbox"/>					
23. REWORK/RETEST ACTION TAKEN <i>SEE DATA SHEET OF 11-10-81, SRC 16423, & WAVEFORM PHOTOS</i> <i>SEE AHR 5175, SUPPL 13, DP 403, 404 FOR REMOVAL OF AR-2</i>					
24. LIST ALL PARTS REPLACED PART NUMBER CXT SYM PART LOT NUMBER DATE CODE MANUFACTURER PROBABLE DEFECT ANALYSIS NUMBER					
27. REWORK BY <i>L. TORRES</i> 28 ORG <i>22-73</i> 29 DATE <i>11/10/81</i> 30 RETESTED BY <i>J. GUYTON</i> 31 ORG <i>22-73</i> 32 DATE <i>11/19/81</i> 33 CONTINUATION SHEET USED <input type="checkbox"/>					
34. CAUSE AND CORRECTIVE ACTION <i>EVEN THOU THE CHIP WAS WITHIN THE ALLOWABLE PARAMETERS, THE REA WAS HOPING TO IMPROVE THIS PARAMETER BY REPLACING THE CHIP.</i> <i>IN ESSENCE THIS F.R. WAS OPEN IN ERROR. THERE WAS NO "FAULTY" CHIP. UNNECESSARY REPLACEMENT OF CHIP.</i>					
35. DOCUMENT IMPLEMENTING CORRECTIVE ACTION					
36. BASIC CAUSE OF VERIFIED FAILURE <input type="checkbox"/> DESIGN ENVIRONMENTAL DEFECTIVE PARTS <input type="checkbox"/> TEST EQUIPMENT TEST PROCEDURE TEST SET-UP <input type="checkbox"/> MFG. PROCEDURE ASSY/FAB ERROR WORKMANSHIP <input type="checkbox"/> WIRING ERROR ROUGH HANDLING WEAR-OUT <input type="checkbox"/> UNKNOWN					
37. FAILURE TYPE <input type="checkbox"/> PRIMARY <input type="checkbox"/> UNKNOW <input type="checkbox"/> NO FAILURE <input type="checkbox"/> FAILURE CLASSIFICATION <input type="checkbox"/> CRITICAL <input type="checkbox"/> MINOR <input type="checkbox"/> MAJOR <input type="checkbox"/> SAFETY					
38. RESPONSIBLE ENGINEER <i>J.A. Bonach</i> 39 ORG <i>22-13</i> 40 DATE <i>12-7-81</i> 41 SPECIALIST SYSTEM ENGINEER <i>J.A. Bonach</i> 42 ORG <i>22-41</i> 43 DATE <i>8/12/81</i>					
39. RELIABILITY <i>Doc Grant</i> 40 ORG <i>51-41</i> 41 DATE <i>12-7-81</i> 42 ESTIMATOR OR SUPPLIER <i>V.L.</i> 43 DATE <i>10/22/81</i>					

HUGHES

HUGHES AIRCRAFT COMPANY
SPACE AND COMMUNICATIONS GROUP
EL SEGUNDO, CALIFORNIA

SPACE AND COMMUNICATIONS GROUP
FAILURE REPORT

ORIGINAL PAGE IS
OF POOR QUALITY

S 8320

ORIGINATOR	1. PROGRAM NAME AND NUMBER T.M. VO11		2. GLA		3. MODEL FLIGHT		4. TIME OBSERVED 3:30 p.m.		5. DATE OBSERVED MO 9 DA 24 YR 81			
	3. HARDWARE LEVEL WHEN FAILURE WAS OBSERVED		<input type="checkbox"/> SPACECRAFT <input type="checkbox"/> SYSTEM		<input type="checkbox"/> SUBSYSTEM <input type="checkbox"/> UNIT		<input checked="" type="checkbox"/> ASSEMBLY <input type="checkbox"/> SUBASSEMBLY		<input type="checkbox"/> MODULE <input type="checkbox"/> MICAM			
	EQUIPMENT IDENTIFICATION:		NAME		PART NUMBER		S/N		MANUFACTURER			
	7. SUBSYSTEM											
	8. UNIT		ELECTRONIC MODULE		52347							
	9. <input type="checkbox"/> ASSEMBLY <input checked="" type="checkbox"/> SUBASSEMBLY		BAND 2 POST AMP		50904-2		201		SBRC			
	10. <input type="checkbox"/> MODULE <input type="checkbox"/> MICAM <input type="checkbox"/> CARD											
	11. OTHER											
	12. TEST WHEN FAILURE WAS OBSERVED		<input type="checkbox"/> DEVELOPMENT <input type="checkbox"/> IN-PROCESS		<input type="checkbox"/> QUALIFICATION <input checked="" type="checkbox"/> ACCEPTANCE		<input type="checkbox"/> INTEGRATION <input type="checkbox"/> SYSTEM		<input type="checkbox"/> LAUNCH OPERATIONS			
	13. ENVIRONMENT WHEN FAILURE WAS OBSERVED		<input type="checkbox"/> AMBIENT <input type="checkbox"/> EMC/RFI		<input type="checkbox"/> RADIATION <input type="checkbox"/> VIBRATION		<input checked="" type="checkbox"/> TEMP 15.0 AXIS FOR _____ MIN TYPE _____		<input type="checkbox"/> THERMAL VAC _____ HRS AT _____ <input type="checkbox"/> OTHER _____			
14. DESCRIPTION OF FAILURE		OUTPUT LOW OF CHANNEL 11 (HYBRID U4) SHORT CIRCUITED (~8 OHMS) TO SIGNAL GROUND.										
15. TEST PROCEDURE		16597		PARA 4.5		18. ORIGINATOR N. C. JAVISON		19. ORG 223		20. DATE 9-25-81		
17. CONTINUATION SHEET USED												
ENGINEERING EVALUATION	18. VERIFICATION AND FAILURE ANALYSIS		SOLDER SPLASH FOUND BETWEEN PIN 28 (O.L.) OF U4 AND THE CASE (SIGNAL GROUND). SOLDER SPLASH WAS REMOVED AND NORMAL BEHAVIOR WAS OBSERVED.									
	19. FAILED ITEM NAME AND PART NUMBER		U4-50859-4									
	20. <input type="checkbox"/> FOLLOWING REWORK/RETEST REQUIRED <input checked="" type="checkbox"/> REWORK/RETEST NOT REQUIRED BECAUSE		NO PARTS FAILED									
	21. AUTHORIZATION											
MANUFACTURING AND TEST	22. REWORK/RETEST ACTION TAKEN		SOLDER SPLASH WAS REMOVED. PART FUNCTIONS PROPERLY. STRESS ANALYSIS HS236-704 SHOWS THAT NO OVERSTRESS OCCURRED.									
	23. LIST ALL PARTS REPLACED		NONE									
	24. CONTINUATION SHEET USED											
ENGINEERING/RELIABILITY	25. REWORK BY		ORG		DATE		26. RETESTED BY		ORG		DATE	
	27. CONTINUATION SHEET USED											
	28. CAUSE AND CORRECTIVE ACTION		SOLDER SPLASH INTRODUCED WHEN MOVING SELECT RESISTORS FROM STANDOFFS TO BOARD. NO OVERSTRESS OCCURRED. MANUFACTURING PERSONNEL HAVE BEEN READVISED TO USE CAUTION WHEN SOLDERING COMPONENTS. Inspection personnel will continue work on this case. Note when inspecting, select and review all adjacent areas.									
	29. FRB CLOSURE		J. B. Bennett									
30. DOCUMENT IMPLEMENTING CORRECTIVE ACTION		NONE REQ'D										
31. CONTINUATION SHEET USED												
32. BASIC CAUSE OF VERIFIED FAILURE		<input type="checkbox"/> DESIGN <input type="checkbox"/> ENVIRONMENTAL <input type="checkbox"/> DEFECTIVE PARTS		<input type="checkbox"/> TEST EQUIPMENT <input type="checkbox"/> TEST PROCEDURE <input type="checkbox"/> TEST SET-UP		<input type="checkbox"/> MFG. PROCEDURE <input type="checkbox"/> ASSY/FAB ERROR <input checked="" type="checkbox"/> WORKMANSHIP		<input type="checkbox"/> WIRING ERROR <input type="checkbox"/> ROUGH HANDLING <input type="checkbox"/> WEAR-OUT		<input checked="" type="checkbox"/> UNKNOWN <input type="checkbox"/> DEFECT CODE		
33. FAILURE TYPE		<input checked="" type="checkbox"/> PRIMARY <input type="checkbox"/> INDUCED		<input type="checkbox"/> UNKNOWN <input checked="" type="checkbox"/> NO FAILURE		34. FAILURE CLASSIFICATION		<input type="checkbox"/> CRITICAL <input checked="" type="checkbox"/> MAJOR		<input checked="" type="checkbox"/> MINOR <input type="checkbox"/> SAFETY		
35. RESPONSIBLE ENGINEER		J. B. Bennett		2/22		DATE 11-3-81		36. SPACECRAFT SYSTEM ENGINEER		DATE 11/10/81		
37. RELIABILITY		J. Huber		51-11		DATE 11-02-81		38. CUSTOMER OR SUPPLIER		DATE		

4-781

HUGHES

HUGHES AIRCRAFT COMPANY
SPACE AND COMMUNICATIONS GROUP
EL SEGUNDO, CALIFORNIA

PER P.N. 50797 UPER -
SUPP. 2
SPACE AND COMMUNICATIONS GROUP
FAILURE REPORT

ORIGINAL PAGE IS
OF POOR QUALITY
S 8321

ORIGINATOR	1. PROGRAM NAME AND NUMBER T.M. VO11		2. CLA.		3. MODEL FLIGHT		4. TIME OBSERVED 3:15		5. DATE OBSERVED MO 10 DA 4 YR 81		
	6. HARDWARE LEVEL WHEN FAILURE WAS OBSERVED		<input type="checkbox"/> SPACECRAFT <input type="checkbox"/> SYSTEM		<input type="checkbox"/> SUBSYSTEM <input type="checkbox"/> UNIT		<input checked="" type="checkbox"/> ASSEMBLY <input type="checkbox"/> SUBASSEMBLY		<input type="checkbox"/> MODULE <input type="checkbox"/> MECAM		
	7. SUBSYSTEM		NAME		PART NUMBER		S/N		MANUFACTURER		
	8. UNIT										
	9. <input checked="" type="checkbox"/> ASSEMBLY <input type="checkbox"/> SUBASSEMBLY		RAID 4 POST AMP BOARD		50904-4		201		SERC		
	10. <input type="checkbox"/> MODULE <input type="checkbox"/> MECAM <input type="checkbox"/> CARD										
	11. OTHER										
	12. TEST WHEN FAILURE WAS OBSERVED		<input type="checkbox"/> DEVELOPMENT <input type="checkbox"/> IN-PROCESS		<input type="checkbox"/> QUALIFICATION <input checked="" type="checkbox"/> ACCEPTANCE		<input type="checkbox"/> INTEGRATION <input type="checkbox"/> SYSTEM		<input type="checkbox"/> LAUNCH OPERATIONS		
	13. ENVIRONMENT WHEN FAILURE WAS OBSERVED		<input type="checkbox"/> AMOUNT <input type="checkbox"/> SEC/HR		<input type="checkbox"/> RADIATION <input type="checkbox"/> VIBRATION		<input checked="" type="checkbox"/> TEMP. 15.0 AUX FOR		<input type="checkbox"/> THERMAL VAC MRS AT		
	14. DESCRIPTION OF FAILURE		AT 52 KHZ FREQUENCY RESPONSE WAS: -2.24 dB (SHOULD BE -2.50 TO -3.01.) CH. 6 ONLY.								
ENGINEERING EVALUATION	15. TEST PROCEDURE 16597		16. PARA 4.6		18. OPERATOR A. L. DANISON		19. ORG 2243		20. DATE 10-5-81		
	17. CONTINUATION SHEET USED										
	19. VERIFICATION AND FAILURE ANALYSIS										
	20. <input type="checkbox"/> FOLLOWING REWORK/RETEST REQUIRED <input checked="" type="checkbox"/> REWORK/RETEST NOT REQUIRED BECAUSE		Since the midband noise at 2.1 MHz is well within the spec of ± 2.4 dB, it is not considered a defect which affects the receiver. No over-stress of any component.								
	21. AUTHORIZATION		W. H. ...		22. DATE 11/16/81		23. CONTINUATION SHEET USED				
	23. REWORK/RETEST ACTION TAKEN										
	24. QA REWORK										
	25. QA RETEST										
	26. LIST ALL PARTS REPLACED		CMT SYM		PART LOT NUMBER		DATE CODE		MANUFACTURER		
	27. REWORK BY		ORG		DATE		28. RETESTED BY		ORG		
29. CAUSE AND CORRECTIVE ACTION		Workmanship during selection of board and rollout visitors. Pushed to operators. Waiver 10-120 attached.									
30. DOCUMENT IMPLEMENTING CORRECTIVE ACTION		EFFECTIVE - SN 201 FLIGHT UNIT WAIVER - 120 (COPY ATTACHED)									
31. CONTINUATION SHEET USED											
32. BASIC CAUSE OF VERIFIED FAILURE		<input type="checkbox"/> DESIGN <input type="checkbox"/> ENVIRONMENTAL <input type="checkbox"/> DEFECTIVE PARTS		<input type="checkbox"/> TEST EQUIPMENT <input type="checkbox"/> TEST PROCEDURE <input type="checkbox"/> TEST SET-UP		<input type="checkbox"/> MFG. PROCEDURE <input type="checkbox"/> ASSY/FAB ERROR <input checked="" type="checkbox"/> WORKMANSHIP		<input type="checkbox"/> WIRING ERROR <input type="checkbox"/> ROUGH HANDLING <input type="checkbox"/> WEAR-OUT			
33. FAILURE TYPE		<input type="checkbox"/> PRIMARY <input checked="" type="checkbox"/> INDUCED		<input type="checkbox"/> UNKNOWN <input type="checkbox"/> NO FAILURE		34. FAILURE CLASSIFICATION		<input type="checkbox"/> CRITICAL <input type="checkbox"/> MAJOR <input checked="" type="checkbox"/> MINOR <input type="checkbox"/> SAFETY			
35. RESPONSIBLE ENGINEER		ORG		DATE		36. SP/ACCEPT SYSTEM ENGINEER		ORG			
37. RELIABILITY		ORG		DATE		38. CUSTOMER OR SUPPLIER		DATE			

Program Instruction 010

ORIGINAL PAGE IS OF POOR QUALITY 58321

REQUEST FOR DEVIATION/WAIVER (SEE MIL-STD-640 OR 481 FOR INSTRUCTIONS)

DATE PREPARED

PROCURING ACTIVITY NO.

1. ORIGINATOR NAME AND ADDRESS: David M. Randall
SBRC, 75 Coronar Dr., Coleta, Ca. 93117

2. DEVIATION WAIVER

3. MINOR MAJOR CRITICAL

4. DESIGNATION FOR DEVIATION/WAIVER

6. MODEL/TYPE F	8. WFR. CODE 11323	7. SYS. DESIG. TM	4. DEV/WHY NO. W-120	5. BASE LINE AFFECTED <input checked="" type="checkbox"/> PLAC- TYPICAL <input type="checkbox"/> ELLO- CATED <input type="checkbox"/> PROD- UCT	6. OTHER SYSTEMS/CONFIG- RATION ITEMS AFFECTED <input type="checkbox"/> YES <input checked="" type="checkbox"/> NO
--------------------	-----------------------	----------------------	-------------------------	---	--

7. SPECIFICATIONS AFFECTED-TEST PLAN

	WFR. CODE	SPEC./DOC. NO.	SCH	WFR. CODE	NUMBER	DEV.	NO. NO.
8. SYSTEM							
9. ITEM				11323	50904-4	G	-
10. TEST PLAN							

9. TITLE OF DEVIATION/WAIVER: Permission to use Band 4 Postamp SN 201

10. CONTRACT NO. & LINE ITEM: NAS 5-24200

11. CONFIGURATION ITEM NOMENCLATURE: Radiometer

12. CD NO.: II

13. DEFECT NO.: 1

14. DEFECT CLASSIFICATION: MINOR MAJOR CRITICAL

15. NAME OF PART OR LARGEST ASSEMBLY AFFECTED: Band 4 Postamplifier

16. PART NO. OR TYPE DESIG.: 50904-4

17. LOT NO.: 201

18. QTY: 1

19. REQUIRES DEVIATION/WAIVER: YES NO

20. EFFECT ON COST/PRICE: None if approved.

21. EFFECT ON DELIVERY SCHEDULE: None if approved.

22. EFFECT ON INTEGRATED LOGISTIC SUPPORT, INTERFACE, ETC.: None

23. DESCRIPTION OF DEVIATION/WAIVER

Permission to use Band 4 Postamp with Ch 6 frequency response -2.24 dB down vs a specification of -2.5 to -3.0 dB down at 52KHZ.

24. REAS FOR DEVIATION/WAIVER

This parameter is in violation of a unit level specification; not a system specification. Rework to the Postamp PWB may result in a lifted pad. The Band 4 Band Level Assy has been bonded into LED bracket and can no longer be cooled to allow reselection of resistors. Rework is not considered necessary since Wide Band Noise of Channel 6 is 2.1pA.

REA

SYS ENGR

RE

QA

PE

25. PRODUCTION EFFECTIVITY BY SERIAL NUMBER

26. APPROVAL OF SIGNATURE: *George B. Hart*

27. TITLE: Minor - System Engineering
Major/Critical - Program Manager

28. APPROVAL, DISAPPROVAL

29. APPROVAL RECOMMENDED APPROVED DISAPPROVED

30. SIGNATURE: *George B. Hart* DATE: *11/30/81*

DD. FORM 1694

2-11000

HUGHES

MAIN AHR 50904-43
 OPN. 1300
 SPACE AND COMMUNICATIONS GROUP

ORIGINAL PAGE IS
 OF POOR QUALITY

HUGHES AIRCRAFT COMPANY
 SPACE AND COMMUNICATIONS GROUP
 EL SEGUNDO, CALIFORNIA

FAILURE REPORT

S 8325

1. PROGRAM NAME AND NUMBER V011 TM		2. GLA	3. MODEL FLIGHT FIRST SHFT	4. TIME OBSERVED	5. DATE OBSERVED MO 08 DA 25 YR 81	
6. HARDWARE LEVEL WHEN FAILURE WAS OBSERVED <input type="checkbox"/> SPACECRAFT <input type="checkbox"/> SYSTEM		<input type="checkbox"/> SUBSYSTEM <input type="checkbox"/> UNIT	<input checked="" type="checkbox"/> ASSEMBLY <input type="checkbox"/> SUBASSEMBLY	<input type="checkbox"/> MODULE <input type="checkbox"/> MICAM	<input type="checkbox"/> CARD <input type="checkbox"/> PART	
EQUIPMENT IDENTIFICATION:						
7. SUBSYSTEM		NAME	PART NUMBER	S/N	MANUFACTURER	
8. UNIT Electronics Module						
9. <input checked="" type="checkbox"/> ASSEMBLY <input type="checkbox"/> SUBASSEMBLY		RANB 3 Post-Ann 50904-43		201	SBRL	
10. <input type="checkbox"/> MODULE <input type="checkbox"/> MICAM <input type="checkbox"/> CARD						
11. OTHER						
12. TEST WHEN FAILURE WAS OBSERVED <input type="checkbox"/> DEVELOPMENT <input type="checkbox"/> IN-PROCESS		<input type="checkbox"/> QUALIFICATION <input type="checkbox"/> ACCEPTANCE	<input type="checkbox"/> INTEGRATION <input type="checkbox"/> SYSTEM	<input type="checkbox"/> LAUNCH OPERATIONS		
13. ENVIRONMENT WHEN FAILURE WAS OBSERVED <input type="checkbox"/> AMBIENT <input type="checkbox"/> EMC/RF		<input type="checkbox"/> RADIATION <input type="checkbox"/> VIBRATION	<input checked="" type="checkbox"/> TESTS AXIS FOR 15-C	<input type="checkbox"/> THERMAL VAC	HRS AT	
14. DESCRIPTION OF FAILURE Ch. 1, 7, 8, 13, 15 D.C. OFFSET OUT OF SPEC SHOULD ± 1.0V IS Ch. 1 - 1.1V, Ch. 7 - 1.2V, Ch. 8 + 1.2V, Ch 13 - 1.5V Ch 15 - 1.3V						
15. TEST PROCEDURE 16597		PARA 4.4	16. ORIGINATOR C.R. Lane	17. ORG 243	DATE 08-25-81	
18. VERIFICATION AND FAILURE ANALYSIS Channels 1, 7, 8, 13, 15 apparently out of spec due to post-gain resistors being out during testing						
19. FAILED ITEM NAME AND PART NUMBER N/A						
20. <input type="checkbox"/> FOLLOWING REWORK/RETEST REQUIRED <input checked="" type="checkbox"/> REWORK/RETEST NOT REQUIRED BECAUSE Channels 1, 7, 8, 13, 15 actually meet spec as tested with post-gain resistors out. Refer to E.C.R. # TN2512/01R1 of spec 16597 Rev J for allowable D.C. voltage offsets. (See attached for voltage offset calculations.)						
21. AUTHORIZATION						
22. REWORK/RETEST ACTION TAKEN None Required. No over-stressing of components occurred.						
23. LIST ALL PARTS REPLACED		CKT SYM	PART LOT NUMBER	DATE CODE	MANUFACTURER	
None						
24. REWORK BY		ORG	DATE	25. RETESTED BY	ORG	
26. CAUSE AND CORRECTIVE ACTION Spec changed per E.C.R. # 2512/01R1 to define role of post-gain resistors in D.C. offset voltage measurements. N/A spec limits are based on calculations that take gain into consideration.						
27. NOTE: REV. J OF SPEC. 16597 INCORPORATES E.C.R. # 2512/01R1. EFFECTIVE 15 APR 81 & UP. E.C.R. # TN2512/01R1 to spec 16597						
28. DOCUMENT IMPLEMENTING CORRECTIVE ACTION						
29. BASIC CAUSE OF VERIFIED FAILURE <input type="checkbox"/> DESIGN ENVIRONMENTAL DEFECTIVE PARTS <input type="checkbox"/> PRIMARY INDUCED		<input type="checkbox"/> TEST EQUIPMENT <input type="checkbox"/> TEST PROCEDURE <input type="checkbox"/> TEST SET-UP	<input type="checkbox"/> MFG. PROCEDURE <input type="checkbox"/> ASSY/FAB ERROR <input type="checkbox"/> WORKMANSHIP	<input type="checkbox"/> WIRING ERROR <input type="checkbox"/> ROUGH HANDLING <input type="checkbox"/> WEAR-OUT	<input type="checkbox"/> UNKNOWN DEFECT CODE	
30. FAILURE TYPE <input type="checkbox"/> UNKNOWN <input checked="" type="checkbox"/> NO FAILURE		31. FAILURE CLASSIFICATION <input type="checkbox"/> CRITICAL <input checked="" type="checkbox"/> MAJOR		<input checked="" type="checkbox"/> MINOR <input type="checkbox"/> SAFETY		
32. RESPONSIBLE ENGINEER C.R. Lane		ORG 243	DATE 11/13/81	33. SPACECRAFT SYSTEM ENGINEER C.R. Lane		
34. RELIABILITY C.R. Lane		ORG 51-41	DATE 11/13/81	35. CUSTOMER OR SUPPLIER 11/19/81		

HUGHES

ORIGINAL PAGE IS OF POOR QUALITY

SPACE AND COMMUNICATIONS GROUP FAILURE REPORT

S 8326

HUGHES AIRCRAFT COMPANY SPACE AND COMMUNICATIONS GROUP EL SEGUNDO, CALIFORNIA

1. PROGRAM NAME AND NUMBER <i>VO11 TM</i>		2. GLA	3. MODEL <i>FLIGHT</i>	4. TIME OBSERVED <i>FIRST FLIGHT</i>	5. DATE OBSERVED <i>MO 10 DA 04 YR 81</i>
6. HARDWARE LEVEL WHEN FAILURE WAS OBSERVED <input type="checkbox"/> SPACECRAFT <input type="checkbox"/> SYSTEM		<input type="checkbox"/> SUBSYSTEM <input type="checkbox"/> UNIT	<input checked="" type="checkbox"/> ASSEMBLY <input type="checkbox"/> SUBASSEMBLY	<input type="checkbox"/> MODULE <input type="checkbox"/> MICAM	<input type="checkbox"/> CARD <input type="checkbox"/> PART
EQUIPMENT IDENTIFICATION:					
7. SUBSYSTEM		NAME		PART NUMBER	S/N
8. UNIT <i>Electronics Module</i>					
9. <input checked="" type="checkbox"/> ASSEMBLY <input type="checkbox"/> SUBASSEMBLY		<i>BAND 4 Post Amp</i>		<i>50904-34 201</i>	<i>SBRC</i>
10. <input type="checkbox"/> MODULE <input type="checkbox"/> MICAM <input type="checkbox"/> CARD					
11. OTHER					
12. TEST WHEN FAILURE WAS OBSERVED <input type="checkbox"/> DEVELOPMENT <input type="checkbox"/> IN-PROCESS		<input type="checkbox"/> QUALIFICATION <input checked="" type="checkbox"/> ACCEPTANCE	<input type="checkbox"/> INTEGRATION <input type="checkbox"/> SYSTEM	<input type="checkbox"/> LAUNCH OPERATIONS	
13. ENVIRONMENT WHEN FAILURE WAS OBSERVED <input type="checkbox"/> AMBIENT <input type="checkbox"/> EMC/RFI		<input type="checkbox"/> RADIATION <input type="checkbox"/> VIBRATION	<input checked="" type="checkbox"/> TEMP <i>15°C</i>	<input type="checkbox"/> THERMAL VAC	HRS AT _____ <input type="checkbox"/> OTHER
14. DESCRIPTION OF FAILURE <i>Ch. 6 & 8 OUT OF SPEC OFFSET VOLTAGE SHOULD BE ± 1.0V. IS Ch 6 +1.3V, Ch. 8 +1.5V</i>					
15. TEST PROCEDURE <i>16597</i>		PARA <i>4.4</i>	16. ORIGINATOR <i>C. R. Lee</i>	ORG <i>2213</i>	DATE <i>10-04-81</i>
17. VERIFICATION AND FAILURE ANALYSIS <i>Channels 6, 8 apparently out of spec due to post-gain resistors being out during test.</i>		18. FAILED ITEM NAME AND PART NUMBER <i>N/A</i>		17. CONTINUATION SHEET USED <input type="checkbox"/>	
20. <input type="checkbox"/> FOLLOWING REWORK/RETEST REQUIRED <input checked="" type="checkbox"/> REWORK/RETEST NOT REQUIRED BECAUSE <i>Channels 6, 8 actually meet spec as tested with post-gain resistors out. Refer to ECR# TM2512/01R1 of spec 16597 Rev J for allowable voltage offsets. (See attached for allowable voltage offset calculations.)</i>		21. AUTHORIZATION		ORG	DATE
21. REWORK/RETEST ACTION TAKEN <i>None Required. No over-stressing of components occurred.</i>		22. CONTINUATION SHEET USED <input type="checkbox"/>		24. QA REWORK	
23. LIST ALL PARTS REPLACED		CKT SYM	PART LOT NUMBER	DATE CODE	MANUFACTURER
<i>None</i>					
27. REWORK BY		ORG	DATE	28. RETESTED BY	ORG
30. CAUSE AND CORRECTIVE ACTION <i>Spec changed per E.C.R. #2512/01R1 to define role of post-gain resistors in D.C. offset voltage measurements. New spec limits are based on calculations that put them into consideration.</i>		31. CONTINUATION SHEET USED <input type="checkbox"/>		32. CONTINUATION SHEET USED <input type="checkbox"/>	
33. DOCUMENT IMPLEMENTING CORRECTIVE ACTION <i>ECR# TM 2512/01R1 EFFECTIVE 15 SEP 81 SUP ECR# TM 2512/01R1 to spec 16597</i>		34. BASIC CAUSE OF VERIFIED FAILURE <input type="checkbox"/> DESIGN <input type="checkbox"/> ENVIRONMENTAL <input type="checkbox"/> DEFECTIVE PARTS		<input type="checkbox"/> TEST EQUIPMENT <input type="checkbox"/> TEST PROCEDURE <input type="checkbox"/> TEST SET-UP	<input type="checkbox"/> MFG. PROCEDURE <input type="checkbox"/> ASSY/PAB ERROR <input type="checkbox"/> WORKMANSHIP
35. FAILURE TYPE <input type="checkbox"/> PRIMARY <input type="checkbox"/> INDUCED		<input type="checkbox"/> UNKNOWN <input checked="" type="checkbox"/> NO FAILURE	36. FAILURE CLASSIFICATION <input type="checkbox"/> CRITICAL <input type="checkbox"/> MAJOR <input checked="" type="checkbox"/> MINOR <input type="checkbox"/> SAFETY		DEFECT CODE
37. RESPONSIBLE ENGINEER <i>[Signature]</i>		ORG <i>2213</i>	DATE <i>11/4/81</i>	38. SPACECRAFT SYSTEM ENGINEER <i>[Signature]</i>	
39. RESPONSIBILITY <i>[Signature]</i>		ORG <i>5174</i>	DATE <i>11/13/81</i>	40. CUSTOMER OR SUPPLIER <i>[Signature]</i>	

HUGHES

HUGHES AIRCRAFT COMPANY
SPACE AND COMMUNICATIONS GROUP
EL SEGUNDO, CALIFORNIA

SPACE AND COMMUNICATIONS GROUP
FAILURE REPORT

ORIGINAL PAGE IS
OF POOR QUALITY

S 8327

1. PROGRAM NAME AND NUMBER V011 TM		2. GLA		3. MODEL FLIGHT		4. TIME OBSERVED FIRST SHOT		5. DATE OBSERVED MO 09 DA 26 YR 81	
6. HARDWARE LEVEL WHEN FAILURE WAS OBSERVED <input type="checkbox"/> SPACECRAFT <input type="checkbox"/> SYSTEM		<input type="checkbox"/> SUBSYSTEM <input type="checkbox"/> UNIT		<input checked="" type="checkbox"/> ASSEMBLY <input type="checkbox"/> SUBASSEMBLY		<input type="checkbox"/> MODULE <input type="checkbox"/> MICAM		<input type="checkbox"/> CARD <input type="checkbox"/> PART	
EQUIPMENT IDENTIFICATION:									
7. SUBSYSTEM		NAME		PART NUMBER		S/N		MANUFACTURER	
8. UNIT Electronics Module									
9. <input checked="" type="checkbox"/> ASSEMBLY <input type="checkbox"/> SUBASSEMBLY Post AMP BAND 4									
10. <input type="checkbox"/> MODULE <input type="checkbox"/> MICAM <input type="checkbox"/> CARD				50904-34		201		SBRL	
11. OTHER									
12. TEST WHEN FAILURE WAS OBSERVED <input type="checkbox"/> DEVELOPMENT <input type="checkbox"/> QUALIFICATION <input type="checkbox"/> INTEGRATION <input type="checkbox"/> LAUNCH OPERATIONS <input type="checkbox"/> IN-PROCESS <input checked="" type="checkbox"/> ACCEPTANCE <input type="checkbox"/> SYSTEM									
13. ENVIRONMENT WHEN FAILURE WAS OBSERVED <input type="checkbox"/> AMBIENT <input type="checkbox"/> RADIATION <input checked="" type="checkbox"/> TEMP 15 °C <input type="checkbox"/> THERMAL VAC _____ HRS AT _____ <input type="checkbox"/> EMC/RF <input type="checkbox"/> VIBRATION _____ AXIS FOR _____ MIN TYPE _____ <input type="checkbox"/> OTHER _____									
14. DESCRIPTION OF FAILURE CH. 5, 8, 12, 13 OUT OF SPEC OFFSET VOLTAGE SPANED Be ± 1.0V IS CH. 5 +1.5V, CH. 8 +2.5V, CH. 12 +1.5V, CH. 13 +1.3V.									
15. TEST PROCEDURE 16 597		PARA 4.4		16. ORIGINATOR C.R. Lee		ORG 223		DATE 09-26-81	
17. CONTINUATION SHEET USED <input type="checkbox"/>									
18. VERIFICATION AND FAILURE ANALYSIS Channels 5, 8, 12, 13 apparently out of spec due to post-gain resistors being lifted during testing.									
19. FAILED ITEM NAME AND PART NUMBER N/A									
20. <input type="checkbox"/> FOLLOWING REWORK/RETEST REQUIRED <input checked="" type="checkbox"/> REWORK/RETEST NOT REQUIRED BECAUSE Channels 5, 8, 12, 13 actually meet spec as tested with post gain resistors out. Refer to E.C.R. TM 2512/01R1 of spec 16597 Rev J for allowable voltage offsets. (See attached for allowable voltage offsets calculations.)									
21. AUTHORIZATION		ORG		DATE		22. CONTINUATION SHEET USED		23. QA Rework	
24. QA RETEST									
25. Rework/Retest Action Taken None Required. No over-stressing of components occurred.									
26. LIST ALL PARTS REPLACED									
PART NUMBER		CKT SYM		PART LOT NUMBER		DATE CODE		MANUFACTURER	
PROBABLE DEFECT		ANALYSIS NUMBER		None					
27. Rework by		ORG		DATE		28. Retested by		ORG	
29. CONTINUATION SHEET USED		30. CAUSE AND CORRECTIVE ACTION Spec changed per ECR #2512/01R1 to define role of post-gain resistors in D.C. offset voltage measurements. New spec limits are based on calculations that take gain into consideration. Approved 11/19/81		31. FRB CLOSURE		32. CONTINUATION SHEET USED <input type="checkbox"/>			
33. DOCUMENT IMPLEMENTING CORRECTIVE ACTION ECR # TM 2512/01R1 to spec 16597									
34. BASIC CAUSE OF VERIFIED FAILURE		<input type="checkbox"/> DESIGN <input type="checkbox"/> ENVIRONMENTAL <input type="checkbox"/> DEFECTIVE PARTS		<input checked="" type="checkbox"/> TEST EQUIPMENT <input type="checkbox"/> TEST PROCEDURE <input type="checkbox"/> TEST SET-UP		<input type="checkbox"/> MFG. PROCEDURE <input type="checkbox"/> ASSY/FAB ERROR <input type="checkbox"/> WORKMANSHIP		<input type="checkbox"/> WIRING ERROR <input type="checkbox"/> ROUGH HANDLING <input type="checkbox"/> WEAR-OUT	
35. FAILURE TYPE		<input type="checkbox"/> PRIMARY <input type="checkbox"/> INDUCED		<input type="checkbox"/> UNKNOWN <input checked="" type="checkbox"/> NO FAILURE		36. FAILURE CLASSIFICATION		<input type="checkbox"/> CRITICAL <input checked="" type="checkbox"/> MAJOR <input type="checkbox"/> MINOR <input type="checkbox"/> SAFETY	
37. RESPONSIBLE ENGINEER J. J. Lee		ORG 223		DATE 11-11-81		38. SPACECRAFT SYSTEM ENGINEER J. J. Lee		ORG 22-61	
39. RELIABILITY		ORG 51-41		DATE 4/13/81		40. CUSTOMER OR SUPPLIER HR		DATE 11/9/81	

HUGHES

SPACE AND COMMUNICATIONS GROUP
FAILURE REPORT

ORIGINAL PAGE IS
OF POOR QUALITY

HUGHES AIRCRAFT COMPANY
SPACE AND COMMUNICATIONS GROUP
21 SEGUNDO, CALIFORNIA

S 8329

1. PROGRAM NAME AND NUMBER <i>1/011 TM</i>		2. GLA		3. MODEL <i>FLIGHT FIRST SWFT</i>		4. TIME OBSERVED		5. DATE OBSERVED <i>MO 10 DA 01 YR 81</i>			
6. HARDWARE LEVEL WHEN FAILURE WAS OBSERVED <input type="checkbox"/> SPACECRAFT <input type="checkbox"/> SUBSYSTEM <input checked="" type="checkbox"/> ASSEMBLY <input type="checkbox"/> MODULE <input type="checkbox"/> CARD <input type="checkbox"/> SYSTEM <input type="checkbox"/> UNIT <input type="checkbox"/> SUBASSEMBLY <input type="checkbox"/> MICAM <input type="checkbox"/> PART		7. SUBSYSTEM		8. UNIT <i>Electronics Module</i>		9. ASSEMBLY <input checked="" type="checkbox"/> SUBASSEMBLY <i>BAND 2</i>		10. MODULE <input type="checkbox"/> MICAM <input type="checkbox"/> CARD			
EQUIPMENT IDENTIFICATION:		NAME		PART NUMBER		S/N		MANUFACTURER			
11. OTHER				<i>50904-2</i>		<i>201</i>		<i>SBRC</i>			
12. TEST WHEN FAILURE WAS OBSERVED <input type="checkbox"/> DEVELOPMENT <input type="checkbox"/> QUALIFICATION <input type="checkbox"/> INTEGRATION <input type="checkbox"/> LAUNCH OPERATIONS <input type="checkbox"/> IN-PROCESS <input type="checkbox"/> ACCEPTANCE <input type="checkbox"/> SYSTEM		13. ENVIRONMENT WHEN FAILURE WAS OBSERVED <input type="checkbox"/> AMBIENT <input type="checkbox"/> RADIATION <input checked="" type="checkbox"/> TEMP <i>15 .C</i> <input type="checkbox"/> THERMAL VAC _____ HRS AT _____ <input type="checkbox"/> EMC/RR <input type="checkbox"/> VIBRATION _____ AXIS FOR _____ MIN TYPE _____ <input type="checkbox"/> OTHER		14. DESCRIPTION OF FAILURE <i>Ch. 3 17, 8 OUT OF SPEC ON OFFSET VOLTAGE SHOULD BE $\pm 1.0V$ IS Ch. 1 -1.5V, Ch. 7 +1.5V, Ch. 8 -1.5V</i>		15. TEST PROCEDURE <i>16597</i>		16. ORIGINATOR <i>C. R. Lane</i>		17. CONTINUATION SHEET USED <input type="checkbox"/>	
18. VERIFICATION AND FAILURE ANALYSIS <i>Channels 1, 7, 8 apparently out of spec due to the fact that post-gain resistors were out during 16597, Para 4.4 testing.</i>		19. FAILED ITEM NAME AND PART NUMBER <i>N/A</i>		20. FOLLOWING REWORK/RETEST REQUIRED <input checked="" type="checkbox"/> REWORK/RETEST NOT REQUIRED BECAUSE <i>Channels 1, 7, 8 actually meet spec as tested with post-gain resistors out. Refer to E.C.R. # 2512/01R1 of spec 16597 Rev J for allowable D.C. voltage offsets. (See attached for voltage offset calculations.)</i>		21. AUTHORIZATION ORG _____ DATE _____		22. CONTINUATION SHEET USED <input type="checkbox"/>			
23. REWORK/RETEST ACTION TAKEN <i>None Required. No over-stressing of components occurred.</i>		24. QA REWORK		25. QA RETEST		26. LIST ALL PARTS REPLACED PART NUMBER CKT SYM PART LOT NUMBER DATE CODE MANUFACTURER PROBABLE DEFECT ANALYSIS NUMBER <i>None</i>		27. REWORK BY ORG _____ DATE _____			
28. CAUSE AND CORRECTIVE ACTION <i>Spec changed per E.C.R. # 2512/01R1 to define role of post-gain resistors in D.C. offset voltage measurements. New spec limits are based on calculations that take gain into consideration. Approved 11/3/81</i>		29. RETESTED BY ORG _____ DATE _____		30. CONTINUED BY ORG _____ DATE _____		31. CONTINUATION SHEET USED <input type="checkbox"/>		32. CONTINUATION SHEET USED <input type="checkbox"/>			
33. DOCUMENT IMPLEMENTING CORRECTIVE ACTION <i>ECR # TM 2512/01R1 to spec 16597</i>		34. BASIC CAUSE OF VERIFIED FAILURE <input type="checkbox"/> DESIGN ENVIRONMENTAL DEFECTIVE PARTS <input type="checkbox"/> TEST EQUIPMENT TEST PROCEDURE TEST SET-UP <input type="checkbox"/> MFG. PROCEDURE ASSY/FAB ERROR WORKMANSHIP <input type="checkbox"/> WIRING ERROR ROUGH HANDLING WEAR-OUT <input type="checkbox"/> UNKNOWN DEFECT CODE		35. FAILURE TYPE <input type="checkbox"/> PRIMARY INDUCED <input type="checkbox"/> UNKNOWN NO FAILURE		36. FAILURE CLASSIFICATION <input type="checkbox"/> CRITICAL SAFETY <input type="checkbox"/> MAJOR		37. RESPONSIBLE ENGINEER <i>11/3/81</i>		38. SPACECRAFT SYSTEM ENGINEER ORG _____ DATE <i>22-64 5/11/81</i>	
39. RESPONSIBILITY <i>Customer</i>		40. CUSTOMER OR SUPPLIER <i>51-41 11/18/81</i>		41. DATE <i>11/18/81</i>		42. DATE <i>11/18/81</i>		43. DATE <i>11/18/81</i>			

HUGHES

SPACE AND COMMUNICATIONS GROUP
FAILURE REPORT

ORIGINAL PAGE IS
OF POOR QUALITY

S 8343

HUGHES AIRCRAFT COMPANY
SPACE AND COMMUNICATIONS GROUP
EL SEGUNDO, CALIFORNIA

1. PROGRAM NAME AND NUMBER THEMATIC MODEL		2. GLA	3. MODEL PLT	4. TIME OBSERVED	5. DATE OBSERVED MO 2 DA 16 YR 82
6. HARDWARE LEVEL WHEN FAILURE WAS OBSERVED <input type="checkbox"/> SPACECRAFT <input type="checkbox"/> SYSTEM		<input type="checkbox"/> SUBSYSTEM <input checked="" type="checkbox"/> UNIT	<input type="checkbox"/> ASSEMBLY <input type="checkbox"/> SUBASSEMBLY	<input type="checkbox"/> MODULE <input type="checkbox"/> MICAM	<input type="checkbox"/> CARD <input type="checkbox"/> PART
EQUIPMENT IDENTIFICATION: NAME PART NUMBER S/N MANUFACTURER					
7. SUBSYSTEM					
8. UNIT ELECTRICAL MODULE					
9. <input type="checkbox"/> ASSEMBLY <input type="checkbox"/> SUBASSEMBLY					
10. <input type="checkbox"/> MODULE <input type="checkbox"/> MICAM <input type="checkbox"/> CARD					
11. OTHER					
12. TEST WHEN FAILURE WAS OBSERVED <input type="checkbox"/> DEVELOPMENT <input type="checkbox"/> IN-PROCESS <input type="checkbox"/> QUALIFICATION <input type="checkbox"/> ACCEPTANCE <input type="checkbox"/> INTEGRATION <input type="checkbox"/> SYSTEM <input type="checkbox"/> LAUNCH OPERATIONS					
13. ENVIRONMENT WHEN FAILURE WAS OBSERVED <input checked="" type="checkbox"/> AMBIENT <input type="checkbox"/> RADIATION <input type="checkbox"/> TEMP. _____ °C <input type="checkbox"/> THERMAL VAC. _____ HRS AT _____ <input type="checkbox"/> EMC/RF <input type="checkbox"/> VIBRATION _____ AXIS FOR _____ MIN TYPE _____ <input type="checkbox"/> OTHER					
14. DESCRIPTION OF FAILURE SMA VOLTAGES OUT OF SPEC, 2/3 W/3 ±27.5, 7 W/3 6.2 SEE ATTACHED DATA SHEET (OPER 1800) CDVU and RADIOMETER TOLERANCES REVERSED ON HI/LO LINE SPECS - BOTH READINGS OUT OF SPEC					
15. TEST PROCEDURE 16704 PARA 4.23.9.26 BUXTON DATE 22-13 CONTINUATION SHEET USED <input type="checkbox"/>					
16. VERIFICATION AND FAILURE ANALYSIS TO 16704 PER 4.23.9.26 SETS LOW LINE POWER SUPPLY INPUT TO 21(+.5, -0)VDC. SHOULD HAVE BEEN TESTED AT 23(+.5 -0)VDC. CDVU and Radiometer Voltage tolerances should have been reversed.					
17. FOLLOWING REWORK/RETEST REQUIRED <input type="checkbox"/> REWORK/RETEST NOT REQUIRED BECAUSE					
RETEST PER PARA 4.23.9.26 EO 4180A					
21. AUTHORIZATION J.A. Bonach ORG 22-13 DATE 3-5-82					
22. REWORK/RETEST ACTION TAKEN PARA 4.23.9.26 PERFORMED SMA +28V READ 30.8VDC SMA -28V READ -30.7VDC BOTH WITHIN SPEC EO 4180A IMPLEMENTED SEE ATTACHED COPY OF TEST DATA SHEET (OPER 1850) EO 4199A CORRECTED NOMENCLATURE AND TOLERANCES - ALL READINGS ARE WITHIN SPEC					
23. LIST ALL PARTS REPLACED					
PART NUMBER	CXT SYM	PART LOT NUMBER	DATE CODE	MANUFACTURER	POSSIBLE DEFECT
27. REWORK BY J.A. Bonach ORG 22-13 DATE 3/5/82					
28. CAUSE AND CORRECTIVE ACTION CAUSE: ELECTRONIC MODULE UNIT TEST PROCEDURE CALLED OUT IMPROPER VOLTAGE SETTINGS PLUS THE CDVU AND RADIOMETER TOLERANCES WERE REVERSED. C/A: EO 4180A AND 4199A CORRECT THE ELECTRONIC MODULE TEST PROCEDURE.					
31. CONTINUATION SHEET USED <input type="checkbox"/>					
32. DOCUMENT IMPLEMENTING CORRECTIVE ACTION EO 4180A EO 4199A - EFFECTIVITY 1/10/83					
34. BASIC CAUSE OF VERIFIED FAILURE <input type="checkbox"/> DESIGN ENVIRONMENTAL DEFECTIVE PARTS <input type="checkbox"/> TEST EQUIPMENT <input type="checkbox"/> TEST PROCEDURE <input type="checkbox"/> TEST SET-UP <input type="checkbox"/> MFG. PROCEDURE <input type="checkbox"/> ASSY/FAB ERROR <input type="checkbox"/> WORKMANSHIP <input type="checkbox"/> WIRING ERROR <input type="checkbox"/> ROUGH HANDLING <input type="checkbox"/> WEAR-OUT <input type="checkbox"/> UNKNOWN					
35. FAILURE TYPE <input type="checkbox"/> PRIMARY <input type="checkbox"/> INDUCED <input type="checkbox"/> UNKNOWN <input checked="" type="checkbox"/> NO FAILURE					
36. FAILURE CLASSIFICATION <input type="checkbox"/> CRITICAL <input type="checkbox"/> MAJOR <input checked="" type="checkbox"/> MINOR <input type="checkbox"/> SAFETY					
37. RESPONSIBLE ENGINEER J.A. Bonach ORG 22-13 DATE 3-9-82					
38. SPACECRAFT SYSTEM ENGINEER J.H. Conrad ORG 22-41 DATE 3/10/82					
39. RELIABILITY ENGINEER J.A. Bonach ORG 51-41 DATE 3-10-82					
40. CUSTOMER OR SUPPLIER J.A. Bonach ORG 51-41 DATE 3/10/82					

HUGHES

ORIGINAL PAGE IS OF POOR QUALITY

HUGHES AIRCRAFT COMPANY SPACE AND COMMUNICATIONS GROUP EL SEGUNDO, CALIFORNIA

SPACE AND COMMUNICATIONS GROUP FAILURE REPORT

S 8363

1. PROGRAM NAME AND NUMBER THEMATIC MAPPER		2. GLA	3. MODEL FLT	4. TIME OBSERVED 10:00	5. DATE OBSERVED MO 1 DA 13 YR 82
6. HARDWARE LEVEL WHEN FAILURE WAS OBSERVED <input type="checkbox"/> SPACECRAFT <input type="checkbox"/> SUBSYSTEM <input type="checkbox"/> ASSEMBLY <input type="checkbox"/> MODULE <input type="checkbox"/> CARD <input type="checkbox"/> SYSTEM <input checked="" type="checkbox"/> UNIT <input type="checkbox"/> SUBASSEMBLY <input type="checkbox"/> MICAM <input type="checkbox"/> PART					
EQUIPMENT IDENTIFICATION: NAME PART NUMBER S/N MANUFACTURER					
7. SUBSYSTEM					
8. UNIT					
9. <input type="checkbox"/> ASSEMBLY <input type="checkbox"/> SUBASSEMBLY					
10. <input type="checkbox"/> MODULE <input type="checkbox"/> MICAM <input checked="" type="checkbox"/> CARD BAND 3 Post Amplifier 50904-3 201					
11. OTHER					
12. TEST WHEN FAILURE WAS OBSERVED <input type="checkbox"/> DEVELOPMENT <input type="checkbox"/> QUALIFICATION <input type="checkbox"/> INTEGRATION <input type="checkbox"/> LAUNCH OPERATIONS <input type="checkbox"/> IN-PROCESS <input checked="" type="checkbox"/> ACCEPTANCE <input type="checkbox"/> SYSTEM					
13. ENVIRONMENT WHEN FAILURE WAS OBSERVED <input checked="" type="checkbox"/> AMBIENT <input type="checkbox"/> RADIATION <input type="checkbox"/> TEMP <input type="checkbox"/> THERMAL VAC NRS AT <input type="checkbox"/> EMC/RF <input type="checkbox"/> VIBRATION AXIS FOR MIN TYPE <input type="checkbox"/> OTHER					
14. DESCRIPTION OF FAILURE NOMINAL GAIN = 2.0 V.S. SPECIFICATION @ 3.4 FOR EACH CHANNEL. R81 thru R96 ARE ≥ 10K OHMS HOWEVER THE 12.1KΩ R81 thru R96 SELECT RESISTORS ARE VALID. THE TEST SPECIFICATION WAS NOT CONSISTENT WITH THE R81 TO R96 SELECT RANGE.					
15. TEST PROCEDURE 16704 4.19.3 BUYTON 22-13 1/13/82 17. CONTINUATION SHEET USED					
18. VERIFICATION AND FAILURE ANALYSIS Part 50904 SPECIFICATION FOR R81 thru R96 is NOMINAL 3.63KΩ THE TP 16704 PARA 4.19.1 thru 4.19.4 Spec Limits derived from the range of Post Amplifier gains are not consistent with the range of R81 thru R96 pre gain resistors					
19. FAILED ITEM NAME AND PART NUMBER					
20. <input checked="" type="checkbox"/> FOLLOWING REWORK/RETEST REQUIRED <input type="checkbox"/> REWORK/RETEST NOT REQUIRED BECAUSE Correct TP 16704 Para 4.19.1 thru 4.19.4 Spec Limits to conform to pre gain resistor select range.					
21. AUTHORIZATION JA Bonach ORG 22-13 DATE 1-21-82 22. CONTINUATION SHEET USED					
23. REWORK/RETEST ACTION TAKEN EO 4059A written to correct spec limits Test data falls within spec limits no retest required. 23. CONTINUATION SHEET USED					
24. LIST ALL PARTS REPLACED					
PART NUMBER	CKT SYM	PART LOT NUMBER	DATE CODE	MANUFACTURER	PROBABLE DEFECT
27. REWORK BY JA Bonach ORG 22-13 DATE 1-22-82 28. RETESTED BY ORG DATE 29. CONTINUATION SHEET USED					
30. CAUSE AND CORRECTIVE ACTION CAUSE: PARAGRAPHS 4.19.1 THRU 4.19.4 OF TEST PROCEDURE 16704 HAD INCORRECT SPEC. LIMITS C/A: EO 4059A CORRECTS SPEC. LIMITS OF TP 16704. 31. CONTINUATION SHEET USED					
32. DOCUMENT IMPLEMENTING CORRECTIVE ACTION EO 4059A (COPY ATTACHED)					
34. BASIC CAUSE OF VERIFIED FAILURE		35. FAILURE TYPE		36. FAILURE CLASSIFICATION	
<input type="checkbox"/> DESIGN ENVIRONMENTAL DEFECTIVE PARTS	<input type="checkbox"/> TEST EQUIPMENT TEST PROCEDURE TEST SET-UP	<input type="checkbox"/> MFG. PROCEDURE ASSY/FAB ERROR WORKMANSHIP	<input type="checkbox"/> WIRING ERROR ROUGH HANDLING WEAR-OUT	<input type="checkbox"/> UNKNOWN	DEFECT CODE
<input type="checkbox"/> PRIMARY INDUCED	<input checked="" type="checkbox"/> UNKNOWN NO FAILURE	<input type="checkbox"/> CRITICAL MAJOR	<input type="checkbox"/> MINOR SAFETY		
37. RESPONSIBLE ENGINEER JA Bonach ORG 22-13 DATE 1/28/82 38. SPACECRAFT SYSTEMS ENGINEER W. Engel ORG SORC DATE 2/2/82		39. RESPONSIBILITY ST-4 DATE 2/1/82 40. CUSTOMER OR SUPPLIER			

HUGHES

SPACE AND COMMUNICATIONS GROUP
FAILURE REPORT

ORIGINAL PAGE IS
OF POOR QUALITY

HUGHES AIRCRAFT COMPANY
SPACE AND COMMUNICATIONS GROUP
EL SEGUNDO, CALIFORNIA

S 8364

ORIGINATOR	1. PROGRAM NAME AND NUMBER THEMATIC MAPPER		2. GLA	3. MODEL FLT	4. TIME OBSERVED 11:30 A.M.	5. DATE OBSERVED MO 1 DA 28 YR 82	
	6. HARDWARE LEVEL WHEN FAILURE WAS OBSERVED <input type="checkbox"/> SPACECRAFT <input type="checkbox"/> SUBSYSTEM <input type="checkbox"/> ASSEMBLY <input type="checkbox"/> MODULE <input type="checkbox"/> CARD <input type="checkbox"/> SYSTEM <input checked="" type="checkbox"/> UNIT <input type="checkbox"/> SUBASSEMBLY <input type="checkbox"/> MICAM <input type="checkbox"/> PART						
	EQUIPMENT IDENTIFICATION:						
	7. SUBSYSTEM		NAME	PART NUMBER	S/N	MANUFACTURER	
	8. UNIT ELECTRONICS MODULE			52347	201		
	9. <input checked="" type="checkbox"/> ASSEMBLY <input type="checkbox"/> SUBASSEMBLY		REDUNDANT SHUTTER DRIVER		51398	101	
	10. <input type="checkbox"/> MODULE <input type="checkbox"/> MICAM <input type="checkbox"/> CARD						
	11. OTHER						
	12. TEST WHEN FAILURE WAS OBSERVED <input type="checkbox"/> DEVELOPMENT <input type="checkbox"/> IN-PROCESS <input type="checkbox"/> QUALIFICATION <input checked="" type="checkbox"/> ACCEPTANCE <input type="checkbox"/> INTEGRATION <input type="checkbox"/> SYSTEM <input type="checkbox"/> LAUNCH OPERATIONS						
	13. ENVIRONMENT WHEN FAILURE WAS OBSERVED <input checked="" type="checkbox"/> AMBIENT <input type="checkbox"/> EMC/RFI <input type="checkbox"/> RADIATION <input type="checkbox"/> VIBRATION <input type="checkbox"/> TEMP _____ ° <input type="checkbox"/> THERMAL VAC _____ HRS AT _____ <input type="checkbox"/> OTHER						
14. DESCRIPTION OF FAILURE WHEN MAIN SHUTTER ON (CMD 13) ISSUED, THE REDUNDANT SHUTTER DRIVER WAS NOT COMMANDED OFF							
ENGINEERING EVALUATION	15. TEST PROCEDURE 16704		PARA 4.12.4.2	16. ORIGINATOR J.A. Bonach	CRG 22-13	DATE 1/28/82	
	18. VERIFICATION AND FAILURE ANALYSIS THE REDUNDANT SHUTTER DRIVER (51398) COMMAND RELAY'S COIL IS NOT WIRED TO "ORING" DIODES PER 51398 BLUEPRINT. P1-103/104 IS TO CR42-A; P1-107/108 IS TO CR42-C. VOLTAGE ACROSS RELAY COIL DID NOT EXCEED NORMAL OPERATING VOLTAGES. NO OVERSTRESS WAS POSSIBLE.		19. FAILED ITEM NAME AND PART NUMBER				
	20. <input checked="" type="checkbox"/> FOLLOWING REWORK/RETEST REQUIRED <input type="checkbox"/> REWORK/RETEST NOT REQUIRED BECAUSE		REWORK PER 51398 JUMPER LIST ITEMS 6 AND 9 S/B P1-103/104 TO CR42-C P1-107/108 TO CR42-A				
	21. AUTHORIZATION J.A. Bonach		CRG 22-13	DATE 1/28/82	24. CONTINUATION SHEET USED <input type="checkbox"/>		
	21. REWORK/RETEST ACTION TAKEN 51398 PWB P1-103/104 MOVED TO CR42-C P1-107, 108 MOVED TO CR42-C		25. REWORK RETESTED PER PARA 4.12.4.2 CORRECTLY				
	26. LIST ALL PARTS REPLACED		CXT SYM	PART LOT NUMBER	DATE CODE	MANUFACTURER	PROBABLE DEFECT
	27. REWORK BY Antonia Sack		ORG 22-74	DATE 1/28/82	28. RETESTED BY J.A. Bonach	CRG 22-13	DATE 1/28/82
	29. CAUSE AND CORRECTIVE ACTION CAUSE: Rework planning to remove & resolder connector incomplete. Jumper wires 2 places had to be disconnected & resoldered to do this rework & was not in planning. Inspection not alerted to the need to reverify termination of jumper wires. CORRECTIVE ACTION: Mfg. Eng. Supervisor informed of the error & he has agreed to exercise greater care during future planning operations. J.A. Bonach		32. FRB CLOSURE				
	32. DOCUMENT IMPLEMENTING CORRECTIVE ACTION		31. CONTINUATION SHEET USED <input type="checkbox"/>				
	34. BASIC CAUSE OF VERIFIED FAILURE <input type="checkbox"/> DESIGN <input type="checkbox"/> ENVIRONMENTAL <input type="checkbox"/> DEFECTIVE PARTS <input type="checkbox"/> TEST EQUIPMENT <input type="checkbox"/> TEST PROCEDURE <input type="checkbox"/> TEST SET-UP <input type="checkbox"/> MFG. PROCEDURE <input type="checkbox"/> ASSY/FAB ERROR <input type="checkbox"/> WORKMANSHIP <input type="checkbox"/> WIRING ERROR <input type="checkbox"/> ROUGH HANDLING <input type="checkbox"/> WEAR-OUT <input type="checkbox"/> UNKNOWN		DEFECT CODES				
35. FAILURE TYPE <input checked="" type="checkbox"/> PRIMARY <input type="checkbox"/> INDUCED <input type="checkbox"/> UNKNOWN/NO FAILURE		36. FAILURE CLASSIFICATION <input type="checkbox"/> MINOR <input checked="" type="checkbox"/> MAJOR		37. RESPONSIBLE ENGINEER J.A. Bonach		CRG 50RC	
39. RELIABILITY		ORG 22-13	DATE 1/28/82	38. CUSTOMER OR SUPPLIER J. Engel		DATE 2/4/82	

HUGHES

HUGHES AIRCRAFT COMPANY
SPACE AND COMMUNICATIONS GROUP
6110 AVENUE 10
LOS ANGELES, CALIFORNIA 90045

SPACE AND COMMUNICATIONS GROUP
FAILURE REPORT

ORIGINAL PAGE IS
OF POOR QUALITY

S 8365

1. PROGRAM NAME AND NUMBER THOMAS MAPPER		2. CLA		3. MODEL ET		4. TIME OBSERVED 4:00 PM		5. DATE OBSERVED MO 2 DA 3 YR 82		
HARDWARE LEVEL WHEN FAILURE WAS OBSERVED <input type="checkbox"/> SPACECRAFT <input type="checkbox"/> SYSTEM <input type="checkbox"/> SUBSYSTEM <input type="checkbox"/> UNIT <input checked="" type="checkbox"/> ASSEMBLY <input type="checkbox"/> SUBASSEMBLY <input type="checkbox"/> MODULE <input type="checkbox"/> MICAM <input checked="" type="checkbox"/> CARD <input type="checkbox"/> PART										
ORIGINATOR	7. SUBSYSTEM		NAME		PART NUMBER		S/N		MANUFACTURER	
	8. UNIT									
	9. <input type="checkbox"/> ASSEMBLY <input checked="" type="checkbox"/> SUBASSEMBLY									
	10. <input type="checkbox"/> MODULE <input type="checkbox"/> MICAM <input checked="" type="checkbox"/> CARD		B4 POSTAMP		50904-4		201			
	11. OTHER									
ENGINEERING EVALUATION	12. TEST WHEN FAILURE WAS OBSERVED <input type="checkbox"/> DEVELOPMENT <input type="checkbox"/> IN-PROCESS <input checked="" type="checkbox"/> ACCEPTANCE		<input type="checkbox"/> QUALIFICATION <input type="checkbox"/> INTEGRATION <input type="checkbox"/> SYSTEM		<input type="checkbox"/> LAUNCH OPERATIONS					
	13. ENVIRONMENT WHEN FAILURE WAS OBSERVED <input checked="" type="checkbox"/> AMBIENT <input type="checkbox"/> EMC/RF		<input type="checkbox"/> RADIATION <input type="checkbox"/> VIBRATION		<input type="checkbox"/> TEMP AXIS FOR _____ MIN TYPE _____		<input type="checkbox"/> THERMAL VAC _____ HRS AT _____		<input type="checkbox"/> OTHER	
	14. DESCRIPTION OF FAILURE KLFBURBUR, CHS 1, 9, 10.									
ENGINEERING AND TEST	15. TEST PROCEDURE 16368		16. PARA 4.10		19. ORIGINATOR Stoneman		20. ORG 22-13		21. DATE 2-4-82	
	17. CONTINUATION SHEET USED <input type="checkbox"/>		18. VERIFICATION AND FAILURE ANALYSIS APPEARS KLFBURBUR CAPS NOT ACTUALLY CONNECTED INTO CIRCUIT. MORE INVESTIGATION RFD.		19. FAILED ITEM NAME AND PART NUMBER B4 POSTAMP 50904					
	22. FOLLOWING REWORK/RETEST REQUIRED <input checked="" type="checkbox"/> REWORK/RETEST NOT REQUIRED BECAUSE		REWORK BY CORRECTING LEAD B, C57, C61, C65, C69.		RETEST PER 16368 P 4.3.1, 4.3.5, 4.3.7, 4.3.10, 4.3.11, AS NUMBERED IN REV C.					
	21. AUTHORIZATION Stoneman		20. ORG 22-13		21. DATE 2-4-82		22. CONTINUATION SHEET USED <input type="checkbox"/>			
MANUFACTURING AND TEST	23. REWORK/RETEST ACTION TAKEN AS ABOVE. LEAD B OF C57, C61, C65, C69 WAS CORRECTLY PLACED. RETEST WAS DONE. TESTED OK.									
	24. LIST ALL PARTS REPLACED PART NUMBER		CKT SYM		PART LOT NUMBER		DATE CODE		MANUFACTURER	
	PROSABLE DEFECT		ANALYSIS NUMBER							
ENGINEERING/RELIABILITY	27. REWORK BY DUNCAN		28. ORG 22-13		29. DATE 2-4-82		30. TESTED BY Stoneman		31. ORG 22-13	
	32. CONTINUATION SHEET USED <input type="checkbox"/>		33. CAUSE AND CORRECTIVE ACTION POOR WORKMANSHIP		34. ASSEMBLY TECHNICIAN WAS ADVISED OF DISCREPANCY AND CAUTIONED TO CHECK ALL WIRING AND CONNECTIONS THOROUGHLY.		35. FRB CLOSURE			
	32. DOCUMENT IMPLEMENTING CORRECTIVE ACTION									
	34. BASIC CAUSE OF VERIFIED FAILURE <input type="checkbox"/> DESIGN <input type="checkbox"/> ENVIRONMENTAL <input type="checkbox"/> DEFECTIVE PARTS <input type="checkbox"/> TEST EQUIPMENT <input type="checkbox"/> TEST PROCEDURE <input type="checkbox"/> TEST SET-UP <input checked="" type="checkbox"/> MFG. PROCEDURE <input type="checkbox"/> ASSY/FAB ERROR <input checked="" type="checkbox"/> WORKMANSHIP <input type="checkbox"/> WIRING ERROR <input type="checkbox"/> ROUGH HANDLING <input type="checkbox"/> WEAR-OUT <input type="checkbox"/> UNKNOWN		DEFECT CODE							
ENGINEERING/RELIABILITY	36. FAILURE TYPE <input checked="" type="checkbox"/> PRIMARY <input type="checkbox"/> INDUCED <input type="checkbox"/> UNKNOWN <input type="checkbox"/> NO FAILURE		37. FAILURE CLASSIFICATION <input type="checkbox"/> CRITICAL <input type="checkbox"/> MAJOR <input checked="" type="checkbox"/> MINOR <input type="checkbox"/> SAFETY		38. RESPONSIBLE ENGINEER J. J. Bunch		39. ORG 22-41		40. DATE 2/11/82	
	39. RELIABILITY 37-41		40. DATE 2-8-82		41. CUSTOMER OR SUPPLIER AT		42. DATE 4/15/82			

HUGHES

SPACE AND COMMUNICATIONS GROUP

ORIGINAL PAGE IS OF POOR QUALITY

FAILURE REPORT

S 8367

HUGHES AIRCRAFT COMPANY SPACE AND COMMUNICATIONS GROUP EL SEGUNDO, CALIFORNIA

1. PROGRAM NAME AND NUMBER <i>TM PL1162</i>		2. GLA <i>V411</i>		3. MODEL <i>FLT</i>		4. TIME OBSERVED <i>5:30</i>		5. DATE OBSERVED <i>MO 1 DA 19 YR 82</i>					
6. HARDWARE LEVEL WHEN FAILURE WAS OBSERVED <input type="checkbox"/> SPACECRAFT <input type="checkbox"/> SYSTEM		<input type="checkbox"/> SUBSYSTEM <input type="checkbox"/> UNIT		<input type="checkbox"/> ASSEMBLY <input type="checkbox"/> SUBASSEMBLY		<input type="checkbox"/> MODULE <input type="checkbox"/> MICAM		<input checked="" type="checkbox"/> CARD <input type="checkbox"/> PART					
EQUIPMENT IDENTIFICATION:													
7. SUBSYSTEM		NAME			PART NUMBER		S/N		MANUFACTURER				
8. UNIT													
9. <input type="checkbox"/> ASSEMBLY <input type="checkbox"/> SUBASSEMBLY													
10. <input type="checkbox"/> MODULE <input type="checkbox"/> MICAM <input checked="" type="checkbox"/> CARD		<i>Calibration Station</i>			<i>50916</i>		<i>201</i>		<i>SBR C</i>				
11. OTHER													
12. TEST WHEN FAILURE WAS OBSERVED <input type="checkbox"/> DEVELOPMENT <input type="checkbox"/> IN-PROCESS		<input type="checkbox"/> QUALIFICATION <input type="checkbox"/> ACCEPTANCE		<input type="checkbox"/> INTEGRATION <input type="checkbox"/> SYSTEM		<input type="checkbox"/> LAUNCH OPERATIONS							
13. ENVIRONMENT WHEN FAILURE WAS OBSERVED <input type="checkbox"/> AMBIENT <input type="checkbox"/> EMC/RFI		<input type="checkbox"/> RADIATION <input type="checkbox"/> VIBRATION		<input checked="" type="checkbox"/> TEMP <i>0°C</i>		<input type="checkbox"/> THERMAL VAC		HRS AT _____					
14. DESCRIPTION OF FAILURE		<i>Shutter Taps Stop on Turn on at 0°C Ref. Per 139.5 ms</i>											
15. TEST PROCEDURE <i>16238</i>		PARA <i>3.53</i>		18. ORIGINATOR <i>K Evans</i>		ORG <i>2213</i>		DATE <i>1/19/82</i>		17. CONTINUATION SHEET USED <input type="checkbox"/>			
18. VERIFICATION AND FAILURE ANALYSIS <i>Found Saturation Time of AR6-6 gets longer with Cold Temp. Retuned R98 and R90 to correct problem. No Stress To Components</i>													
19. FAILED ITEM NAME AND PART NUMBER													
20. <input checked="" type="checkbox"/> FOLLOWING REWORK/RETEST REQUIRED <input type="checkbox"/> REWORK/RETEST NOT REQUIRED BECAUSE		<i>Change R98 To 1005KΩ, Change R90 To 205KΩ Retest Per 16238 Para 3.5.1, 3.5.2, 3.5.3, 3.5.4, 3.6.1, 3.6.2,</i>											
21. AUTHORIZATION <i>K Evans</i>		ORG <i>2213</i>		DATE <i>1/23/82</i>		22. CONTINUATION SHEET USED <input type="checkbox"/>		23. REWORK ACTION TAKEN <i>Removed and Replaced R98 " " " R90 Retest per TP/16238 Para 3.5.1, 3.5.2, 3.5.3, 3.5.4, 3.6.1, 3.6.2,</i>					
23. LIST ALL PARTS REPLACED		CXT SYM		PART LOT NUMBER		DATE CODE		MANUFACTURER		PROBABLE DEFECT		ANALYSIS NUMBER	
27. REWORK BY <i>M. Conklin gwh</i>		ORG		DATE <i>1/23/82</i>		28. RETESTED BY <i>Joc Reiberg KRC</i>		ORG <i>2213</i>		DATE <i>1/26/82</i>		29. CONTINUATION SHEET USED <input type="checkbox"/>	
30. CAUSE AND CORRECTIVE ACTION <i>At Cold Temp. it was found that optimum values had not been selected, therefore we retuned circuit.</i>													
31. FRB CLOSURE <i>J. Howell 2/2/82</i>													
32. DOCUMENT IMPLEMENTING CORRECTIVE ACTION													
34. BASIC CAUSE OF VERIFIED FAILURE <input type="checkbox"/> DESIGN <input type="checkbox"/> ENVIRONMENTAL <input type="checkbox"/> DEFECTIVE PARTS		<input type="checkbox"/> TEST EQUIPMENT <input type="checkbox"/> TEST PROCEDURE <input type="checkbox"/> TEST SET-UP		<input type="checkbox"/> MFG. PROCEDURE <input type="checkbox"/> ASSY/FAB ERROR <input checked="" type="checkbox"/> WORKMANSHIP		<input type="checkbox"/> WIRING ERROR <input type="checkbox"/> ROUGH HANDLING <input type="checkbox"/> WEAR-OUT		<input checked="" type="checkbox"/> UNKNOWN		DEFECT CODE			
35. FAILURE TYPE <input checked="" type="checkbox"/> PRIMARY <input type="checkbox"/> INDUCED		<input type="checkbox"/> UNKNOWN <input type="checkbox"/> NO FAILURE		38. FAILURE CLASSIFICATION <input type="checkbox"/> CRAFT SYSTEM ENGINEER		<input type="checkbox"/> CRITICAL <input type="checkbox"/> MAJOR		<input checked="" type="checkbox"/> MINOR <input type="checkbox"/> SAFETY					
37. RESPONSIBLE ENGINEER <i>J. Howell</i>		ORG <i>22-13</i>		DATE <i>1/28/82</i>		39. CRAFT SYSTEM ENGINEER <i>J. Howell</i>		ORG <i>SBR C</i>		DATE <i>2/2/82</i>			
39. SPECIALIST <i>J. Howell</i>		ORG <i>5144</i>		DATE <i>2/1/82</i>		40. CUSTOMER OR SUPPLIER <i>ATC</i>							

2/4/82

HUGHES

HUGHES AIRCRAFT COMPANY
SPACE AND COMMUNICATIONS GROUP
EL SEGUNDO, CALIFORNIA

SPACE AND COMMUNICATIONS GROUP
FAILURE REPORT

ORIGINAL PAGE IS
OF POOR QUALITY

S 8384

1. PROGRAM NAME AND NUMBER THEMATIC MAPPER		2. GLA	3. MODEL FLT	4. TIME OBSERVED 1700	5. DATE OBSERVED MO 1 DA 26 YR 82
6. HARDWARE LEVEL WHEN FAILURE WAS OBSERVED <input type="checkbox"/> SPACECRAFT <input type="checkbox"/> SUBSYSTEM <input type="checkbox"/> ASSEMBLY <input type="checkbox"/> MODULE <input type="checkbox"/> CARD <input type="checkbox"/> SYSTEM <input checked="" type="checkbox"/> UNIT <input type="checkbox"/> SUBASSEMBLY <input type="checkbox"/> MICAM <input type="checkbox"/> PART					
EQUIPMENT IDENTIFICATION: NAME PART NUMBER S/N MANUFACTURER					
7. SUBSYSTEM					
8. UNIT ELECTRONICS MODULE 52347 201					
9. <input checked="" type="checkbox"/> ASSEMBLY <input type="checkbox"/> SUBASSEMBLY REDUNDANT SHUTTER DRIVER 51398 201					
10. <input type="checkbox"/> MODULE <input type="checkbox"/> MICAM <input type="checkbox"/> CARD					
11. OTHER					
12. TEST WHEN FAILURE WAS OBSERVED <input type="checkbox"/> DEVELOPMENT <input type="checkbox"/> QUALIFICATION <input type="checkbox"/> INTEGRATION <input type="checkbox"/> LAUNCH OPERATIONS <input type="checkbox"/> IN-PROCESS <input checked="" type="checkbox"/> ACCEPTANCE <input type="checkbox"/> SYSTEM					
13. ENVIRONMENT WHEN FAILURE WAS OBSERVED <input checked="" type="checkbox"/> AMBIENT <input type="checkbox"/> RADIATION <input type="checkbox"/> TEMP _____ ° <input type="checkbox"/> THERMAL VAC _____ HRS AT _____ <input type="checkbox"/> EMC/RFI <input type="checkbox"/> VIBRATION _____ AXIS FOR _____ MIN TYPE <input type="checkbox"/> OTHER					
14. DESCRIPTION OF FAILURE REDUNDANT SHUTTER PHASE LOCK TELEMETRY WORD 6 BIT 6 READS INCORRECTLY "HI" WHEN THE REDUNDANT SHUTTER FUNCTION IS COMMANDED OFF (CMD "OF")					
15. TEST PROCEDURE TP16704		16. PARA 4.12.4.2	18. ORIGINATOR J.A. Banach	19. ORG 22-13	17. DATE 1-27-82
18. VERIFICATION AND FAILURE ANALYSIS REDUNDANT SHUTTER DRIVER (51398) PHASE LOCK SIGNAL U24 PIN 14 DOES NOT HAVE PULL DOWN RESISTOR TO ALLOW EXTERNAL RECEIVING TTL I.C. TO READ SIGNAL CORRECTLY WHEN 51398 IS POWERED OFF. PULL DOWN RESISTOR R168-B INCORRECTLY WIRED TO U12 PIN 10. SHOULD BE R168-B WIRED TO U12 PIN 11					
19. FAILED ITEM NAME AND PART NUMBER NONE					
20. FOLLOWING REWORK/RETEST REQUIRED <input type="checkbox"/> REWORK/RETEST NOT REQUIRED BECAUSE MOVE R168-B CONNECTED WIRE FROM U12 PIN 10 TO U12 PIN 11 RETEST PER TP16704 PARA 4.12.4					
21. AUTHORIZATION J.A. Banach		22. ORG 22-13	23. DATE 1-27-82	24. CONTINUATION SHEET USED <input checked="" type="checkbox"/>	
25. REWORK/RETEST ACTION TAKEN REWORKED TO BLUEPRINT AS IN LINE 30 RETESTED PER PARA 4.12.4.2 CORRECTLY					
26. LIST ALL PARTS REPLACED					
26. PART NUMBER	26. CKT SYM	26. PART LOT NUMBER	26. DATE CODE	26. MANUFACTURER	26. PROBABLE DEFECT
27. REWORKED BY J.A. Banach		28. ORG 22-14	29. DATE 1/27/82	30. RETESTED BY J.A. Banach	31. ORG 22-13
30. CAUSE AND CORRECTIVE ACTION CAUSE: Incorrect wiring of U12 pin 11 by assembly personnel and missed during inspection. CORRECTIVE ACTION: 1) Assembly Supervisor was informed of the error and has instructed his assemblers to exercise greater care in the future. 2) Inspection Supervisor also informed of error and has instructed inspectors to exercise greater care in future inspections.		32. CONTINUATION SHEET USED <input type="checkbox"/>			
33. FRB CLOSURE [Signature] 2/4/82					
34. DOCUMENT IMPLEMENTING CORRECTIVE ACTION					
35. BASIC CAUSE OF VERIFIED FAILURE <input type="checkbox"/> DESIGN ENVIRONMENTAL DEFECTIVE PARTS <input type="checkbox"/> TEST EQUIPMENT <input type="checkbox"/> TEST PROCEDURE <input type="checkbox"/> TEST SET-UP <input type="checkbox"/> MFG. PROCEDURE <input type="checkbox"/> ASSY/FAB ERROR <input type="checkbox"/> WORKMANSHIP <input type="checkbox"/> WIRING ERROR <input type="checkbox"/> ROUGH HANDLING <input type="checkbox"/> WEAR-OUT <input type="checkbox"/> UNKNOWN		36. DEFECT CODE			
37. FAILURE TYPE <input checked="" type="checkbox"/> PRIMARY <input type="checkbox"/> INDUCED		38. UNKNOWN <input type="checkbox"/> NO FAILURE		39. FAILURE CLASSIFICATION <input type="checkbox"/> CRITICAL <input type="checkbox"/> MAJOR <input checked="" type="checkbox"/> MINOR <input type="checkbox"/> SAFETY	
37. RESPONSIBLE ENGINEER J.A. Banach		40. ORG 22-14	41. DATE 1/28/82	42. SPECIALIST SYSTEM ENGINEER [Signature] 55RC 2/4/82	
39. RELIABILITY		43. ORG	44. DATE	45. POWER SUPPLIER	

HUGHES

SPACE AND COMMUNICATIONS GROUP

HUGHES AIRCRAFT COMPANY
SPACE AND COMMUNICATIONS GROUP
EL SEGUNDO, CALIFORNIA

FAILURE REPORT
CONTINUATION SHEET

FR SERIAL NO.	58384
COORDINATING ENGINE LETTER	A

*LABEL FIRST CONTINUATION SHEET USED 'A', SECOND 'B', AND SO ON

ADDITIONAL FR CONTINUATION SHEETS USED	<input type="checkbox"/>
--	--------------------------

IDENTIFY ENTRIES BY REFERENCING FR CLOCK NUMBER IN COLUMN DATE EACH ENTRY.

18 MISWIRING REDUCED LOAD ON U24 D. EFFECTIVELY
R 16B WAS NOT CONNECTED TO GROUND AND DID
NOT DRAW CURRENT THROUGH U24 D. NO OVERSTRESS
OCCURRED ^{UP}

ORIGINAL PAGE IS
OF POOR QUALITY

HUGHES

ORIGINAL PAGE IS OF POOR QUALITY

SPACE AND COMMUNICATIONS GROUP

FAILURE REPORT

S 8390

HUGHES AIRCRAFT COMPANY SPACE AND COMMUNICATIONS GROUP EL SEGUNDO, CALIFORNIA

1. PROGRAM NAME AND NUMBER THEMATIC MAPPER		2. GLA		3. MODEL PLT		4. TIME OBSERVED 11 PM		5. DATE OBSERVED MO 2 DA 14 YR 82		
6. HARDWARE LEVEL WHEN FAILURE WAS OBSERVED <input type="checkbox"/> SPACECRAFT <input type="checkbox"/> SYSTEM		<input type="checkbox"/> SUBSYSTEM <input checked="" type="checkbox"/> UNIT		<input type="checkbox"/> ASSEMBLY <input type="checkbox"/> SUBASSEMBLY		<input checked="" type="checkbox"/> MODULE <input type="checkbox"/> MICAM		<input type="checkbox"/> CARD <input type="checkbox"/> PART		
EQUIPMENT IDENTIFICATION:										
7. SUBSYSTEM		NAME			PART NUMBER		S/N		MANUFACTURER	
8. UNIT		ELECTRONICS MODULE			52347		201			
9. <input type="checkbox"/> ASSEMBLY <input type="checkbox"/> SUBASSEMBLY										
10. <input checked="" type="checkbox"/> MODULE <input type="checkbox"/> MICAM <input type="checkbox"/> CARD ELECTRONICS MODULE										
11. OTHER										
12. TEST WHEN FAILURE WAS OBSERVED <input type="checkbox"/> DEVELOPMENT <input type="checkbox"/> IN-PROCESS <input checked="" type="checkbox"/> QUALIFICATION <input type="checkbox"/> ACCEPTANCE <input type="checkbox"/> INTEGRATION <input type="checkbox"/> SYSTEM <input type="checkbox"/> LAUNCH OPERATIONS										
13. ENVIRONMENT WHEN FAILURE WAS OBSERVED <input checked="" type="checkbox"/> AMBIENT <input type="checkbox"/> EMC/RFI <input type="checkbox"/> RADIATION <input type="checkbox"/> VIBRATION <input type="checkbox"/> TEMP _____ <input type="checkbox"/> THERMAL VAC _____ HRS AT _____ <input type="checkbox"/> OTHER										
14. DESCRIPTION OF FAILURE SMA +28V MEASURED 30.8V, SPEC IS 28V TO 30.5VDC SMA -28V MEASURED -30.8V, SPEC IS -28V TO -30.5VDC										
15. TEST PROCEDURE 16704		4239.R 4237.6		18. ORIGINATOR BUYTON		19. DATE 22-13 17 FEB 82		17. CONTINUATION SHEET USED		
18. VERIFICATION AND FAILURE ANALYSIS THE SMA +28V OUTPUTS UNDER FULL LOAD CONDITIONS READ 300 MV OUT OF SPECIFICATIONS AS PREVIOUSLY DEFINED IN POWER SUPPLY DESIGN SPEC THE POWER SUPPLY BGA DEFINES TS16603 REV B AS CORRECT										
19. FAILED ITEM NAME AND PART NUMBER										
20. <input type="checkbox"/> FOLLOWING REWORK/RETEST REQUIRED <input checked="" type="checkbox"/> REWORK/RETEST NOT REQUIRED BECAUSE MODIFY TEST PROCEDURE TO SPECIFY 28 TO 31VDC FOR SMA +28V MODIFY TEST PROCEDURE TO SPECIFY -28 TO -31.5 VDC FOR SMA -28V VIA E.O. TO CONFORM TO POWER SUPPLY TEST SPEC 16603 REV B										
21. AUTHORIZATION J.A. Branch				ORG 22-13		DATE 2-22-82		22. CONTINUATION SHEET USED		
23. REWORK/RETEST ACTION TAKEN NONE		24. QA REWORK		25. QA RETEST						
26. LIST ALL PARTS REPLACED										
PART NUMBER		CKT SYM	PART LOT NUMBER	DATE CODE	MANUFACTURER	PROBABLE DEFECT		ANALYSIS NUMBER		
27. REWORK BY										
ORG		DATE		28. RETESTED BY		ORG		DATE		
29. CONTINUATION SHEET USED										
30. CAUSE AND CORRECTIVE ACTION TEST SPECIFICATION INCONSISTENCIES CORRECTED. TOLERANCE INCREASED TO $\pm 28V \pm 3VDC$ TO $28V < V < 31VDC$ AND $-28V < V < -31VDC$.										
31. FRB CLOSURE										
32. DOCUMENT IMPLEMENTING CORRECTIVE ACTION EO 4059 A EFFECTIVE 3/1/82 3408 (COPY ATTACHED)										
33. BASIC CAUSE OF VERIFIED FAILURE		<input type="checkbox"/> DESIGN ENVIRONMENTAL DEFECTIVE PARTS		<input type="checkbox"/> TEST EQUIPMENT		<input type="checkbox"/> WFG. PROCEDURE		<input type="checkbox"/> WIRING ERROR		
34. FAILURE TYPE		<input type="checkbox"/> PRIMARY <input type="checkbox"/> INDUCED		<input checked="" type="checkbox"/> UNKNOWN <input type="checkbox"/> NO FAILURE		<input type="checkbox"/> TEST PROCEDURE		<input type="checkbox"/> ASSY/FAB ERROR		
35. RESPONSIBLE ENGINEER J.A. Branch		ORG 22-13		DATE 2-24-82		36. SPACECRAFT SYSTEM ENGINEER J.A. Branch		ORG 22-41		
37. RESPONSIBLE ENGINEER J.A. Branch		ORG 5141		DATE 2-25-82		38. FAILURE CLARIFICATION		39. DATE 2/25/82		
39. AEL/ABO/AVI J.A. Branch		ORG 5141		DATE 2-25-82		40. FAILURE CLARIFICATION		41. DATE		

HUGHES

SPACE AND COMMUNICATIONS GROUP
FAILURE REPORT

ORIGINAL PAGE IS
OF POOR QUALITY

S 8407

HUGHES AIRCRAFT COMPANY
SPACE AND COMMUNICATIONS GROUP
EL SEGUNDO, CALIFORNIA

1. PROGRAM NAME AND NUMBER TM 4011		2. GLA	3. MODEL FLIGHT	4. TIME OBSERVED 0930	5. DATE OBSERVED MO 07 DA 15 YR 81	
6. HARDWARE LEVEL WHEN FAILURE WAS OBSERVED <input type="checkbox"/> SPACECRAFT <input type="checkbox"/> SYSTEM		<input checked="" type="checkbox"/> SUBSYSTEM <input type="checkbox"/> UNIT	<input type="checkbox"/> ASSEMBLY <input type="checkbox"/> SUBASSEMBLY	<input type="checkbox"/> MODULE <input type="checkbox"/> MICAM	<input type="checkbox"/> CARD <input type="checkbox"/> PART	
EQUIPMENT IDENTIFICATION: NAME PART NUMBER S/N MANUFACTURER						
7. SUBSYSTEM						
8. UNIT ELECTRONICS MODULE						
9. <input type="checkbox"/> ASSEMBLY <input checked="" type="checkbox"/> SUBASSEMBLY 52347 3 50904-X 201 SBAC						
10. <input type="checkbox"/> MODULE <input type="checkbox"/> MICAM <input type="checkbox"/> CARD						
11. OTHER						
12. TEST WHEN FAILURE WAS OBSERVED <input type="checkbox"/> DEVELOPMENT <input checked="" type="checkbox"/> IN-PROCESS <input type="checkbox"/> QUALIFICATION <input checked="" type="checkbox"/> ACCEPTANCE <input type="checkbox"/> INTEGRATION <input type="checkbox"/> SYSTEM <input type="checkbox"/> LAUNCH OPERATIONS						
13. ENVIRONMENT WHEN FAILURE WAS OBSERVED <input type="checkbox"/> AMBIENT <input type="checkbox"/> RADIATION <input checked="" type="checkbox"/> TEMP 15 °C <input type="checkbox"/> THERMAL VAC _____ HRS AT _____ <input type="checkbox"/> EMC/RFI <input type="checkbox"/> VIBRATION _____ AXIS FOR _____ MIN TYPE _____ <input type="checkbox"/> OTHER _____						
14. DESCRIPTION OF FAILURE CH. 5 R 83 IS 60.4KΩ, SHOULD BE 10.0KΩ. R67 IS 10.0KΩ, SHOULD BE 10.0KΩ. CH. 14, R 95 IS 20.5KΩ, SHOULD BE 17.4KΩ, R31 IS 17.4KΩ, SHOULD BE 20.5KΩ						
15. TEST PROCEDURE 16597		16. PARA 4.5	18. ORIGINATOR C. R. Lane	19. ORG 2213	17. DATE 07-15-81	
17. CONTINUATION SHEET USED <input type="checkbox"/>						
18. VERIFICATION AND FAILURE ANALYSIS VISUAL ANALYSIS SHOWS R83 & R67 REVERSED; R31 & R95 REVERSED. R95(PREGAIN) SHOULD HAVE BEEN 17.4K R83(PREGAIN) SHOULD HAVE BEEN 10.0K; R67(ROLLOFF) SHOULD HAVE BEEN 60.4K R31(OFFSET) SHOULD HAVE BEEN 20.5K						
19. FAILED ITEM NAME AND PART NUMBER N/A						
20. <input checked="" type="checkbox"/> FOLLOWING REWORK/RETEST REQUIRED <input type="checkbox"/> REWORK/RETEST NOT REQUIRED BECAUSE REWORK TO PRINT & CONTINUE TEST.						
21. AUTHORIZATION Thomas & Sullivan						
22. CONTINUATION SHEET USED <input type="checkbox"/>						
23. REWORK/RETEST ACTION TAKEN RESISTORS WERE REINSTALLED PROPERLY.						
24. QA REVIEW <input checked="" type="checkbox"/>						
25. QA RETEST <input checked="" type="checkbox"/>						
26. LIST ALL PARTS REPLACED						
PART NUMBER	CKT SYM	PART LOT NUMBER	DATE CODE	MANUFACTURER	PROBABLE DEFECT	ANALYSIS NUMBER
NONE						
27. REWORK BY ORG DATE						28. RETESTED BY ORG DATE
29. CONTINUATION SHEET USED <input type="checkbox"/>						
30. CAUSE AND CORRECTIVE ACTION WORKMANSHIP ERROR WHEN MOVING SELECT RESISTORS FROM STANDOFFS TO THE BOARD. MANUFACTURING PERSONNEL HAVE BEEN READVISED TO USE CARE WHEN REMOVING AND REINSTALLING SELECT RESISTORS. INSPECTION PERSONNEL HAVE BEEN INSTRUCTED TO EXERCISE GREATER CARE IN INSPECTING SELECT INSTALLATIONS AND SURROUNDING AREAS.						
31. FRB CLOSURE						
32. DOCUMENT IMPLEMENTING CORRECTIVE ACTION NONE REQ'D						
33. CONTINUATION SHEET USED <input type="checkbox"/>						
34. BASIC CAUSE OF VERIFIED FAILURE <input type="checkbox"/> DESIGN <input type="checkbox"/> ENVIRONMENTAL <input type="checkbox"/> DEFECTIVE PARTS <input type="checkbox"/> TEST EQUIPMENT <input type="checkbox"/> TEST PROCEDURE <input type="checkbox"/> TEST SET-UP <input type="checkbox"/> MFG. PROCEDURE <input type="checkbox"/> ASSY/FAB ERROR <input checked="" type="checkbox"/> WORKMANSHIP <input type="checkbox"/> WIRING ERROR <input type="checkbox"/> ROUGH HANDLING <input type="checkbox"/> WEAR-OUT						
35. FAILURE TYPE <input checked="" type="checkbox"/> PRIMARY <input type="checkbox"/> SECONDARY <input type="checkbox"/> UNKNOWN <input type="checkbox"/> NO FAILURE						
36. FAILURE CLASSIFICATION <input type="checkbox"/> CRITICAL <input type="checkbox"/> MAJOR <input checked="" type="checkbox"/> MINOR <input type="checkbox"/> SAFETY						
37. RESPONSIBLE ENGINEER Randall						
38. SPACECRAFT SYSTEM ENGINEER J. C. ...						
39. RELIABILITY A. Huber						
40. DATE 2122 11-3-81						
41. DATE 51-11 11-03-81						
42. DATE 2261 11/10/81						



MAIN AHR-OP#1300

ORIGINAL PAGE IS OF POOR QUALITY

SPACE AND COMMUNICATIONS GROUP

FAILURE REPORT

S 8446

HUGHES AIRCRAFT COMPANY
SPACE AND COMMUNICATIONS GROUP
EL SEGUNDO, CALIFORNIA

1. PROGRAM NAME AND NUMBER VC11 T.M.		2. GLA		3. MODEL FLIGHT		4. TIME OBSERVED 3:30 P.M.		5. DATE OBSERVED MO 8 DA 6 YR 81					
8. HARDWARE LEVEL WHEN FAILURE WAS OBSERVED <input type="checkbox"/> SPACECRAFT <input type="checkbox"/> SYSTEM		<input type="checkbox"/> SUBSYSTEM <input type="checkbox"/> UNIT		<input checked="" type="checkbox"/> ASSEMBLY <input type="checkbox"/> SUBASSEMBLY		<input type="checkbox"/> MODULE <input type="checkbox"/> MICAM		<input type="checkbox"/> CARD <input type="checkbox"/> PART					
EQUIPMENT IDENTIFICATION:													
7. SUBSYSTEM		NAME			PART NUMBER		S/N		MANUFACTURER				
8. UNIT ELECTRONICS MODULE		4 1/2 INCH			52347								
9. ASSEMBLY <input checked="" type="checkbox"/> ASSEMBLY <input type="checkbox"/> SUBASSEMBLY		BAND 3 POSTAMP			SD904A 201		201		SBRC.				
10. <input type="checkbox"/> MODULE <input type="checkbox"/> MICAM <input type="checkbox"/> CARD		11. OTHER											
12. TEST WHEN FAILURE WAS OBSERVED <input type="checkbox"/> DEVELOPMENT <input checked="" type="checkbox"/> IN-PROCESS		<input type="checkbox"/> QUALIFICATION <input type="checkbox"/> ACCEPTANCE		<input type="checkbox"/> INTEGRATION <input type="checkbox"/> SYSTEM		<input type="checkbox"/> LAUNCH OPERATIONS							
13. ENVIRONMENT WHEN FAILURE WAS OBSERVED <input type="checkbox"/> AMBIENT <input type="checkbox"/> EMC/RR		<input type="checkbox"/> RADIATION <input type="checkbox"/> VIBRATION		TEMP 15.0		THERMAL VAC		MRS AT					
14. DESCRIPTION OF FAILURE CHANNEL 8 praged.		15. TEST PROCEDURE 16597 PARA 4.5											
16. VERIFICATION AND FAILURE ANALYSIS RESISTORS R28 AND R12 INTERCHANGED R28 (OFFSET ADJ) SHOULD HAVE BEEN 22.5K R12 (BOOST) SHOULD HAVE BEEN 3.65K		18. ORIGINAL ORG N.C. DAVISON		19. DATE 8-7-81		17. CONTINUATION SHEET USED <input type="checkbox"/>							
20. FOLLOWING REWORK/RETEST REQUIRED <input type="checkbox"/> REWORK/RETEST NOT REQUIRED BECAUSE		REVERSE R28 AND R12 AND CONTINUE TEST/ SELECTION PROCESS.											
21. AUTHORIZATION N.C. DAVISON		ORG 2213		DATE 8-7-81		22. CONTINUATION SHEET USED <input type="checkbox"/>							
23. REWORK/RETEST ACTION TAKEN RESISTORS WERE REINSTALLED PROPERLY. NO OVERSTRESS PER HS 236-7691.		24. QA REVIEW 59		25. QA REVIEW 59									
26. LIST ALL PARTS REPLACED		CKT SYM		PART LOT NUMBER		DATE CODE		MANUFACTURER		PROBABLE DEFECT		ANALYSIS NUMBER	
NONE													
27. REWORK BY		ORG		DATE		28. RETESTED BY		ORG		DATE		29. CONTINUATION SHEET USED <input type="checkbox"/>	
30. CAUSE AND CORRECTIVE ACTION WORKMANSHIP ERROR WHEN MOVING SELECT RESISTORS FROM STANDOFFS TO BOARD. MANUFACTURING PERSONNEL HAVE BEEN READVISED TO USE CARE WHEN REMOVING AND REINSTALLING SELECT RESISTORS. INSPECTION PERSONNEL HAVE BEEN INSTRUCTED TO EXERCISE GREATER CARE IN INSPECTING SELECT INSTALLATIONS AND SURROUNDING AREAS.		31. FRG CLOSURE		J. B. Smith 11/4/81									
32. DOCUMENT IMPLEMENTING CORRECTIVE ACTION NONE REQ'D		33. CONTINUATION SHEET USED <input type="checkbox"/>											
34. BASIC CAUSE OF VERIFIED FAILURE <input type="checkbox"/> DESIGN <input type="checkbox"/> ENVIRONMENTAL <input type="checkbox"/> DEFECTIVE PARTS		<input type="checkbox"/> TEST EQUIPMENT <input type="checkbox"/> TEST PROCEDURE <input type="checkbox"/> TEST SET-UP		<input type="checkbox"/> MFG. PROCEDURE <input type="checkbox"/> ASSY/FAB ERROR <input checked="" type="checkbox"/> WORKMANSHIP		<input type="checkbox"/> WIRING ERROR <input type="checkbox"/> ROUGH HANDLING <input type="checkbox"/> WEAR-OUT		<input checked="" type="checkbox"/> UNKNOWN		DEFECT CODE			
35. FAILURE TYPE <input checked="" type="checkbox"/> PRIMARY <input type="checkbox"/> HOUSE		<input type="checkbox"/> UNKNOWN <input checked="" type="checkbox"/> NO FAILURE		36. FAILURE CLASSIFICATION <input type="checkbox"/> CRITICAL <input checked="" type="checkbox"/> MAJOR		<input type="checkbox"/> MINOR <input type="checkbox"/> SAFETY							
37. TESTED BY ENGINEER A. Huber		ORG SI-11		DATE 11-3-81		38. SPACECRAFT SYSTEM ENGINEER J. B. Smith		ORG 2261		DATE 8/11/81			
39. RELIABILITY		ORG SI-11		DATE 11-03-81		40. CUSTOMER OR SUPPLIER F&B		DATE 11/5/81					

PART NO. 50904-8471		PART NAME PWB Assy. POSTAMP BAND 34		ASSY/LOT SERIAL NO. 201	QTY 1
OPER NO.	DATE	OPERATOR OR INSP	COMMENTS, TEST DATA, ETC	DISPOSITION	APPROVAL
1300 SUPP. 14 1303	8-7-81	[Signature]	SEE FR 8446 - "CHANNEL 8 IS REFFED"	REWORK PER FR 8446	[Signature]
			1. REMOVE EXISTING RESISTORS FROM R12 & R28	REWORK PER F.R. 8446 & B/P	[Signature]
	8-11-81	[Signature]	2. INSTALL ON STANDOFF WIRE AT R12 (3.65K)	[Signature]	
			3. PERMANENTLY INSTALL AT R28 (22.1K) PER B/P.	[Signature]	
			4. RETURN TO TEST FOR RE-SELECTION PER SPEC. 16597 PER SUPP #14 OPN #1303.		

8-6-81

ORIGINAL PAGE IS OF POOR QUALITY

58446

ORIGINAL PAGE IS
OF POOR QUALITY

58446

SANTA BARBARA RESEARCH CENTER
A Subsidiary of Hughes Aircraft Company

INTERNAL MEMORANDUM

TO: L. O'Connell

CC: Altman, L.
Barnett, G.C.
Davison, N.C.
Randall, D.M.
Rangel, J.
Wilkerson, R.J.
Data Bank (8)

DATE: 26 October 1981

REF: HS 236-7691
REAR 81/53


FROM: A. Huber

SUBJECT: FR: S8446
(Band 4 Postamplifier Board,
50904, Flight)

BLDG. B-11 MAIL STA. 102
EXT. 6246

FR: S8446, dated August 6, 1981


The failure was encountered when retesting Band 4, channel 8, after select resistors were removed from standoffs and placed directly onto the 50904 post-amplifier board. It was found that in moving the resistors to the board, two resistors were interchanged. The resistors were R28 (22.5K, offset) and R12 (3.65K, boost). The resistors were subsequently moved to their proper locations. Figure 1 illustrates the offset and boost circuits which resulted from the interchange of resistors. No overstress occurred.


A.E. Huber

AEH:jc

ORIGINAL PAGE IS
OF POOR QUALITY

WAS

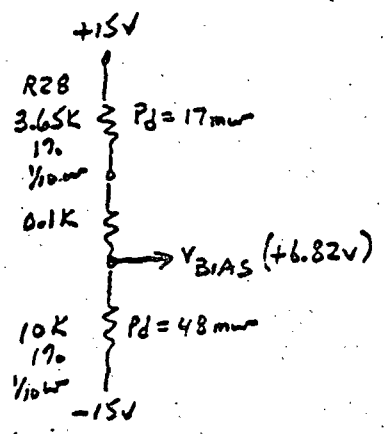

SHOULD HAVE BEEN

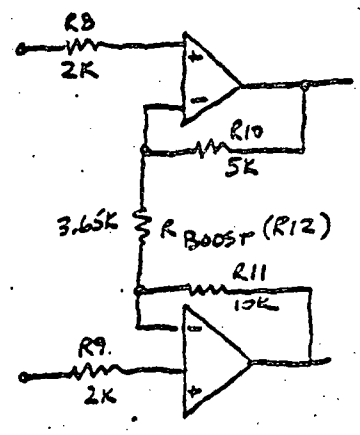
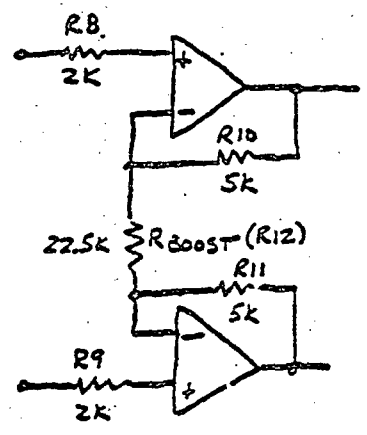
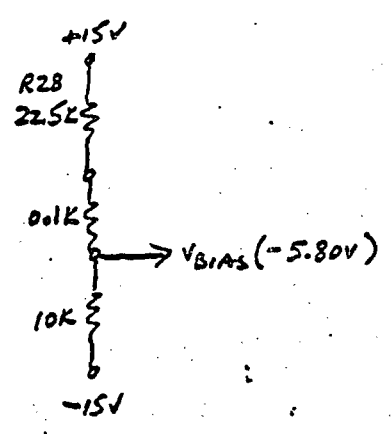


FIGURE L : OFFSET AND BOOST CIRCUITS RESULTING FROM INTERCHANGE OF R2B AND R12.

HUGHES

HUGHES AIRCRAFT COMPANY
SPACE AND COMMUNICATIONS GROUP
EL SEGUNDO, CALIFORNIA

ORIGINAL PAGE IS
OF PGOR QUALITY
SPACE AND COMMUNICATIONS GROUP
FAILURE REPORT

AHR 50904-3
OPERATION 1300

S 8447

ORIGINATOR	1. PROGRAM NAME AND NUMBER TM VO11		2. GLA	3. MODEL FLIGHT	4. TIME OBSERVED 4:30 p.m.	5. DATE OBSERVED MO 7 DA 23 YR 81	
	6. HARDWARE LEVEL WHEN FAILURE WAS OBSERVED <input type="checkbox"/> SPACECRAFT <input type="checkbox"/> SUBSYSTEM <input checked="" type="checkbox"/> ASSEMBLY <input type="checkbox"/> MODULE <input type="checkbox"/> CARD <input type="checkbox"/> SYSTEM <input type="checkbox"/> UNIT <input type="checkbox"/> SUBASSEMBLY <input type="checkbox"/> MICAM <input type="checkbox"/> PART						
	EQUIPMENT IDENTIFICATION:						
	7. SUBSYSTEM		NAME	PART NUMBER	S/N	MANUFACTURER	
	8. UNIT		4		401		
	9. <input checked="" type="checkbox"/> ASSEMBLY <input type="checkbox"/> SUBASSEMBLY		BAND 3 POST AMP	50904	2	SBRC	
	10. <input type="checkbox"/> MODULE <input type="checkbox"/> MICAM <input type="checkbox"/> CARD						
	11. OTHER						
	12. TEST WHEN FAILURE WAS OBSERVED <input type="checkbox"/> DEVELOPMENT <input type="checkbox"/> IN-PROCESS <input checked="" type="checkbox"/> QUALIFICATION <input type="checkbox"/> ACCEPTANCE <input type="checkbox"/> INTEGRATION <input type="checkbox"/> SYSTEM <input type="checkbox"/> LAUNCH OPERATIONS						
	13. ENVIRONMENT WHEN FAILURE WAS OBSERVED <input type="checkbox"/> AMBIENT <input type="checkbox"/> EMC/RF <input type="checkbox"/> RADIATION <input type="checkbox"/> VIBRATION <input type="checkbox"/> TEMP 15. C <input type="checkbox"/> THERMAL VAC <input type="checkbox"/> IRS AT <input type="checkbox"/> OTHER						
14. DESCRIPTION OF FAILURE CHANNELS 2,3,4,5,6,7,8,10,11,12,14,15 & 16 FAIL TO MEET TRANSIENT AND/OR FREQUENCY RESPONSE REQUIREMENTS							
15. TEST PROCEDURE 16597		16. PARA 4.6	18. ORIGINATOR A. C. JAYSON	CRG	DATE 7-24-81	17. CONTINUATION SHEET USED <input type="checkbox"/>	
18. VERIFICATION AND FAILURE ANALYSIS							
19. FAILED ITEM NAME AND PART NUMBER							
20. <input checked="" type="checkbox"/> FOLLOWING REWORK/RETEST REQUIRED <input type="checkbox"/> REWORK/RETEST NOT REQUIRED BECAUSE PLACE THE FOLLOWING RESISTORS ON STANDOFFS AND RESPECT: R2,3,4,6,8,9,10,11,12,13,14,15,16, 66, 67, 68, 70, 72, 73, 74, 75, 76, 77, 78, 79 AND R80.							
21. AUTHORIZATION							
22. CONTINUATION SHEET USED <input type="checkbox"/>							
23. QA REWORK							
24. QA RETEST							
25. REWORK/RETEST ACTION TAKEN Reaction was done after being notified from FPA and an improved flow of N2 gas was established to keep the FPA dry. Resistance is a result of water as listed on the test 8324. No reaction to any components.							
26. LIST ALL PARTS REPLACED							
PART NUMBER	PKT SYM	PART LOT NUMBER	DATE CODE	MANUFACTURER	PROBABLE DEFECT	ANALYSIS NUMBER	
27. REWORK BY							
28. RETESTED BY							
29. CONTINUATION SHEET USED <input type="checkbox"/>							
30. CAUSE AND CORRECTIVE ACTION Moisture was condensing on the FPA during select testing due to inadequate N2 gas flow onto the FPA. N2 flow has been increased and is now directed to FPA.							
31. FRB CLOSURE							
32. DOCUMENT IMPLEMENTING CORRECTIVE ACTION W-TT (COPY ATTACHED) DC-12-23-81							
33. CONTINUATION SHEET USED <input type="checkbox"/>							
34. BASIC CAUSE OF VERIFIED FAILURE <input type="checkbox"/> DESIGN ENVIRONMENTAL DEFECTIVE PARTS <input type="checkbox"/> TEST EQUIPMENT TEST PROCEDURE TEST SET-UP <input type="checkbox"/> MFG. PROCEDURE ASSY/FAB ERROR WORKMANSHIP <input type="checkbox"/> WIRING ERROR ROUGH HANDLING WEAR-OUT <input type="checkbox"/> UNKNOWN DEFECT CODE							
35. FAILURE TYPE <input checked="" type="checkbox"/> PRIMARY <input type="checkbox"/> INDUCED <input type="checkbox"/> UNKNOWN <input type="checkbox"/> NO FAILURE							
36. FAILURE CLASSIFICATION <input type="checkbox"/> CRITICAL <input type="checkbox"/> MAJOR <input checked="" type="checkbox"/> MINOR <input type="checkbox"/> SAFETY							
37. RESPONSIBLE ENGINEER E. J. Evans		ORG 51-41	DATE 11/19/81	38. SPACECRAFT SYSTEM ENGINEER J. F. Orsag		ORG 22-41	
39. RELIABILITY		ORG 51-41	DATE 12-18-81	40. CUSTOMER OR SUPPLIER SA		DATE 12/18/81	

HUGHES

HUGHES AIRCRAFT COMPANY
SPACE AND COMMUNICATIONS GROUP
EL SEGUNDO, CALIFORNIA

SPACE AND COMMUNICATIONS GROUP
FAILURE REPORT

ORIGINAL PAGE IS
OF POOR QUALITY

S 8456

1. PROGRAM NAME AND NUMBER <i>Thematic Paper</i>		2. GLA	3. MODEL <i>FL1</i>	4. TIME OBSERVED <i>16:30</i>	5. DATE OBSERVED <i>MO 11 DA 11 YR 81</i>
6. HARDWARE LEVEL WHEN FAILURE WAS OBSERVED <input type="checkbox"/> SPACECRAFT <input type="checkbox"/> SUBSYSTEM <input type="checkbox"/> UNIT <input checked="" type="checkbox"/> ASSEMBLY <input type="checkbox"/> SUBASSEMBLY <input type="checkbox"/> MODULE <input type="checkbox"/> MICAM <input type="checkbox"/> CARD <input type="checkbox"/> PART					
EQUIPMENT IDENTIFICATION: NAME PART NUMBER S/N MANUFACTURER					
7. SUBSYSTEM					
8. UNIT					
9. <input type="checkbox"/> ASSEMBLY <input type="checkbox"/> SUBASSEMBLY					
10. <input type="checkbox"/> MODULE <input type="checkbox"/> MICAM <input checked="" type="checkbox"/> CARD <i>Verification Register</i> <i>50948</i> <i>201</i>					
11. OTHER					
12. TEST WHEN FAILURE WAS OBSERVED <input type="checkbox"/> DEVELOPMENT <input type="checkbox"/> IN-PROCESS <input type="checkbox"/> QUALIFICATION <input checked="" type="checkbox"/> ACCEPTANCE <input type="checkbox"/> INTEGRATION <input type="checkbox"/> SYSTEM <input type="checkbox"/> LAUNCH OPERATIONS					
13. ENVIRONMENT WHEN FAILURE WAS OBSERVED <input type="checkbox"/> AMBIENT <input type="checkbox"/> EMC/RFI <input type="checkbox"/> RADIATION <input checked="" type="checkbox"/> VIBRATION <i>0°C</i> <input type="checkbox"/> THERMAL VAC <input type="checkbox"/> HRS AT <input type="checkbox"/> OTHER					
14. DESCRIPTION OF FAILURE <i>WORD G FAILED ONCE DURING DATA CYCLING AT 0°C (6x10⁶ CYCLES) PRIMARY WORD G OUTPUT IS X'BD SHOULD BE X'AD'.</i>					
15. TEST PROCEDURE <i>16422</i>		16. PARA <i>5.4.13</i>	18. ORIGINAL FOR <i>16422</i>	19. LOG # <i>22-13</i>	DATE <i>11/11/81</i>
17. CONTINUATION SHEET USED <input type="checkbox"/>					
18. VERIFICATION AND FAILURE ANALYSIS <i>NOTE FR 8309 AND SUBSEQUENT AMBIENT TESTING DEALT WITH U31 PIN 7 (G OUTPUT) SHORT TO GROUND BY SOLDER SPLASH ACROSS TRACES, ITS REMOVAL, AND PROPER FUNCTIONING. THE FAILURE OF 1 OF 8 BITS IN WORD G ONCE IN 6x10⁶ CYCLES AT 0°C REQUIRES REMOVAL & REPLACEMENT OF U31</i>					
19. FAILED ITEM NAME AND PART NUMBER <i>U31-546165 = 909940-1</i>					
20. <input checked="" type="checkbox"/> FOLLOWING REWORK/RETEST REQUIRED <input type="checkbox"/> REWORK/RETEST NOT REQUIRED BECAUSE <i>REMOVE & REPLACE U31 (909940-1)</i>					
<i>RETEST PER TP 16422 PARA 5.4.3</i>					
21. AUTHORIZATION <i>J.A. Baruch</i>				ORG <i>22-B</i>	DATE <i>11/12/81</i>
22. CONTINUATION SHEET USED <input type="checkbox"/>					
23. REWORK/RETEST ACTION TAKEN <i>U31 REPLACED BY SUPPL. B & RETEST PER 5.4.3 PERFORMED AND NO FAILURES OCCURRED</i>					
24. <input checked="" type="checkbox"/> REWORK <i>110</i>					
25. <input checked="" type="checkbox"/> RETEST <i>110</i>					
26. LIST ALL PARTS REPLACED PART NUMBER CRT SYM PART LOT NUMBER DATE CODE MANUFACTURER PROBABLE DEFECT ANALYSIS NUMBER					
<i>909940-1 U31</i>					
27. REWORK BY <i>M. GUERRA</i>		ORG <i>22-74</i>	DATE <i>12 NOV '81</i>	28. RETESTED BY <i>GUYTON</i>	ORG <i>22-13</i>
					DATE <i>17 NOV '81</i>
29. CONTINUATION SHEET USED <input type="checkbox"/>					
30. CAUSE AND CORRECTIVE ACTION <i>POSSIBLE U31 MARGINAL FAILURE DUE TO U31-7 TO U31-8 SHORT; OR DUE TO HEATING TRACES AS PREVIOUSLY NOTED SOLDER SPLASH WAS REMOVED. PROBABLE ACTUAL CAUSE OF U31 FAILURE NOT CLEARLY KNOWN. PER FAILURE ANALYSIS REPORT ATTACHED THE U31 DEVICE WAS A RANDOM FAILURE WHICH MADE IT IMPOSSIBLE TO DETERMINE THE CAUSE. REF FR 8309 COPY ATTACHED. NO OVERSTRESS OCCURRED</i>					
31. CONTINUATION SHEET USED <input type="checkbox"/>					
32. DOCUMENT IMPLEMENTING CORRECTIVE ACTION <i>FAILURE ANALYST REPORT #9242 (COPY ATTACHED)</i>					
33. FRB CLOSURE <i>[Signature]</i> <i>11/6/82</i>					
34. BASIC CAUSE OF VERIFIED FAILURE <input type="checkbox"/> DESIGN <input type="checkbox"/> ENVIRONMENTAL <input checked="" type="checkbox"/> DEFECTIVE PARTS <input type="checkbox"/> TEST EQUIPMENT <input type="checkbox"/> TEST PROCEDURE <input type="checkbox"/> TEST SET-UP <input type="checkbox"/> MFG. PROCEDURE <input checked="" type="checkbox"/> ASSY/FAB ERROR <input type="checkbox"/> WORKMANSHIP <input type="checkbox"/> WIRING ERROR <input type="checkbox"/> ROUGH HANDLING <input type="checkbox"/> WEAR-OUT		35. UNKNOWN DEFECT CODE			
35. FAILURE TYPE <input checked="" type="checkbox"/> PRIMARY <input type="checkbox"/> INDUCED <input type="checkbox"/> UNKNOWN <input type="checkbox"/> NO FAILURE		36. FAILURE CLASSIFICATION <input checked="" type="checkbox"/> CRITICAL <input type="checkbox"/> MAJOR <input type="checkbox"/> MINOR <input type="checkbox"/> SAFETY			
37. RESPONSIBLE ENGINEER <i>J.A. Baruch</i>		ORG <i>22-13</i>	DATE <i>11-17-81</i>	38. SPACECRAFT SYSTEM ENGINEER <i>[Signature]</i>	
				ORG <i>22-91</i>	DATE <i>6 JAN 82</i>
39. RELIABILITY <i>[Signature]</i>		ORG <i>51-41</i>	DATE <i>1-6-81</i>	40. CUSTOMER OR SUPPLIER <i>[Signature]</i> <i>1/7/82</i>	

30/11/81
ORIGINAL PAGE IS
OF POOR QUALITY



FAILURE ANALYSIS
REPORT

58456

FAR No. 9242
Program T.M.
Page 1 of 2

DATE OF RECEIPT <u>12-9-81</u>	TSD PROJECT ENGINEER <u>W. Gettys</u>
REQUESTER <u>F. Carle</u>	PHONE _____ BLDG./MS <u>STD/C346</u>
ORG <u>44-29</u> PHONE <u>80248</u> BLDG./MS <u>S13/D329</u>	GLA/CMER <u>40838</u>
REA _____ PHONE _____	
COMPONENT <u>I.C.</u>	FAILURE REFERENCE <u>FA81-281/FR 58456</u>
FUNCTION/TYPE <u>8-Bit Shift Register</u>	DATE OF FAILURE <u>11-11-81</u>
GENERIC P/N <u>54L165</u>	FAILURE LEVEL <u>Assembly</u>
HUGHES P/N <u>909940-1</u>	LOT NUMBER _____
MFG. <u>National</u> P/N <u>RD30371</u>	CIRCUIT SYMBOL <u>U31</u>
DATE CODE <u>7827</u> S/N <u>1092</u>	MODULE <u>50948</u> S/N <u>201</u>

ABSTRACT

The reported failure, wrong output once in 6×10^6 cycles and again once in 1.5×10^6 cycles, was not confirmed. The device was found to be within all specified d.c. parametric limits. The rareness of the failure reported made it impossible to determine its cause.

TECHNICAL COMMENTARY		<u>K2127</u>		<u>12-22-81</u>
<input checked="" type="checkbox"/> NOT REQUIRED	M. J. Ditz	JOURNAL	O. E. Limbacher	DATE
<input type="checkbox"/> APPENDED	FAILURE ANALYST		APPROVAL	

ORIGINAL PAGE IS
OF POOR QUALITY

FAR. NO. 9242
PAGE 2 of 2

SB 456

Reported Failure:

"Word G failed once during data cycling at 0°C (6 X 10⁶ cycles). Primary word G is X 'BD' [hexadecimal coded output], should be X 'AD'.

Background Information:

"Note FR 8309 and subsequent ambient testing delt with U31 pin 7 (\bar{Q} output) short to ground by solder splash across traces, its removal, and proper functioning. The failure of 1 of 8 bits in word G once in 6 X 10⁶ cycles at 0°C requires removal and replacement of U31."

Additional Information:

The device was retested the next day (after the one failure in (6 X 10⁶ cycles) for 1.5 X 10⁶ cycles. The same failure mode (output X 'BD' instead of X 'AD') was noted again once in the 1.5 X 10⁶ cycles.

Outline of Analysis:

1. External Visual Examination
2. Electrical Testing
3. Internal Examination

Results of Analysis:

1. External Visual Examination.
 - a) Markings: (National Logo) 7827
RD30371
-1092
 - b) Case Examination:

The leads were formed and solder tipped and there was orange transparent tape on the bottom of the package. No anomalies were noted externally.

2. Electrical Testing.

The device was tested for d.c. parameters on the Tektronix S-3260 automated I.C. tester per the 90940 specification at +125°C, +25°C, 0°C and -55°C. It was found to be within the specified limits for all of the parameters tested.

3. Internal Examination.

The device was opened and examined internally. No anomalies were noted.

Conclusion:

The reported failure was improper output once in 6 X 10⁶ cycles and again once in 1.5 X 10⁶ cycles. The device was tested for all specified d.c. parameters and passed. No anomalies were noted externally or internally. The extreme rareness of the observed failure made it impossible to determine its cause.

HUGHES

HUGHES AIRCRAFT COMPANY
SPACE AND COMMUNICATIONS GROUP
EL SEGUNDO, CALIFORNIA

SPACE AND COMMUNICATIONS GROUP
FAILURE REPORT

ORIGINAL PAGE IS
OF POOR QUALITY
S 8460

ORIGINATOR	1. PROGRAM NAME AND NUMBER TM		2. GLA		3. MODEL FLT		4. TIME OBSERVED 6:00		5. DATE OBSERVED NO 10 DA 2 YR 81		
	6. HARDWARE LEVEL WHEN FAILURE WAS OBSERVED		<input type="checkbox"/> SPACECRAFT <input type="checkbox"/> SYSTEM		<input type="checkbox"/> SUBSYSTEM <input type="checkbox"/> UNIT		<input type="checkbox"/> ASSEMBLY <input checked="" type="checkbox"/> SUBASSEMBLY		<input type="checkbox"/> MODULE <input type="checkbox"/> MICAM		
	EQUIPMENT IDENTIFICATION:		NAME		PART NUMBER		S/N		MANUFACTURER		
	7. SUBSYSTEM										
	8. UNIT Electronia Module				52347						
	9. <input type="checkbox"/> ASSEMBLY <input checked="" type="checkbox"/> SUBASSEMBLY		Auxiliary Circuit Board		52797						
	10. <input type="checkbox"/> MODULE <input type="checkbox"/> MICAM <input type="checkbox"/> CARD										
	11. OTHER										
	12. TEST WHEN FAILURE WAS OBSERVED		<input type="checkbox"/> DEVELOPMENT <input type="checkbox"/> IN-PROCESS		<input type="checkbox"/> QUALIFICATION <input type="checkbox"/> ACCEPTANCE		<input type="checkbox"/> INTEGRATION <input type="checkbox"/> SYSTEM		<input type="checkbox"/> LAUNCH OPERATIONS		
	13. ENVIRONMENT WHEN FAILURE WAS OBSERVED		<input checked="" type="checkbox"/> AMBIENT <input type="checkbox"/> EMC/RR		<input type="checkbox"/> RADIATION <input type="checkbox"/> VIBRATION		<input type="checkbox"/> TEMP _____ ° AXIS FOR _____ MEN TYPE _____		<input type="checkbox"/> THERMAL VAC _____ HRS AT _____ <input type="checkbox"/> OTHER _____		
	14. DESCRIPTION OF FAILURE		Signal was inverted at pins 177, 178, 175, 176, 179, 180, 173, and 174. No signal was present at pins 77, 78, 79, 80, 75, 76, 81, 82								
	15. TEST PROCEDURE 16596		PARA 5.3		10. ORIGINATOR Joe Kleeberg		ORG 22-13		DATE 10/3/81		17. CONTINUATION SHEET USED <input type="checkbox"/>
18. VERIFICATION AND FAILURE ANALYSIS		INTEGRATED CIRCUITS AR1 and AR2 assembled and installed upside down. No overstress to other board components. Schematic 11/1/81. STRESS ANALYSIS DOCUMENTED DN EDC H5536-7742 (COPY ATTACHED) 11/3/81									
19. FAILED ITEM NAME AND PART NUMBER		AR1, AR2 90992-1									
20. <input checked="" type="checkbox"/> FOLLOWING REWORK/RETEST REQUIRED <input type="checkbox"/> REWORK/RETEST NOT REQUIRED BECAUSE		Remove and Replace correctly AR1 and AR2. Perform test procedure 16596 Rev A para 5.2 and 5.3									
21. AUTHORIZATION		J.A. Barach		ORG 22-13		DATE 10-6-81		22. CONTINUATION SHEET USED <input type="checkbox"/>		24.	
23. REWORK/RETEST ACTION TAKEN		AR1 and AR2 removed and replaced per D/P. Retested per test procedure 16596 Rev A para 5.2 and 5.3.									
25. QA RETEST											
26. LIST ALL PARTS REPLACED		PART NUMBER		CXT SYM		PART LOT NUMBER		DATE CODE		MANUFACTURER	
90992-1		AR1, AR2								PROBABLE DEFECT NONE - INSTALLED POWERED INCORRECTLY	
27. REWORK BY L. TORRES		ORG 22-74		DATE 10-5-81		28. RETESTED BY Joe Kleeberg		ORG 22-73		DATE 10-5-81	
29. CONTINUATION SHEET USED <input type="checkbox"/>		30. CAUSE AND CORRECTIVE ACTION		AR1 and AR2 installed incorrectly. More cautious initial visual check would identify problem prior to powering board. MEETINGS WERE HELD WITH MFG AND QA IMPORTANT TO RESOLVE THIS PROBLEM TO PREVENT RECURRENTS							
31. CONTINUATION SHEET USED <input type="checkbox"/>		32. DOCUMENT IMPLEMENTING CORRECTIVE ACTION									
33. BASIC CAUSE OF VERIFIED FAILURE		<input type="checkbox"/> DESIGN <input type="checkbox"/> ENVIRONMENTAL <input type="checkbox"/> DEFECTIVE PARTS		<input type="checkbox"/> TEST EQUIPMENT <input type="checkbox"/> TEST PROCEDURE <input type="checkbox"/> TEST SET-UP		<input type="checkbox"/> MFG. PROCEDURE <input type="checkbox"/> ASSY/FAB ERROR <input type="checkbox"/> WORKMANSHIP		<input type="checkbox"/> WIRING ERROR <input type="checkbox"/> ROUGH HANDLING <input type="checkbox"/> WEAR-OUT		CAUSE UNKNOWN DEFECT CODE	
34. FAILURE TYPE		<input type="checkbox"/> PRIMARY <input type="checkbox"/> NOUCED		<input type="checkbox"/> UNKNOWN <input type="checkbox"/> NO FAILURE		35. FAILURE CLASSIFICATION <input type="checkbox"/> SPACECRAFT SYSTEM ENGINEER <input type="checkbox"/> CRITICAL <input type="checkbox"/> MAJOR		<input type="checkbox"/> MINOR <input type="checkbox"/> SAFETY			
36. RESPONSIBLE ENGINEER J.A. Barach		ORG 22-73		DATE 10-7-81		37. SPACECRAFT SYSTEM ENGINEER 		ORG 22-65		DATE 01/10/83	
38. RELIABILITY 		ORG 22-74		DATE 11-3-81		39. SUPPLIER OR SUPPLIER 		ORG 22-65		DATE 12/2/81	

HUGHES

HUGHES AIRCRAFT COMPANY
SPACE AND COMMUNICATIONS GROUP
EL SEGUNDO, CALIFORNIA

SPACE AND COMMUNICATIONS GROUP

FAILURE REPORT

ORIGINAL PAGE IS
OF POOR QUALITY

S 8464

1 PROGRAM NAME AND NUMBER TM PL 1162		2 GLA	3 MODEL F1	4 TIME OBSERVED 1615	5 DATE OBSERVED MO 6 DA 27 YR 82
6 HAZARDOUS LEVEL WHEN FAILURE WAS OBSERVED <input checked="" type="checkbox"/> SPACECRAFT <input type="checkbox"/> SUBSYSTEM <input type="checkbox"/> ASSEMBLY <input type="checkbox"/> MODULE <input type="checkbox"/> CARD <input checked="" type="checkbox"/> SYSTEM <input type="checkbox"/> UNIT <input type="checkbox"/> SUBASSEMBLY <input type="checkbox"/> WICAM <input type="checkbox"/> PART					
EQUIPMENT IDENTIFICATION					
7 SUBSYSTEM		NAME	PART NUMBER	S/N	MANUFACTURER
8 UNIT		POSTAMP BOARD			
9 <input type="checkbox"/> ASSEMBLY <input checked="" type="checkbox"/> SUBASSEMBLY		BAND 1		50904-1	101
10 <input type="checkbox"/> MODULE <input type="checkbox"/> WICAM <input checked="" type="checkbox"/> CARD					
11 OTHER					
12 TEST WHEN FAILURE WAS OBSERVED <input type="checkbox"/> DEVELOPMENT <input type="checkbox"/> QUALIFICATION <input checked="" type="checkbox"/> INTEGRATION <input type="checkbox"/> LAUNCH OPERATIONS <input type="checkbox"/> IN-PROCESS <input type="checkbox"/> ACCEPTANCE <input type="checkbox"/> SYSTEM					
13 ENVIRONMENT WHEN FAILURE WAS OBSERVED <input checked="" type="checkbox"/> AMBIENT <input type="checkbox"/> RADIATION <input type="checkbox"/> TEMP <input type="checkbox"/> THERMAL VAC <input type="checkbox"/> VRS AT <input type="checkbox"/> EMC/RFI <input type="checkbox"/> VIBRATION <input type="checkbox"/> AXIS FOR <input type="checkbox"/> MIN <input type="checkbox"/> PE <input type="checkbox"/> OTHER					
14 DESCRIPTION OF FAILURE R1 offset out of spec. Should be -4.00 ± 0.20V DC. Avg. Ch: 3 4 6 10 14 15 V: -4.26V -4.46 -4.34 -7.17 -4.23 -4.55.					
15 TEST PROCEDURE 32015		16 PARA 512	18 ORIGINATOR Current	19 ORG 22-13	17 DATE 6-28-82
19 VERIFICATION AND FAILURE ANALYSIS No overstress was induced. No parts failed. All components were within Spec. limits. Unit was in test configuration.					
20 <input checked="" type="checkbox"/> FOLLOWING REWORK/RETEST REQUIRED <input type="checkbox"/> REWORK/RETEST NOT REQUIRED BECAUSE Repeat Resistor selection process and retest.					
21 AUTHORIZATION L. J. ... for N. Current					
22 REWORK/RETEST ACTION TAKEN New select resistors were installed. Retested successfully. ON 6-28-82		23 CONTINUATION SHEET USED		24 QA REWORK	
25 LIST ALL PARTS REPLACED		CAT SYM	PART LOT NUMBER	DATE CODE	MANUFACTURER
908600-256		R-18			None
908600-88		R-98			"
908600-253		R-24			"
27 REWORK BY L.C. TAMES (GRD)		28 ORG 22-13	29 DATE 6/29/82	30 RETESTED BY L. J. ... for M. ...	31 ORG 22-13
32 CAUSE AND CORRECTIVE ACTION INITIAL RESISTOR SELECTION ALLOWED A BUILDUP OF TOLERANCE TO DRIVE OFFSETS OUT OF SPEC FOR CH 3, 4, 6, 14, & 15. CH 10 WAS APPARENTLY A POOR CHOICE OF INITIAL RESISTOR, ALTHOUGH STILL WITHIN RANGE. NEW VALUES RESELECTED FOR R 18, 98, 24, 104, 26, 106, 27, 107, 29, 109, 31, AND 111.		33 CONTINUATION SHEET USED			
34 BASIC CAUSE OF VERIFIED FAILURE <input type="checkbox"/> DESIGN <input type="checkbox"/> ENVIRONMENTAL <input type="checkbox"/> DEFECTIVE PARTS <input type="checkbox"/> TEST EQUIPMENT <input type="checkbox"/> TEST PROCEDURE <input type="checkbox"/> TEST SET-UP <input type="checkbox"/> MFG. PROCEDURE <input type="checkbox"/> ASSY/FAB ERROR <input type="checkbox"/> WORKMANSHIP <input type="checkbox"/> WIRING ERROR <input type="checkbox"/> ROUGH HANDLING <input type="checkbox"/> WEAR OUT <input type="checkbox"/> UNKNOWN		35 DEFECT CODE			
36 FAILURE TYPE <input type="checkbox"/> PRIMARY <input type="checkbox"/> INDUCED <input checked="" type="checkbox"/> UNKNOWN <input type="checkbox"/> NO FAILURE		37 RESPONSIBLE ENGINEER L. J. ...		38 FAILURE CLASSIFICATION <input type="checkbox"/> CRITICAL <input type="checkbox"/> MAJOR <input checked="" type="checkbox"/> MINOR <input type="checkbox"/> SAFETY	
39 RELIABILITY G. ...		40 ORG 31 41	41 DATE 6-29-82	42 SIGNATURE L. J. ... 6/30/82	

58464

REF. F/R # 8464
RE-SELECTS. operation 300 of Supp 15 (58904-1)

TEST DATA RECORD

DATE 6/28/82

ORIGINAL PAGE IS
OF POOR QUALITY

SCANNER 51065 S/N003 (50904-1 p/101)

4.2 SELECT RESISTOR VALUES

Band	1	2	3	4
R 17				
R 97				
R 18 - 256	22.6 K			
R 98 - 88	402 Ω			
R 19				
R 99				
R 20				
R100				
R 21				
R101				
R 22				
R102				
R 23				
R103				
R 24 - 253	21.0 K			
R104 - 88	402 Ω			
R 25				
R105				
R 26 - 256	22.6 K			
R106 - 30	100 Ω			
R 27 - 258	23.7 K			
R107 - 30	100 Ω			
R 28				
R108				
R 29 - 251	20.0 K			
R109 - 97	499 Ω			
R 30				
R110				
R 31 - 255	22.1 K			
R111 - 3076	301 Ω			

Stonaker
6-28-82

C. P. Lane
06-28-82
06-28-82

SIZE A	CODE IDENT NO. 11323	NUMBER 17010
SCALE	REV A	SHEET 4 of 5

58464

ORIGINAL PAGE IS
OF POOR QUALITY

4.2 Offset Voltage Measurements after Select Resistors
Installed.

Band	1	2	3	4
Ch				
1	-			
2	-			
3	-4.16			
4	-4.01			
5				
6	-3.99			
7	-			
8	-			
9	-			
10	-3.99			
11	-			
12	-			
13	-			
14	-4.12			
15	-4.06			
16	-			

Technician: CPK 06-28-82 Shawhan Date: 6-28-82
 QA: [Signature] Date: 6-28-82 52
 REA: Shawhan Date: 6-28-82

REF IR#8464
 Test Verification Supp#15 operation #900 52

SIZE A	CODE IDENT NO. 11323	NUMBER 17010
SCALE	REV A	SHEET 5 OF 5

HUGHES

HUGHES AIRCRAFT COMPANY
SPACE AND COMMUNICATIONS GROUP
EL SEGUNDO, CALIFORNIA

SPACE AND COMMUNICATIONS GROUP

**FAILURE REPORT
CONTINUATION SHEET**

FR SERIAL NO. S 8464
CONTINUATION SHEET LETTER A

*LABEL FIRST CONTINUATION SHEET USED 'A', SECOND 'B', AND SO ON

IDENTIFY ENTRIES BY REFERENCING FR BLOCK NUMBER IN COLUMN, DATE EACH ENTRY.

ADDITIONAL FR CONTINUATION SHEET(S) USED <input type="checkbox"/>

26	Fr. No.	CIRCUIT SYMBOL	PROBABLE DEFECT
	908600-88	R 104	None
	908600-256	R 26	"
	908600-30	R 106	"
	908600-258	R 27	"
	908600-30	R 107	"
	908600-251	R 29	"
	908600-97	R 109	"
	908600-255	R 31	"
	908600-111	R-76	"

ORIGINAL PAGE IS
OF POOR QUALITY

ORIGINAL PAGE IS
OF POOR QUALITY

58464

TEST DATA RECORD

DATE 6/23/82 (1) & MS
SCANNER F1 BAND 1

NOTE: VALUES ARE FROM
LISTS 52732-22 (R17-R32)
& 52732-85 (R97-R112)

4.2 SELECT RESISTOR VALUES

	Band (1)	908 #	VALUE	DESIRED VALUE (k Ω)	ACHIEVED TOTAL (k Ω)
R 17	908600	-252	20.5K	20.9K	20902
R 97		-88	402		
R 18		-256	22.6K	23.1	23099
R 98		-97	499		
R 19		-258	23.7K	23.8	23900
R 99		-30	100		
R 20		-250	19.6K	19.8	19810
R100		-59	200		
R 21		-251	20.0K	20.1	20100
R101		-30	100		
R 22		-254	21.5K	21.5	21500
R102		SHORT	0		
R 23		-258	23.7K	24.2	24199
R103		-97	499		
R 24		-254	21.5K	21.5	215
R104		SHORT	0		
R 25		-258	23.7K	24.0	24001
R105		-76	301		
R 26		-256	22.6K	22.7	22700
R106		-30	100		
R 27		-258	23.7K	23.8	23500
R107		-30	100		
R 28		-256	22.6K	22.7	22700
R108		-30	100		
R 29		-254	21.5K	21.8	21801
R109		-76	301		
R 30		-253	21.0K	21.1	21100
R110		-30	100		
R 31		-255	22.1K	22.5	22512
R111		-88	402		
R 32		-253	21.0K	21.1	21100
R 112		-30	100		

OK [Signature]

SIZE A	CODE IDENT NO 11323	NUMBER 17010
SCALE	REV A	SHEET 4 OF 5

58464

REF. F/R # 8464
RE-SUBJECTS... operation 300 of Supp 15 (50904-1)
TEST DATA RECORD

ORIGINAL PAGE IS
OF POOR QUALITY

DATE 6/28/82

SCANNER 51065 S/N 003 (50904-1 sh 101)

4.2 SELECT RESISTOR VALUES

Band	1	2	3	4
R 17				
R 97				
R 18 - 256	22.6 K			
R 98 - 88	402 Ω			
R 19				
R 99				
R 20				
R100				
R 21				
R101				
R 22				
R102				
R 23				
R103				
R 24 - 253	21.0 K			
R104 - 98	402 Ω			
R 25				
R105				
R 26 - 256	22.6 K			
R106 - 30	100 Ω			
R 27 - 258	23.7 K			
R107 - 30	100 Ω			
R 28				
R108				
R 29 - 251	20.0 K			
R109 - 97	499 Ω			
R 30				
R110				
R 31 - 255	22.1 K			
R 32 - 2076	301 Ω			

Stonaker
6-28-82

C. P. Lane
06-28-82
M. [Signature]
06-28-82

SIZE A	CODE IDENT NO. 11323	NUMBER 17010
SCALE	REV A	SHEET 4 of 5

58464

ORIGINAL PAGE IS
OF POOR QUALITY

4.2 Offset Voltage Measurements after Select Resistors
Installed.

Band	1	2	3	4
Ch				
1	-			
2	-			
3	-4.16			
4	-4.01			
5				
6	-3.99			
7	-			
8	-			
9	-			
10	-3.99			
11	-			
12	-			
13	-			
14	-4.12			
15	-4.06			
16	-			

Technician CPH 06-28-82 Shawhan Date 6-28-82
 QA [Signature] Date 6-28-82 52
 REA Shawhan Date 6-28-82

REF FR#8464
 TEST Verification Supp# 15 operation #900 52

SIZE A	CODE IDENT NO. 11323	NUMBER 17010
SCALE	REV A	SHEET 5 OF 5

2.13

ORIGINAL PAGE IS
OF POOR QUALITY

SECTION 2.13
CABLE HARNESS

2.13.1

ORIGINAL PAGE IS
OF POOR QUALITY

2.13.1 Cable Harness

2.13.1.1

No performance data was taken at the subsystem level on this
subsystem.

2.13.2

ORIGINAL PAGE IS
OF POOR QUALITY

2.13.2

Acceptance Data

2.13.2.1

ORIGINAL PAGE IS
OF POOR QUALITY

2.13.2.1
Configuration Lists

AS-BUILT CONFIGURATION LIST

R=RECORD CHANGE

CABLE ROUTING ASSY
52348(3569647)S/N005

IND LVL	PART NO.	NOMENCLATURE	CURRENT REVISION	ACCEPT. REVISION	AS-BUILT REVISION	SERIAL NUMBER
01	52348	CABLE ROUTING ASSY	F 3844A	F 3844A	F 3844A	005
01	3569647	WIRING HARNESS INSTALLATION	C 27724 70534 70538 70543 70550 70561	C 27724 70534 70538 70543 70550 70561	C 27724 70534 70538 70543 70550 70561	005
02	3569641	WIRING HARNESS	E 27722 27723 D042 REV1 D057 D060 D062 D063	E 27722 27723 D042 REV1 D057 D060 D062 D063	E 27722 27723 D042 REV1 D057 D060 D062 D063	005
03	DP50326	DPS ASSY OF AMP CONNECTORS	B SCN 1 2 3 4	B SCN 1 2 3 4	B SCN 1 2 3 4	
02	3569642	WIRE, JUMPER	9494	9494	9494	
02	3569643	CONNECTOR	D064	D064	D064	

ORIGINAL PAGE IS
OF POOR QUALITY

52348(3569647) S/N005

IND LVL	PART NO.	NOMENCLATURE	CURRENT REVISION	ACCEPT. REVISION	AS-BUILT REVISION	SERIAL NUMBER
02	3569646	WIRING DIAGRAM	B 27727 27732 R70552 70557 70564 70567	B 27727 27732 70557 70564 70567	B 27727 27732 70552 70557 70564 70567	
02	3569649	RF BACKSHELL	-	-	-	
02	3449442	EYELET	-	-	-	
02	ICL3569638-1	INTERCONNECT LIST	A 27721 27726 27735 27737	A 27721 27726 27735 27737	A 27721 27726 27735 27737	
02	TP32015-036-1	TP OF ELECTRICAL WIRING HARNESS	A SCN 1 27738	A SCN 1 27738	A SCN 1 27738	
02	16232	CABLE, SHIELDED	A	A		
02	52349	STRUCTURE ASSY-ELECT.	C 1987A	C 1987A	C 1987A	
02	52361	GASKET, CONNECTOR	A 8151	A 8151	A 8151	
02	52365	PLATE, CONNECTOR-RIU	A 1961A 3275A	A 1961A 3275A	A 1961A 3275A	
02	52366	PLATE CONNECTOR	A 8065	A 8065	A 8065	
02	52753	THERMISTOR BLOCK	D 3794A	D 3794A	D 3794A	301

ORIGINAL PAGE IS
OF POOR QUALITY

52348(3569647) S/N005

IND LVL	PART NO.	NOMENCLATURE	CURRENT REVISION	ACCEP. REVISION	AS-BUILT REVISION	SERIAL NUMBER
02	52839	CONNECTOR, RECEPTACLE	D 2087A 2748A	D 2087A 2748A	D 2087A 2748A	
02	52930	CAP & RELAY BD ASSY	E 2977A 3807A	E 2977A 3807A	E 2977A 3807A	202
02	53160	TERMINAL BD ASSY	B	B	B	201
02	53653	PLATE, FILTER MOUNT	A	A	A	
02	53710	TERMINAL BD POWER	C 3255A	C 3255A	C 3255A	
02	53711	PLATE, POWER SUPPLY	A	A	A	
02	53927	GROMMET, PLASTIC EDGE	A	A	A	
02	52923	TERMINAL BD ASSY	B 9369	B 9369	B 9369	201
02	54012	HEATER ASSY	A 2398A	A 2398A	A 2398A	201
02	54185	RETAINER, CABLE	A 1886A	A 1886A	A 1886A	
02	54233-1	SW THERMOSTAT ASSY	A 3504A	A 3504A	A 3504A	202
02	54257	+/-2 SMA CONTROL RES	A 2925A	A 2925A	A 2925A	203
02	653307	TERMINAL LUG, SOLDER	-	-	-	
02	16268	PS FOR SURFACE MOUNTED COMPONENTS	A 2216A 2940A 3080A 3283A	A 2216A 2940A 3080A 3283A	A 2216A 2940A 3080A 3283A	

ORIGINAL PAGE IS
OF POOR QUALITY


P. A. GROVES CDMO



Quality Assurance

ORIGINAL PAGE IS
OF POOR QUALITY

HARNES

P/N 52348

FLIGHT

Failure Reports Number

Open	Closed

Deviation

Waivers

Deviation	Waivers

ORIGINAL PAGE IS
OF POOR QUALITY

HARNES

P/N 52348

FLIGHT
Failure Report
No.

PROTOFLIGHT
Failure Report
No.

ENGINEER
Failure Report
No.

FLIGHT Failure Report No.		PROTOFLIGHT Failure Report No.		ENGINEER Failure Report No.	
Open	Closed	Open	Closed	Open	Closed
			F3022 F3023 F3024 F5190 F8022		

ORIGINAL PAGE IS
OF POOR QUALITY

.Listing of Liens

There were no liens recorded against the
Harness Assembly.

**END
DATE
FILMED**

AUG 5 1983